


CARDINAL SURVEYS
 PLAT OF SURVEY
 PREPARED FOR CHARTER RENTY

507421

6473272

06-24-048-000

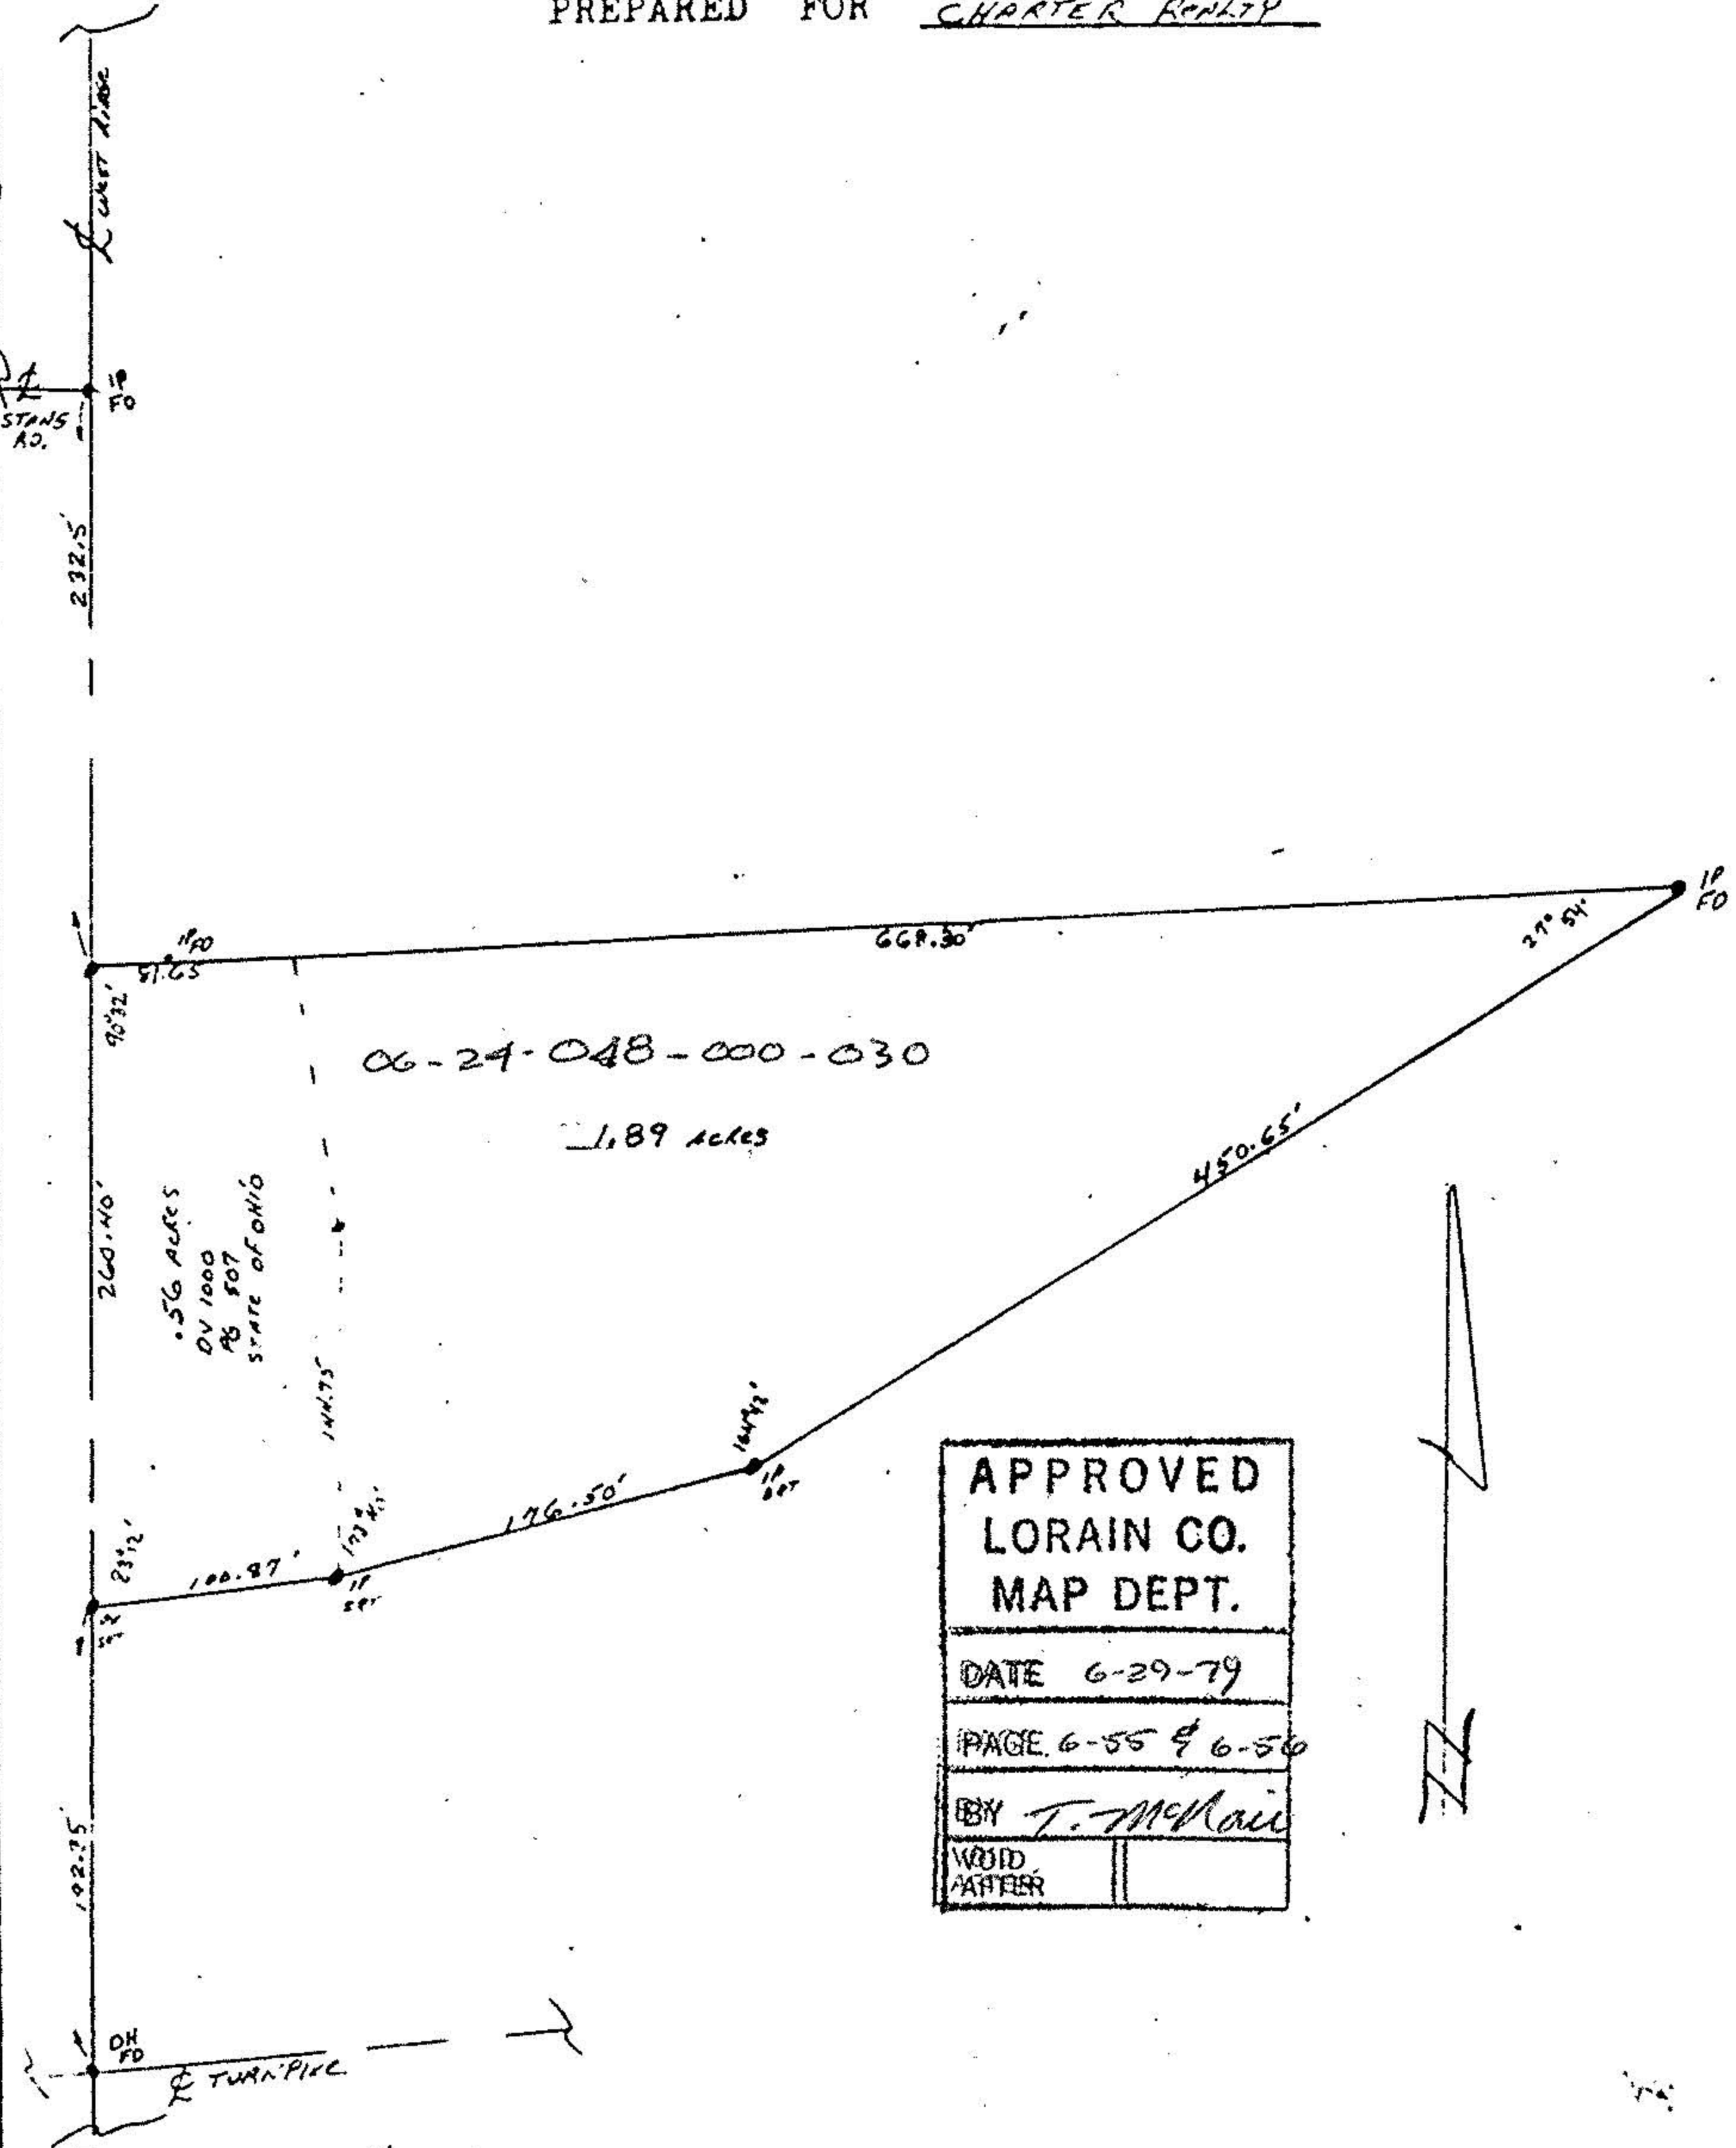


06-24-048-000-030

1.89 ACRES

56 ACRES
 DV 1000
 AS 507
 STATE OF OHIO

APPROVED
 LORAIN CO.
 MAP DEPT.
 DATE 6-29-79
 PAGE 6-55 & 6-56
 BY T. McNeil
 WOOD
 WATER

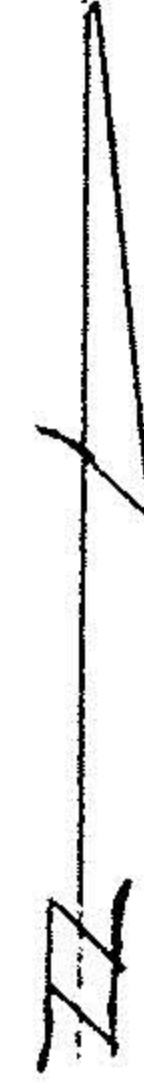

DATE: MAY 20TH 1979

SCALE: 1" = 100'

6-55
 6-56