


REV
DESC

#22287-D

APPROVED
LORAIN CO.
MAP DEPT.
DATE 10-31-97
PAGE 6-100
BY T. McMain
VOID AFTER 22287-D


5/19/97
OR 1485/957
P. Vol 4 Pg 34
L.L. Sears Addn

OL 81
OL 82

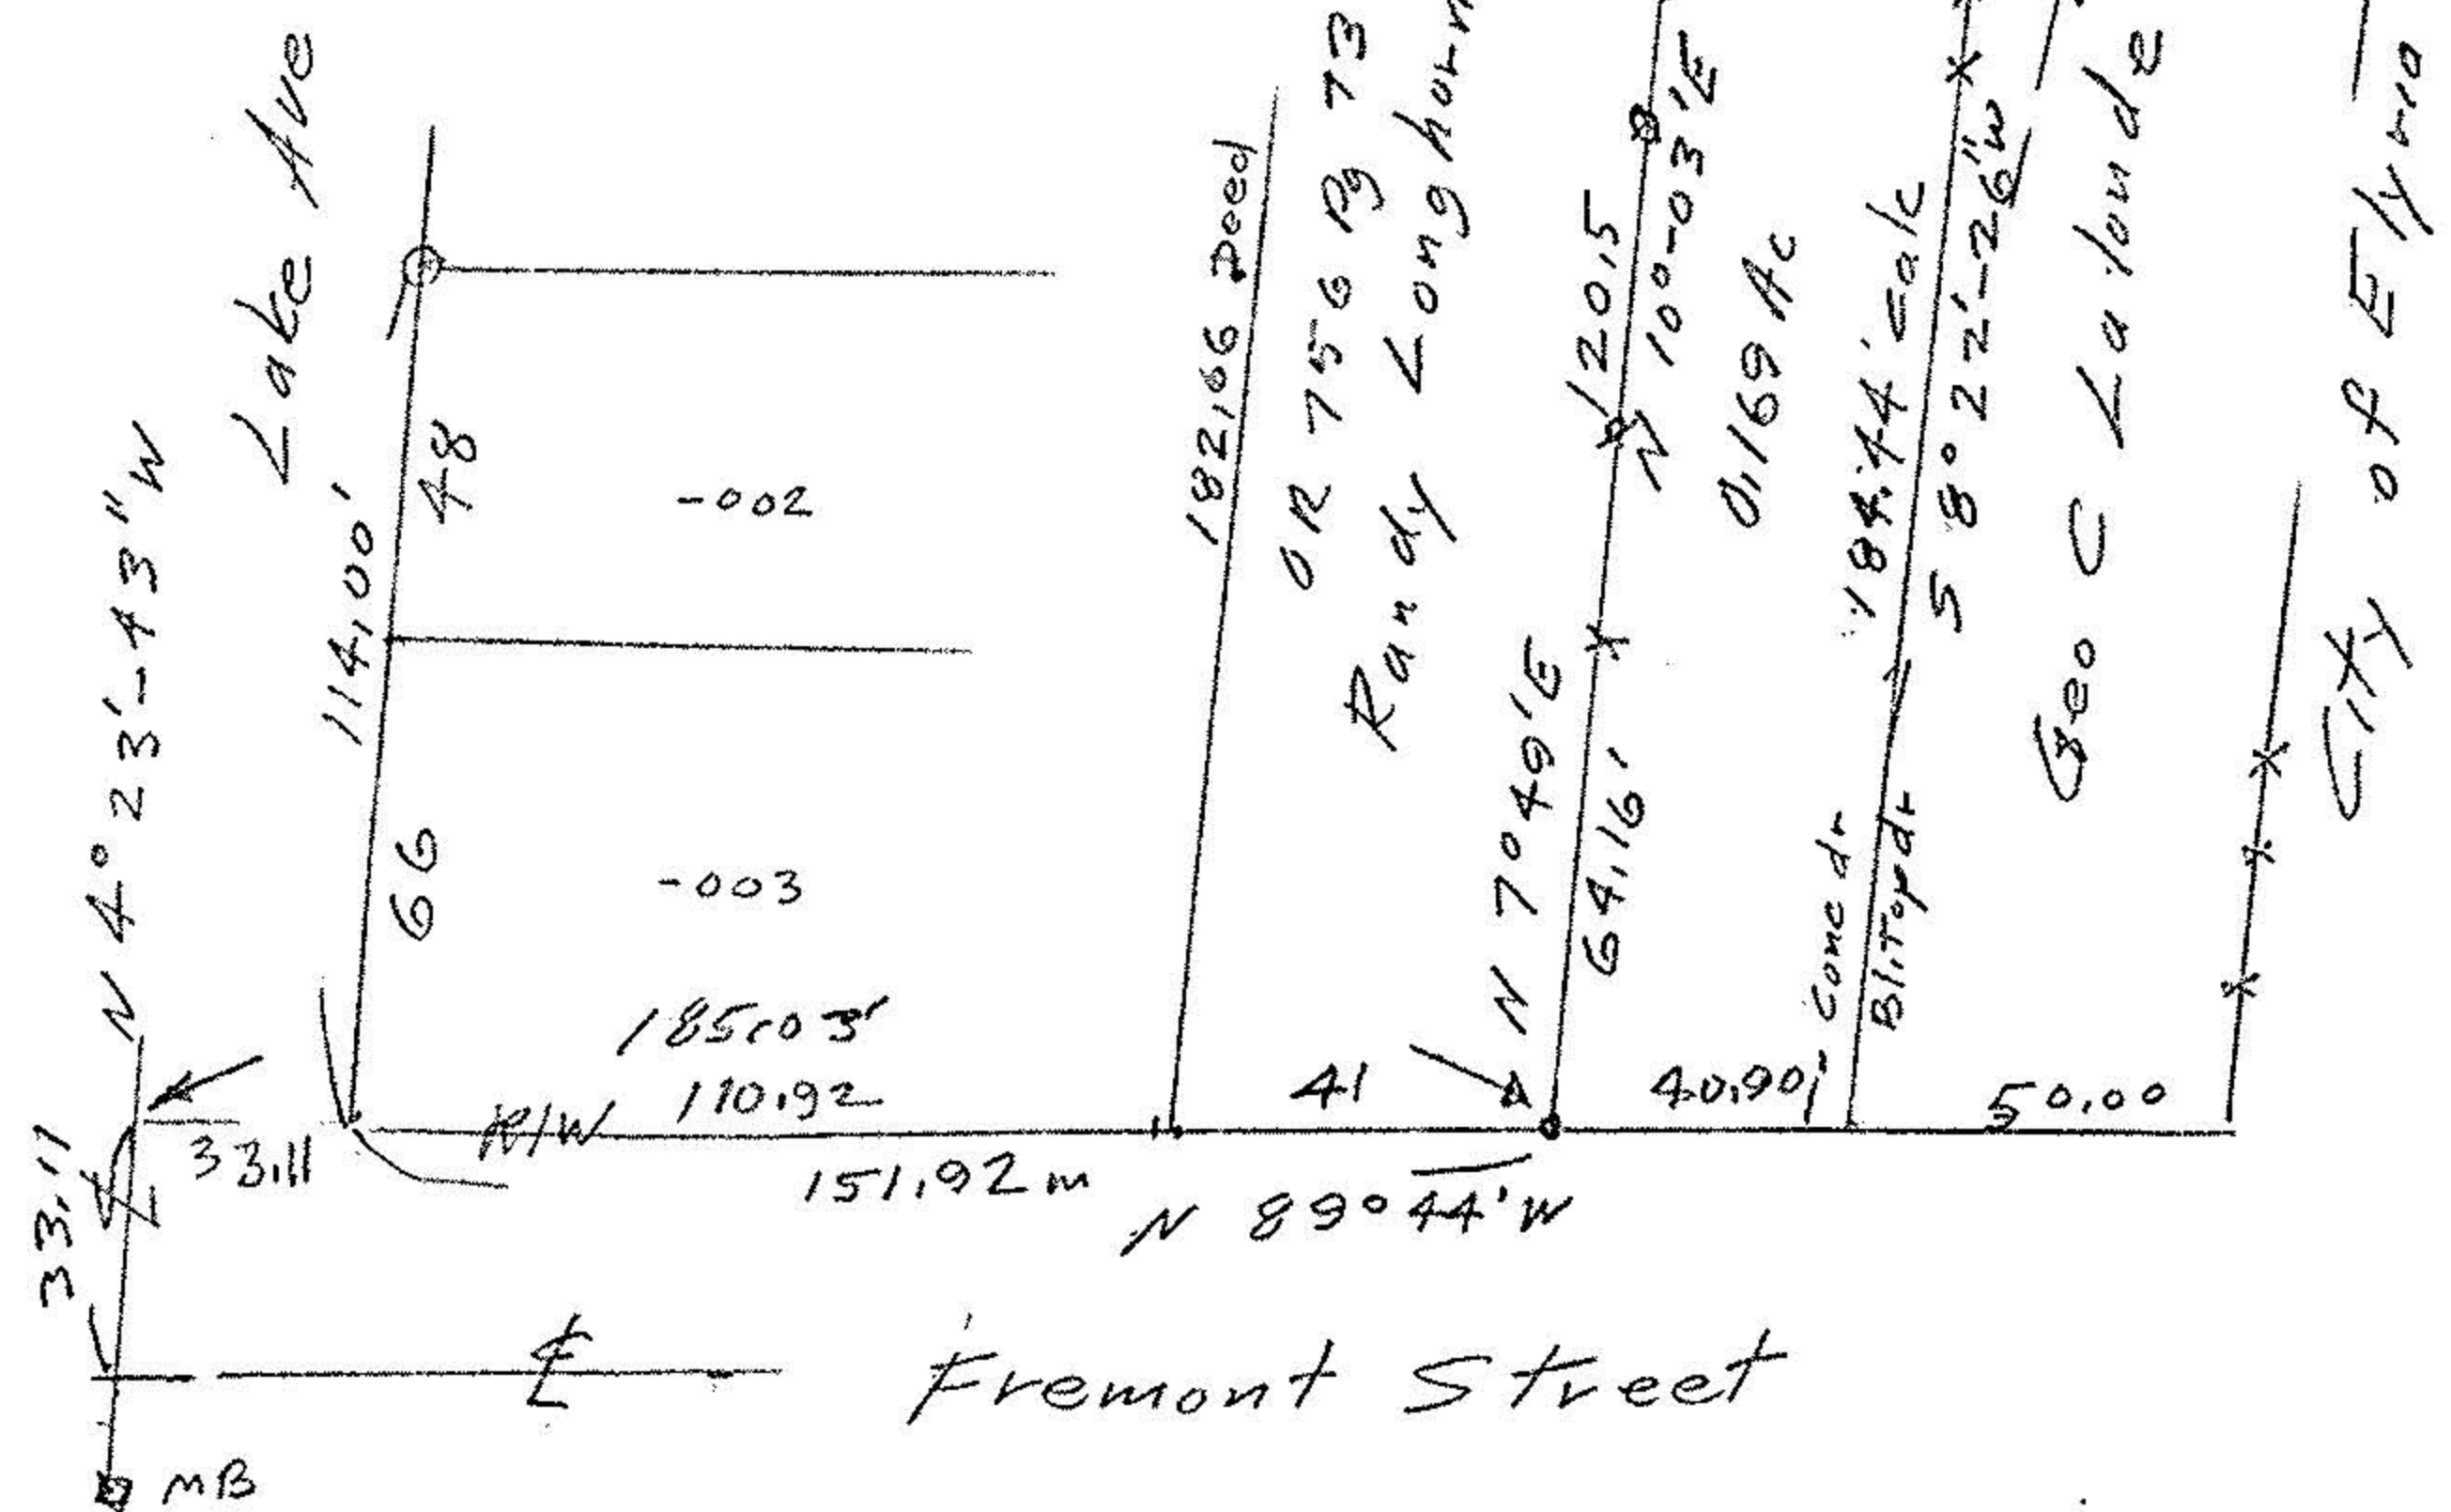

Survey for
Michael Hylton
PPN 06-24-082-000-005
Original, Elyria Township Lot 82
West of Black River
Lorain County OHIO
Scale 1" = 50 Oct 1997

- Monument Box
- Iron pins fd
- Iron pins set

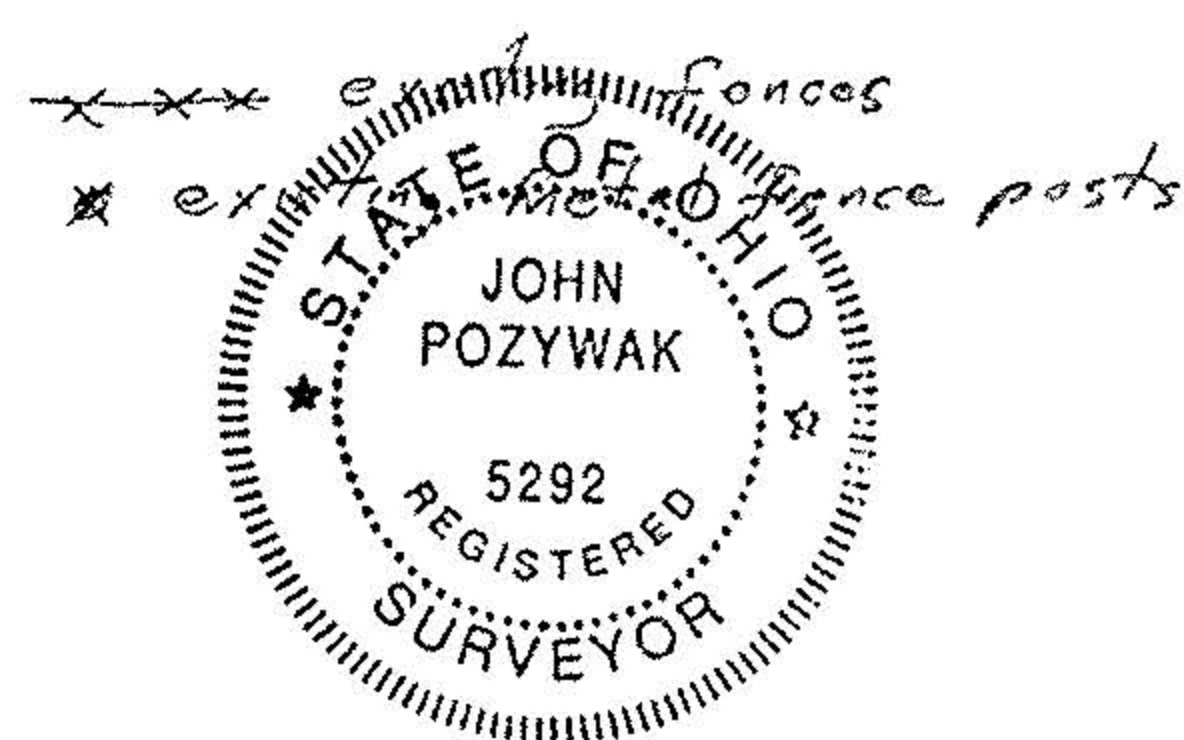

John Pozywak
Reg Surveyor 5292