


P.V. 6 Pg 41

Geo H Ely Atty West River St A114

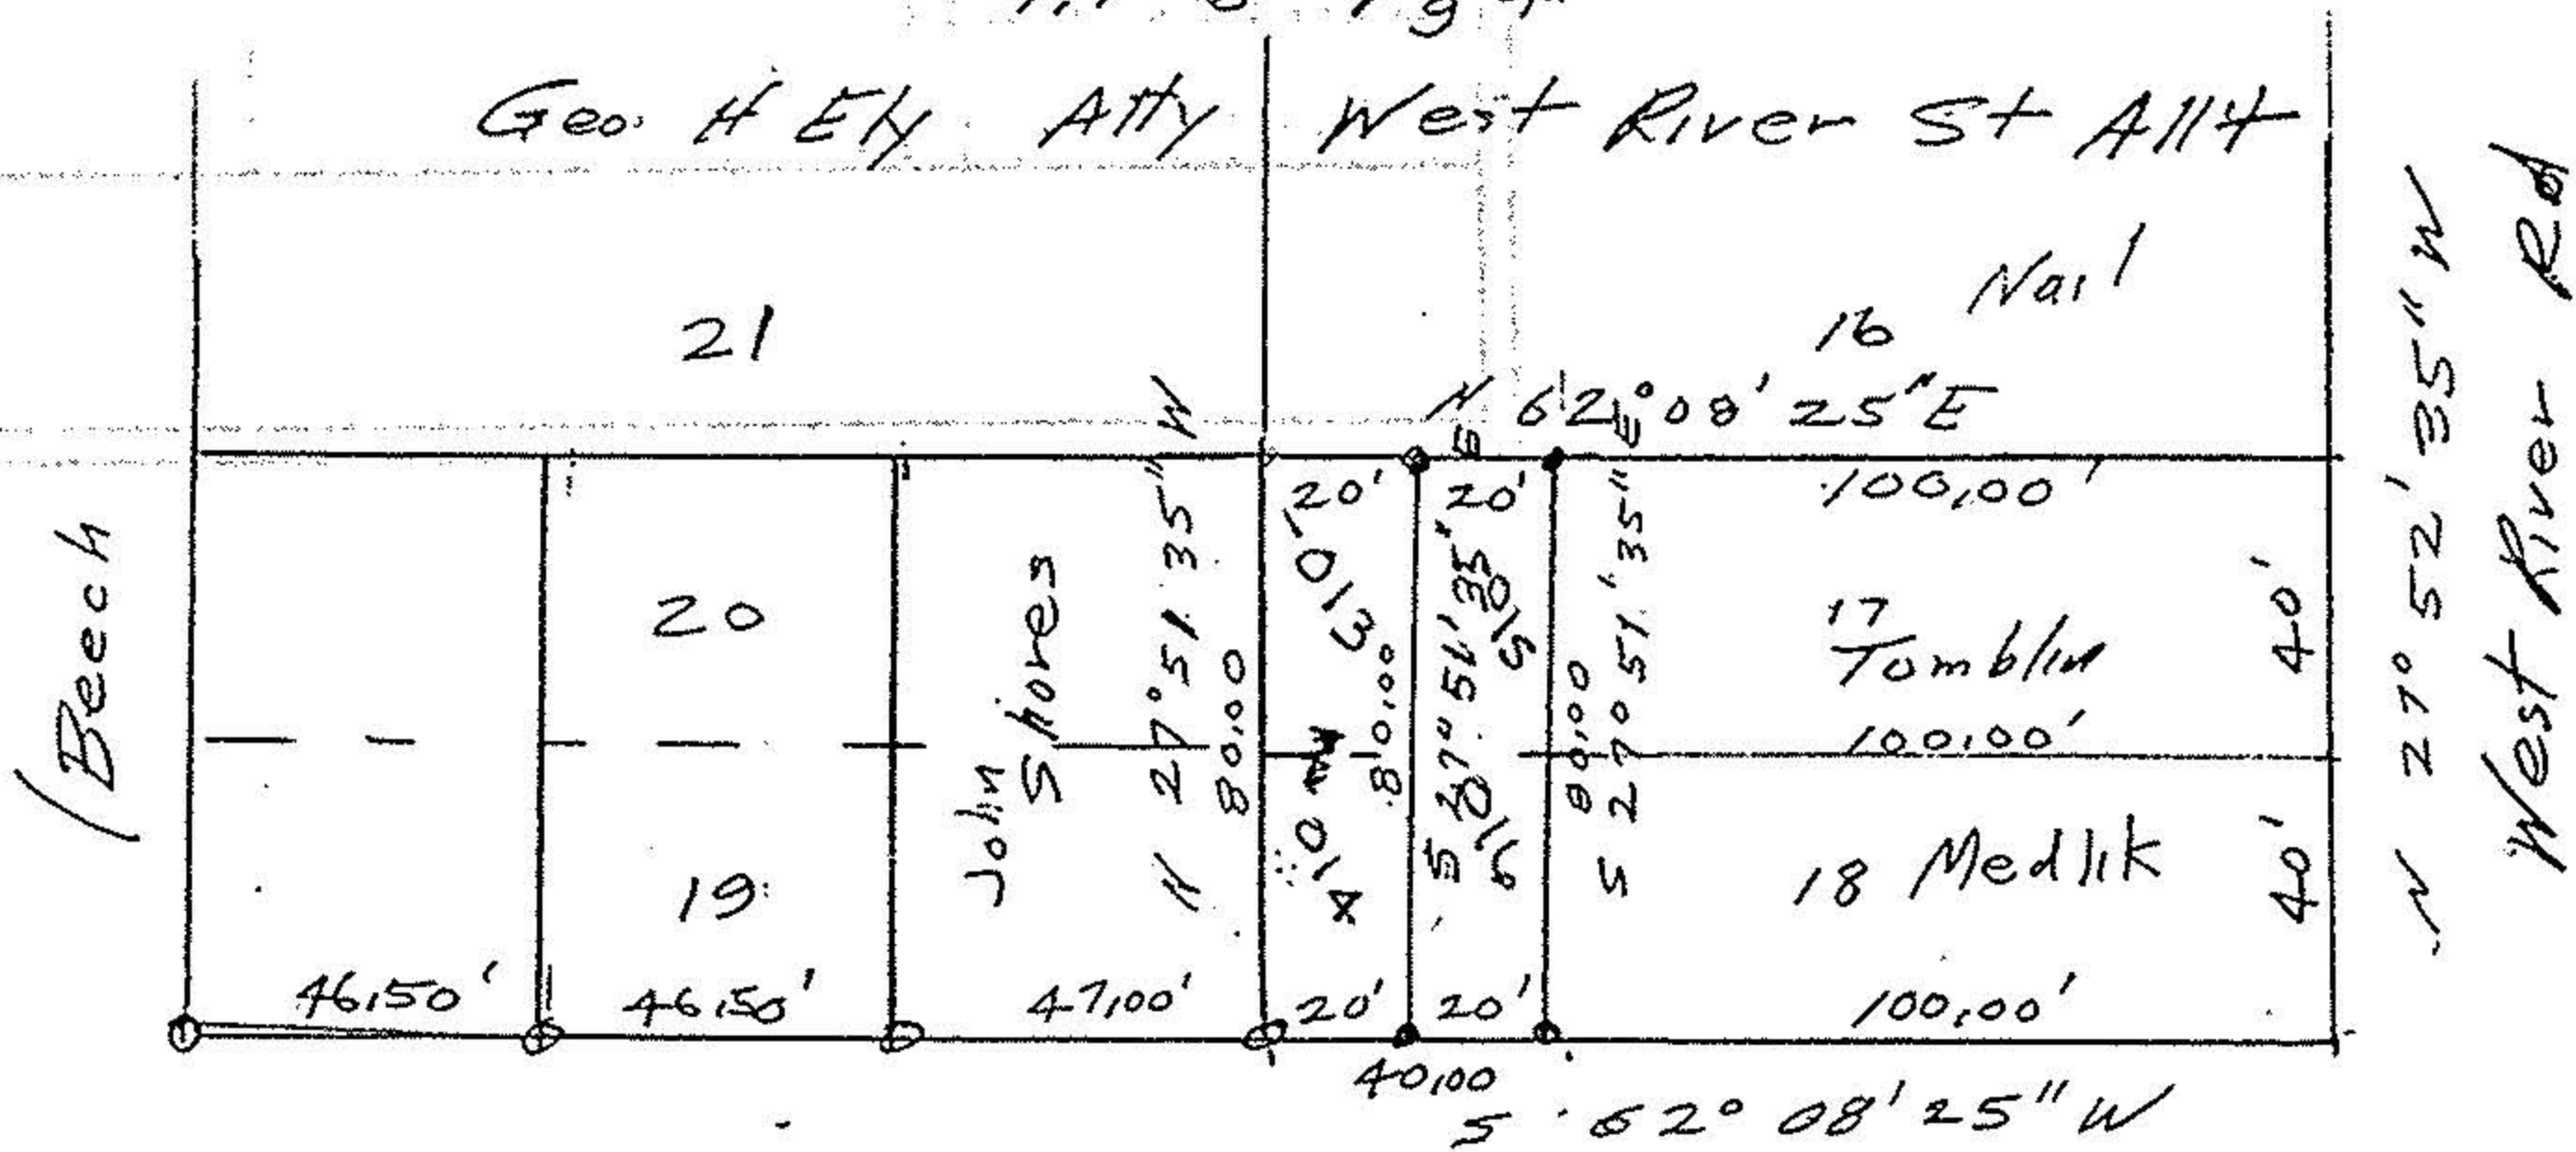

Hazel St

PRIOR INST. REF. OR 742/015
Survey of Parcel splits

- iron pipes fd
- iron pipes set

Part of sublots 17 & 18
 Geo H Ely Atty West River St A114
 P.Vol 6 Pg 41
 Part original Lot 97 West of Bl. River
 Original Elyria Township
 City of Elyria Lorain County Ohio
 Scale 1" = 50' July 1994

John Poznywak
 Reg. Surveyor
 STATE OF OHIO
 JOHN POZYWAK
 5292
 REGISTERED
 SURVEYOR

2101A
 CAROLYN S
 FRANCES
 DATE 6-117
 8-22-94
 APPROVED
 LORAIN CO.
 MAP DEPT.