



LAUNDON . SIMON . CAHL & ASSOC. INC.
 CONSULTING ENGINEERS & SURVEYORS
 219 COURT ST. ELYRIA, OHIO 44035

SURVEY FOR:

GEORGE COOK


Orig. Lot 98	City of ELYRIA	Date 5-7-86	Scale 1"=40'
Orig. Sec	Village of	Dwn. by R.G.S	Chkd. by C.J.
Tract WEST OF RIVER	County of LORAIN	Job No. 86-1488	F.B. No
Township of ELYRIA	State of OHIO	Printed	

60'

HAZEL ST. 60'

GATEWAY BLVD.

W. RIVER ST.

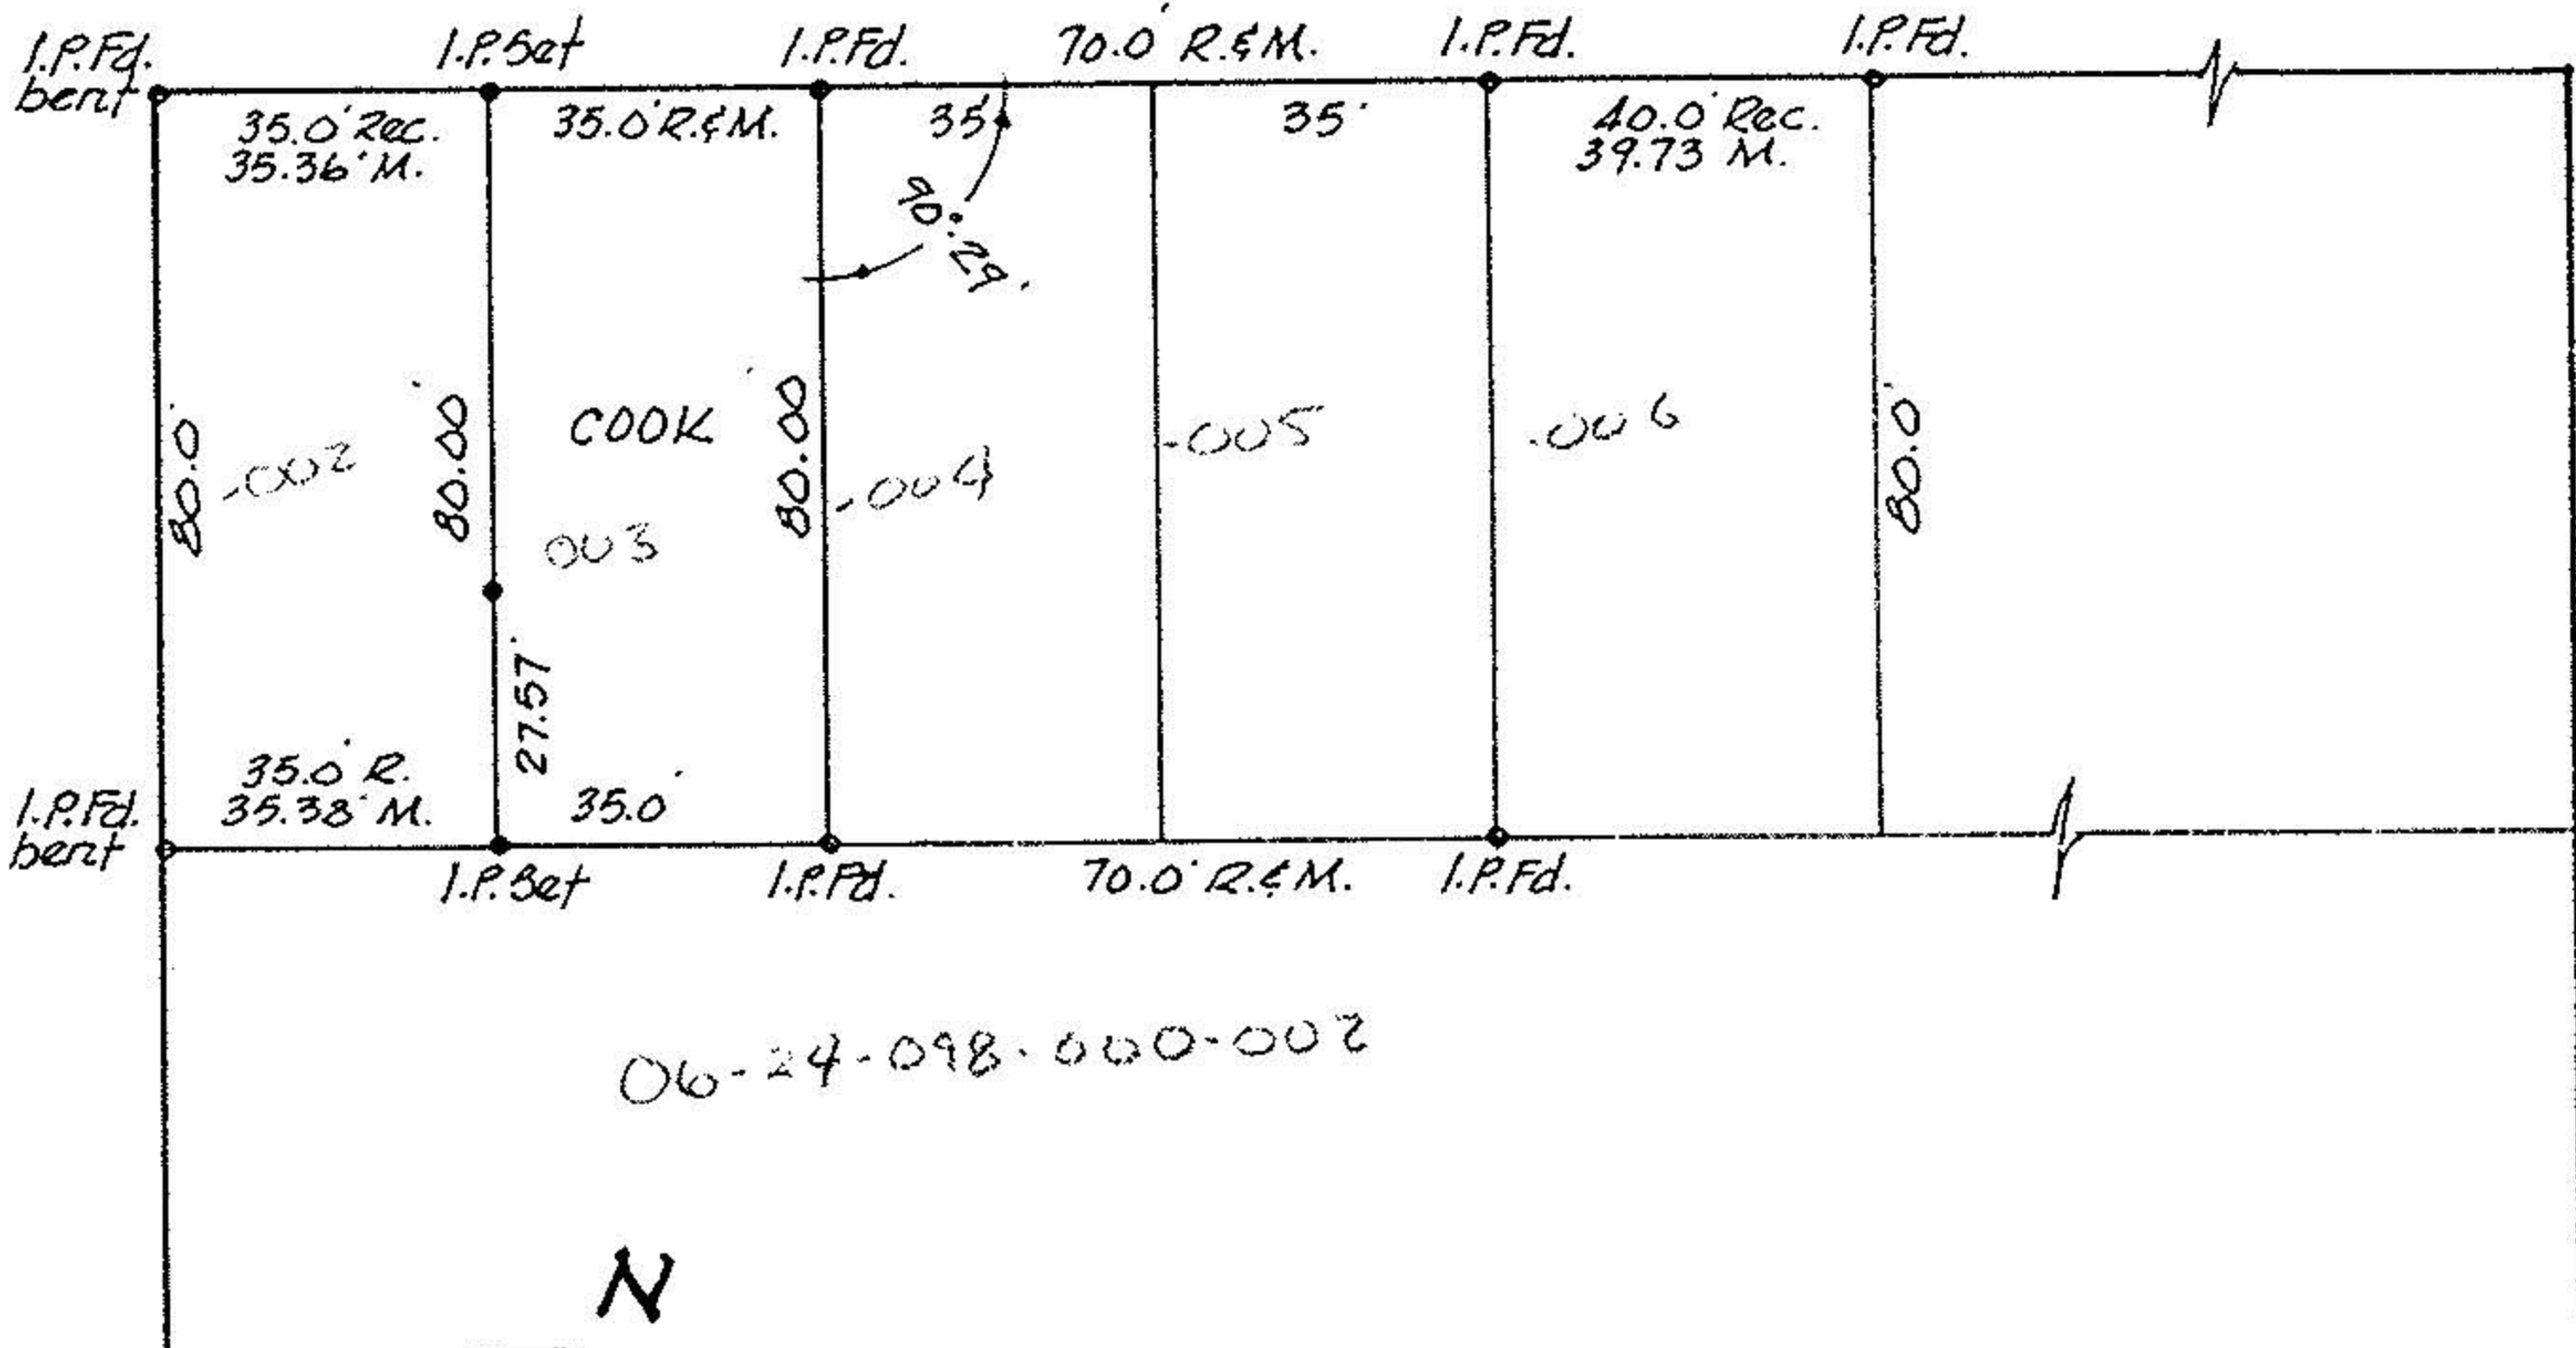

06-24-098-000-002