

Ticket # 407-D

00407-D
filed 8/24/00
CSS

10 WEST ERIE STREET, SUITE 101
PAINESVILLE, OHIO 44077
PHONE: 440.357.5841
FAX: 440.357.1816
1.800.488.3968
crabbsurv@mail.mweb.com

72 SOUTH CHESTNUT STREET
JEFFERSON, OHIO 44047
PHONE: 440.573.3488
FAX 440.376.3511


CRABBS' SURVEYING SERVICE
T. E. Stocker, P.S. 7245

RESURVEY OF LANDS

ALL THAT CERTAIN LANDS SITUATE IN THE LOT 148, WEST OF BLACK RIVER, IN THE CITY OF ELYRIA, COUNTY OF LORAIN, STATE OF OHIO. A RESURVEY OF LANDS TO THE SECRETARY OF HOUSING AND URBAN DEVELOPMENT AS RECORDED IN O.R. VOLUME 99, PAGE 0636148 IN THE OFFICE OF THE COUNTY RECORDER.



BASIS OF BEARINGS ARE TO AN ASSUMED MERIDIAN ALONG THE CENTERLINE OF FURNACE ROAD S 35°-00'-00" W

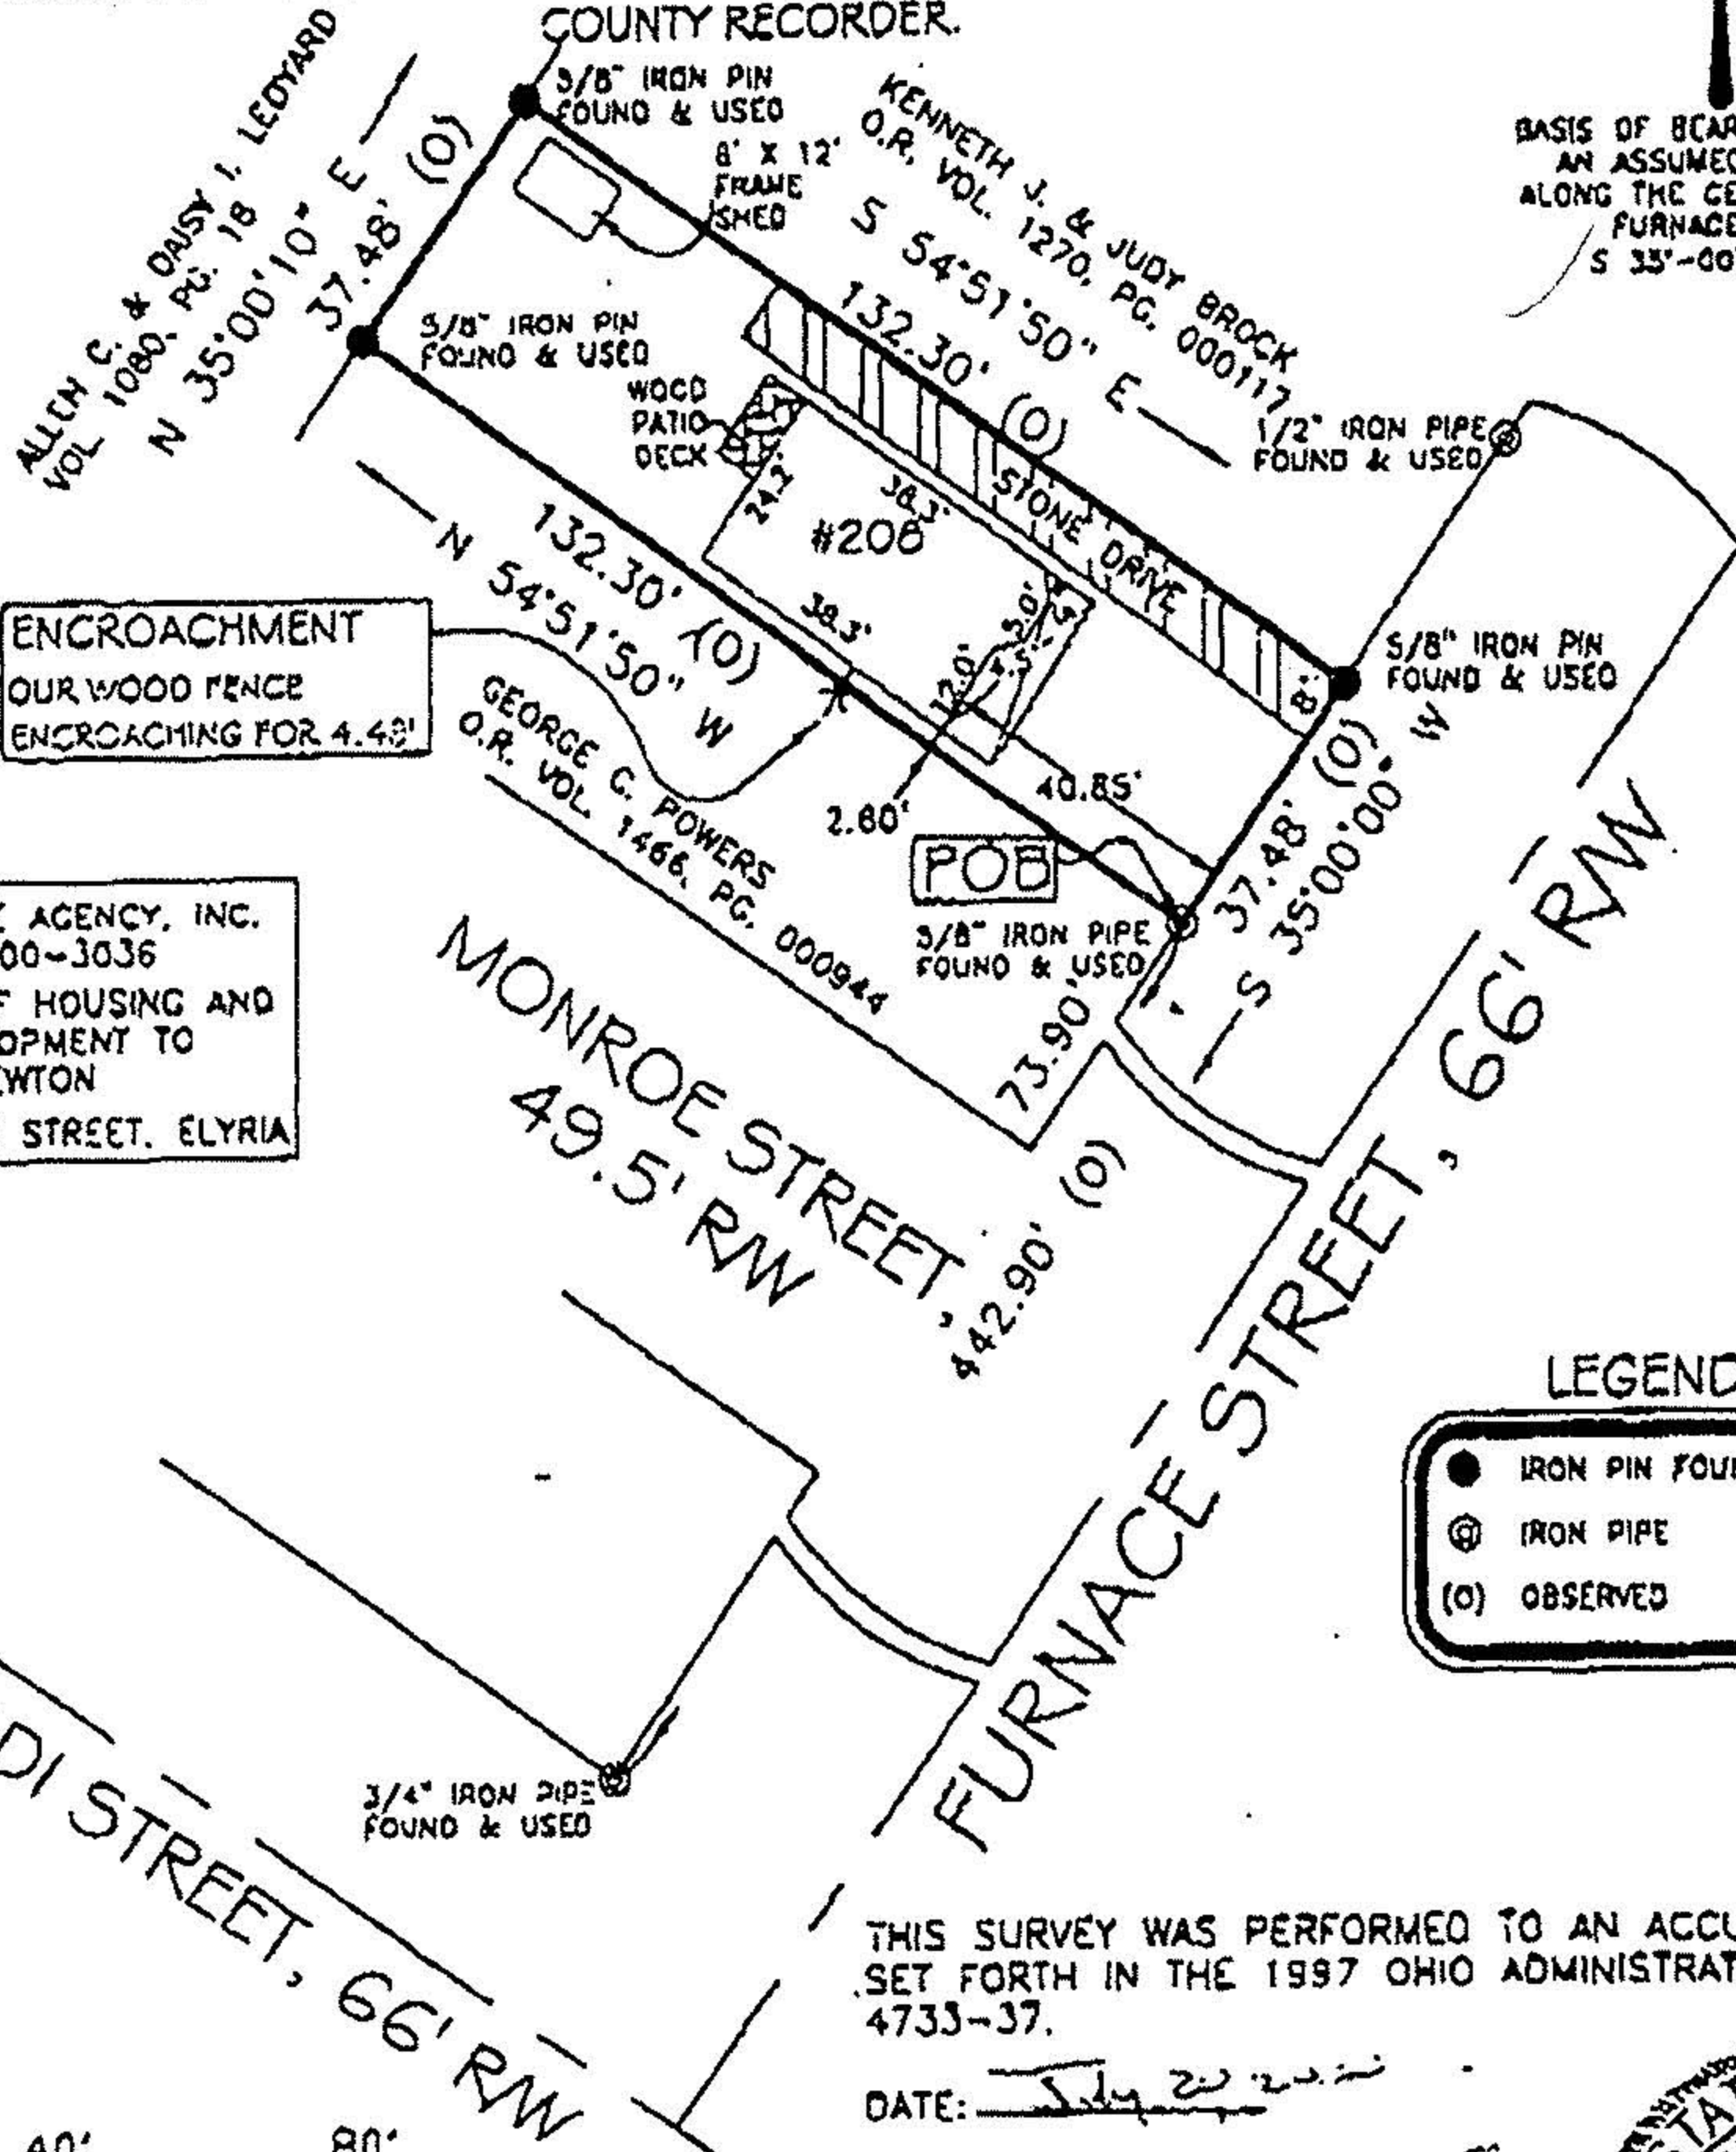


ENCROACHMENT
OUR WOOD FENCE
ENCROACHING FOR 4.48'

GATEWAY TITLE AGENCY, INC.
ORDER NO. H00-3036
SECRETARY OF HOUSING AND
URBAN DEVELOPMENT TO
PAMELA A. NEWTON
208 FURNACE STREET, ELYRIA

LEGEND

- IRON PIN FOUND/SET
- ⊕ IRON PIPE
- (O) OBSERVED

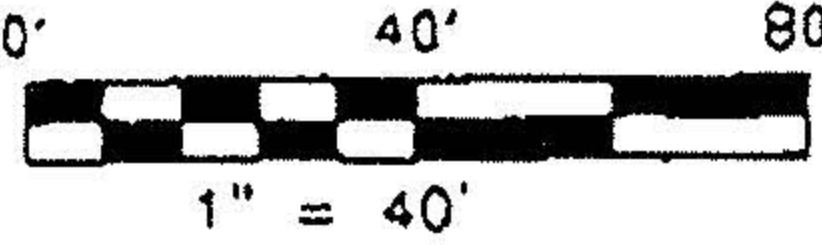

THIS SURVEY WAS PERFORMED TO AN ACCURACY AS SET FORTH IN THE 1997 OHIO ADMINISTRATIVE CODE 4733-37.

DATE: July 20, 2000

TIMOTHY E. STOCKER, P.S. 7245



06-24-148-000-00