




LAUNDON . SIMON . CAHL & ASSOC. INC.
CONSULTING ENGINEERS & SURVEYORS
219 COURT ST. ELYRIA, OHIO 44035

SURVEY FOR :

WEST PARK LIMITED, INC.

Orig. Lot 1	City of ELYRIA	Date 8-31-90 Scale 1"=100'
Orig. Sec	Village of	Dwn. by R.G.S. Chkd. by K.B.
Tract EAST of RIVER	County of LORAIN	Job No. 90-1964 F.B.
Township of ELYRIA	State of OHIO	Printed AUG 31

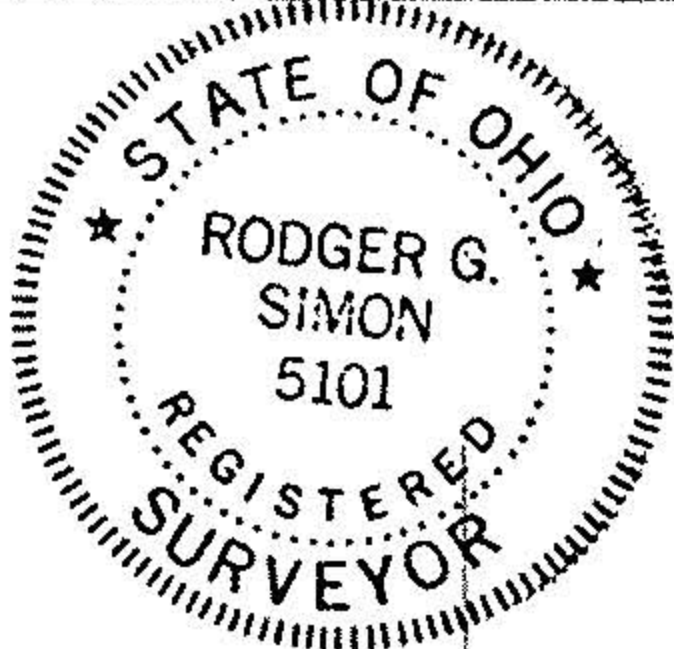

E. BROAD ST.
Spk. Fd. & Used

UNITED POLISH CLUB, INC.
V. 1107 P. 661

N. 88° 57' 54" W.
430.00'

RMDR. PCL. - 040
2.4573 Ac.
D.R.V. 302 P. 71

NOW OR FORMERLY
LOYAL ORDER OF MOOSE LODGE No 778
V. 597 P. 523

S. 1° 02' 06" W.
248.91'

I.P. Set
1.30' E.

N. 88° 57' 54" W.
430.00'

I.P. Set

PCL. 1
1.0118 Ac.

S. 88° 57' 54" E.
430.00'

I.P. Set

PCL. 2
1.0118 Ac.

430.00'

S. 88° 57' 54" E.

N. 1° 02' 06" E.

SUGAR LANE 60'
(P.V. 27 P. 67, P.V. 29 P. 57, P.V. 36 P. 15 & 16)

19134

APPROVED
LORAIN CO.
MAP DEPT

DATE 9-24-90

PAGE 6-143

CAROLYN
BY FRANCIS

VOID AFTER # 19134

-044
EUGENE WM. & GLADYS M. RESAR
V. 1235 P. 238

I.P. Fd.
0.20' N.
0.15' W.

549.14'
E. & S.

I.P. Fd. & used



19134

6-143

06-25-001-000