


THIS IS TO CERTIFY THAT THIS IS A TRUE AND ACCURATE SURVEY MADE BY LAUNDON, SIMON, CAHL & ASSOC. INC. ENGINEERS & SURVEYORS AND THAT NO ENCROACHMENTS EXIST, EXCEPT AS SHOWN, FOR AND AT THE INSTANCE OF:

ABELX CORPORATION  
 CHICAGO TITLE AGENCY OF LORAIN COUNTY  
 BY *Patrick Quinn*  
 RODGER S. SIMON REG. SURVEYOR

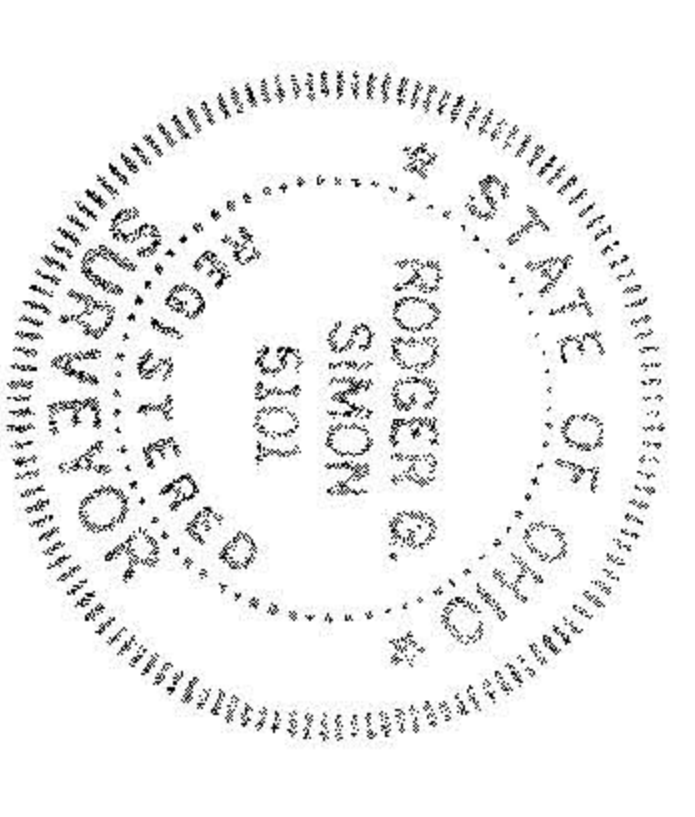

**ABELX CORPORATION**  
 SURVEY FOR THE

PART OF O.L.'s 12 & 13 EAST OF BLACK RIVER TOWNSHIP OF ELYRIA  
 ALL OF 5/4'S & THROUGH IT INCLUSIVE IN CHAMBER OF COMMERCE ALLOT P.V. 7 P. 27  
 CITY OF ELYRIA COUNTY OF LORAIN STATE OF OHIO  
 SCALE 1" = 50'  
 LAUNDON, SIMON, CAHL & ASSOC. INC.  
 ENGINEERS SURVEYORS  
 219 COURT ST. ELYRIA, OHIO (216) 322-7625  
 JOB NO. 87-167A

#17864  
 APPROVED  
 LORAIN CO.  
 MAP DEPT.  
 DATE 3-10-88  
 PAGE 6-106  
 BY *T. McMan*  
 VOID AFTER 17864

226