

# KLEINODER-SCHMIDT and ASSOCIATES

ENGINEERS — SURVEYORS — CONSULTANTS IN LAND PLANNING

ELYRIA · NORWALK · MEDINA

OHIO

# SURVEY

Sublot(s) 13, 14, 16

Subd'n MEADOWBROOK ALLOT.

P.V. 6 P.27

Tract E. OF BLACK RIVER

Sec. State of Ohio

Township ELYRIA


Orig. Lot(s) 16

County of LORAIN

Corporation CITY OF ELYRIA

016  
06-25-101-

G-104

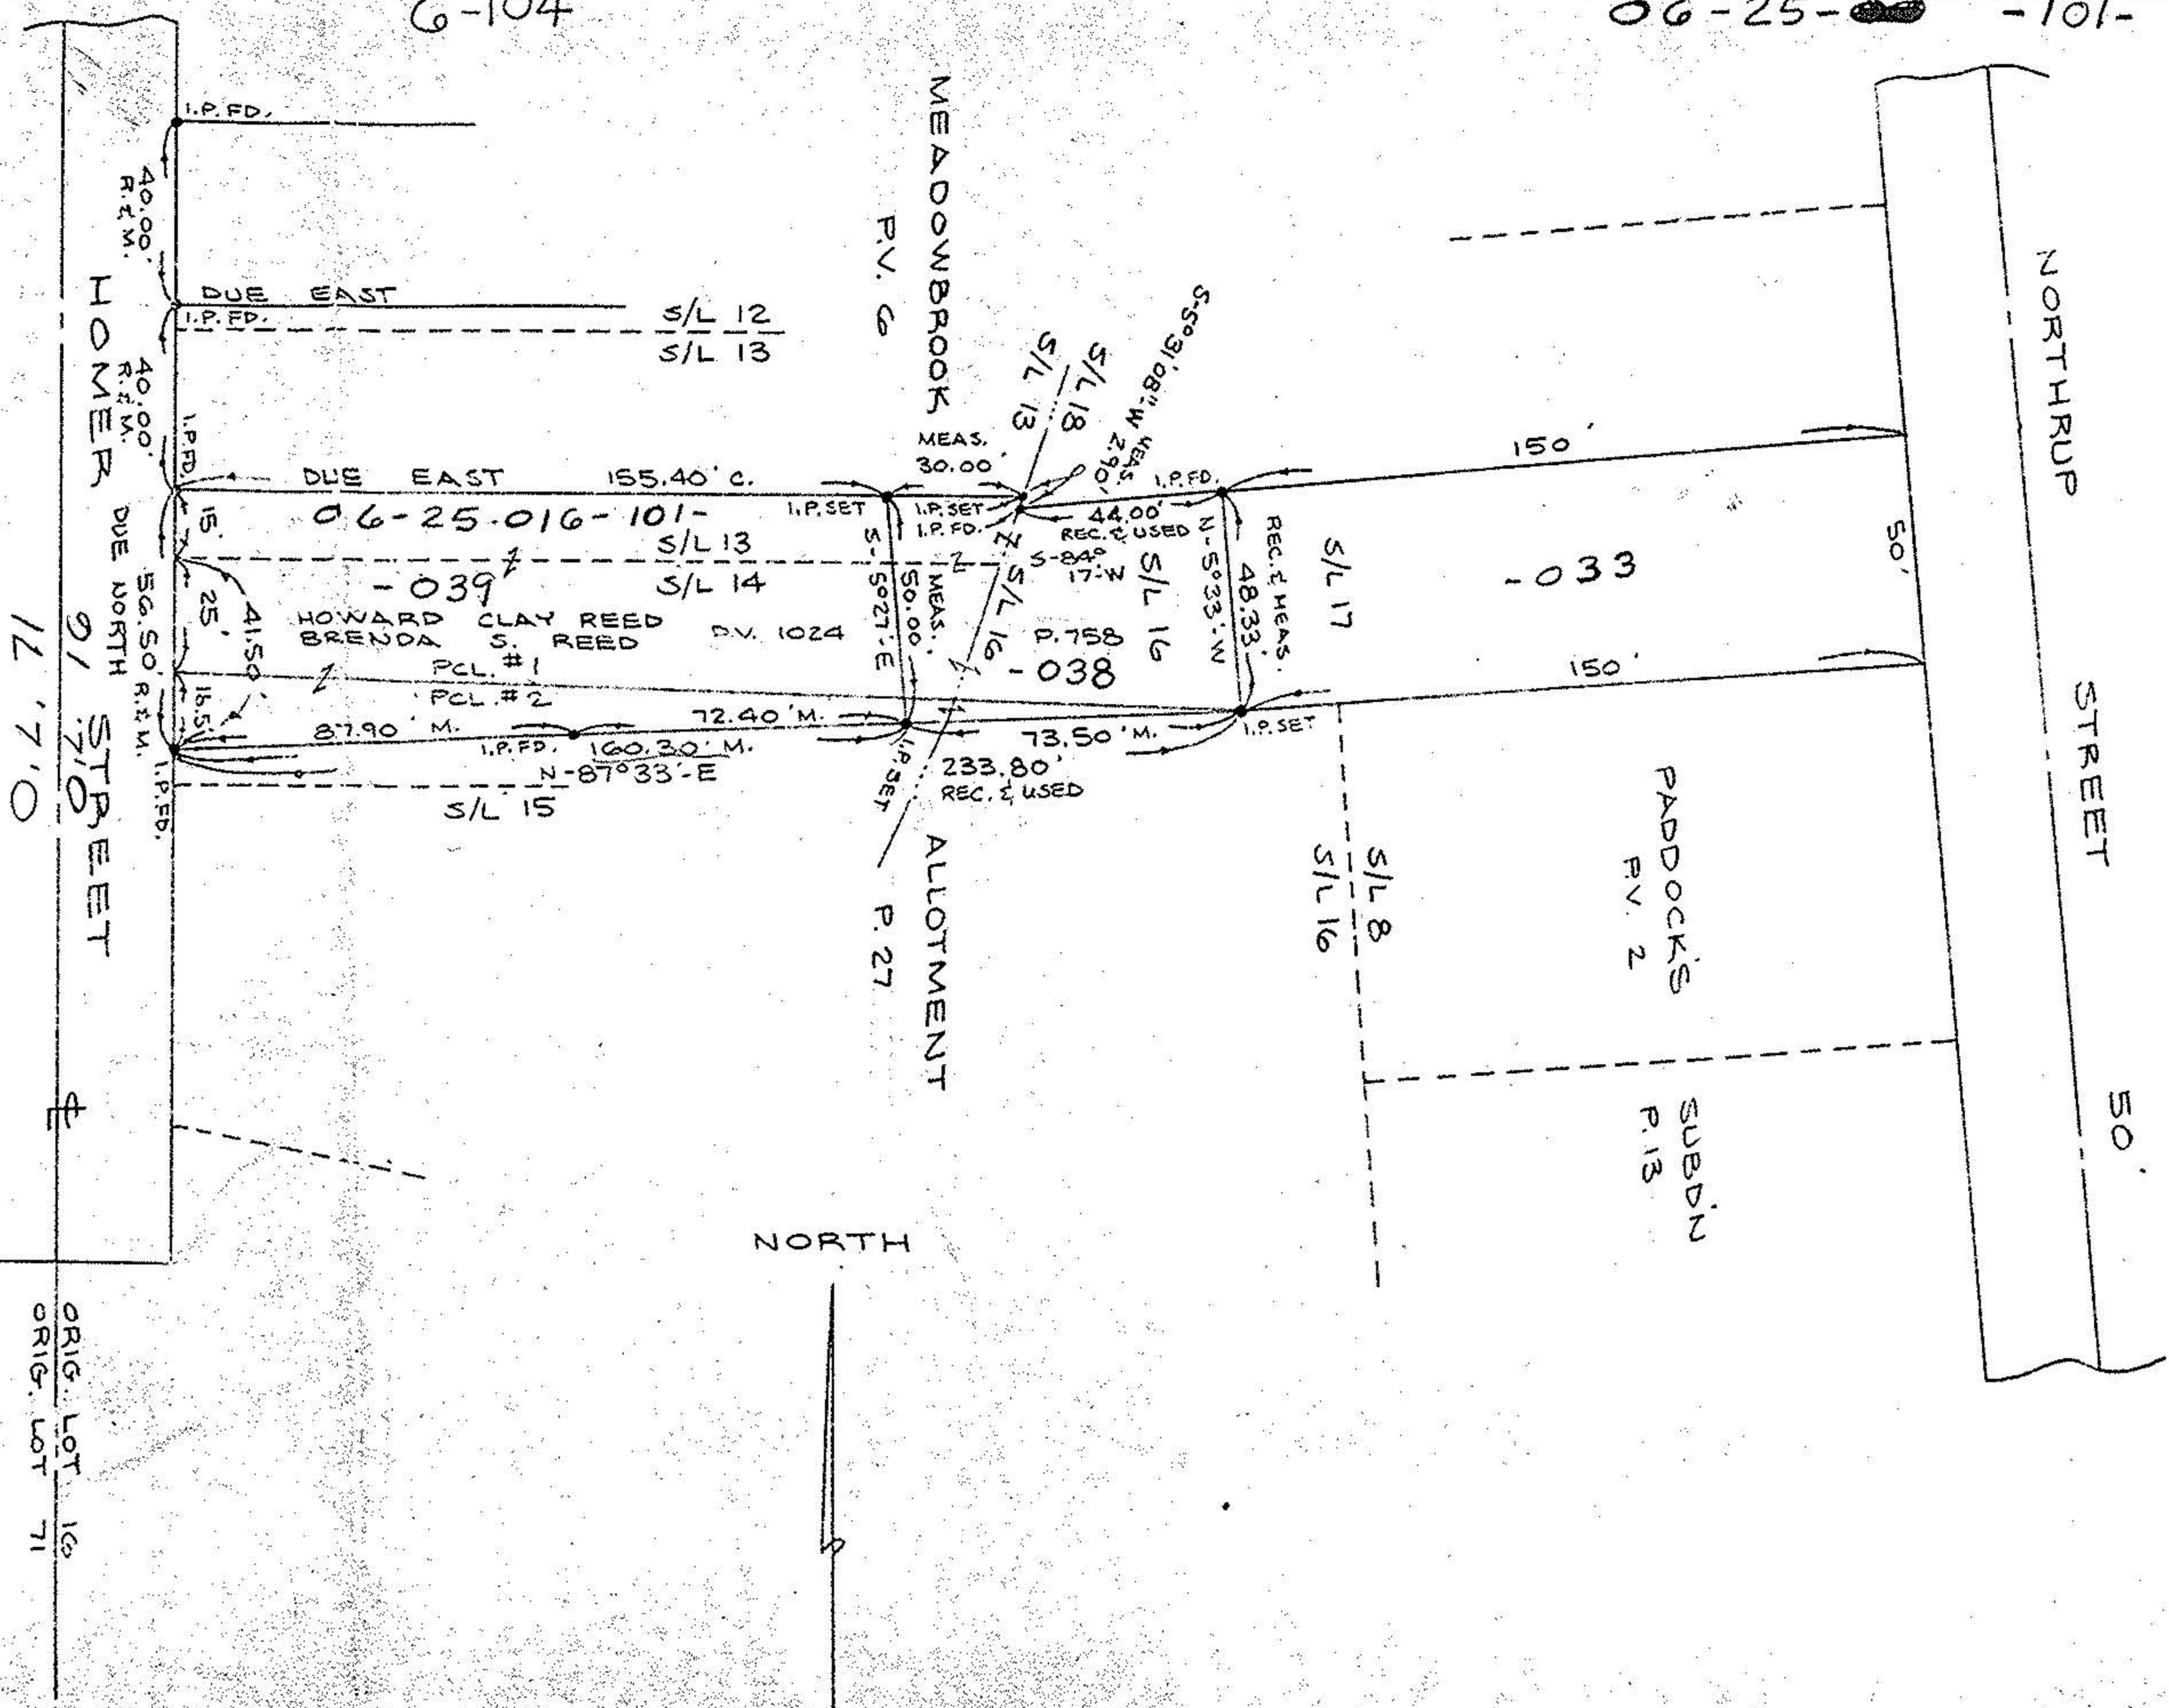

Prepared for:

LES DRAGE  
ELYRIA, OHIO

Scale:

Date: G-20-74

Dr. by: *AS*

Job No. 74-174

REV. 7-3-74

ORIG. LOT 16  
ORIG. LOT 71