

BOUNDARY SURVEY

PREPARED FOR: H.U.D.

PERM. PARCEL NUMBER: 06-25-016-108-036

S/L#: MTS.&BDS.

STREET ADDRESS: 516 East Broad St.

IN Elyria Township Lot No.16

SUBDIVISION

CITY OF: Elyria


COUNTY OF: Lorain

STATE OF: OHIO

DATE: 17, November 1999

JOB NO.: 4016

MACKAY
 Engineering & Surveying Company
 7017 Pearl Road, Cleveland, Ohio 44130
 (440) 886-4500 (440) 886-4590 Fax
 Email: mackay@er.com

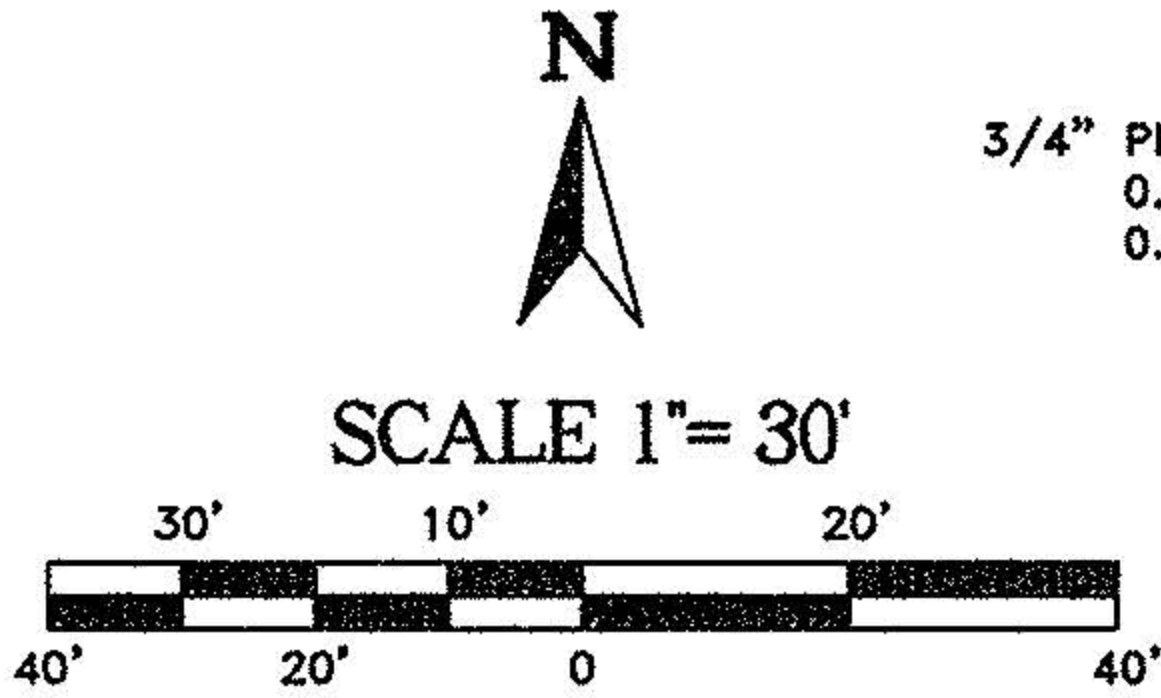

OUR 5' CHAIN LINK FENCE ENCROACHES

PROPERTY LINE 1.4'±

3/4" PIPE FD.&U.
0.14'S
0.41'E

4 RODS DEED
65.59' OBS.

5/8" IRON PIN W/
CAP SET

OUR FENCE ENCROACHES
PROPERTY LINE 0.7'±


OUR 5' CHAIN LINK FENCE ENCROACHES

PROPERTY LINE 0.3'±

LEGEND:

- ××× FENCE
- 3/4" PIPE
- ▲ 5/8" IRON PIN W/CAP
- STONE MARKER
- 1/2" PIPE
- DEED DISTANCE FOUND IN DEED
- FD.&U. FOUND AND USED
- R.&U. RECORDED & USED
- OBS. OBSERVED

NEIGHBOR'S 4' CHAIN LINK FENCE
ENCROACHES PROPERTY LINE 0.7'±

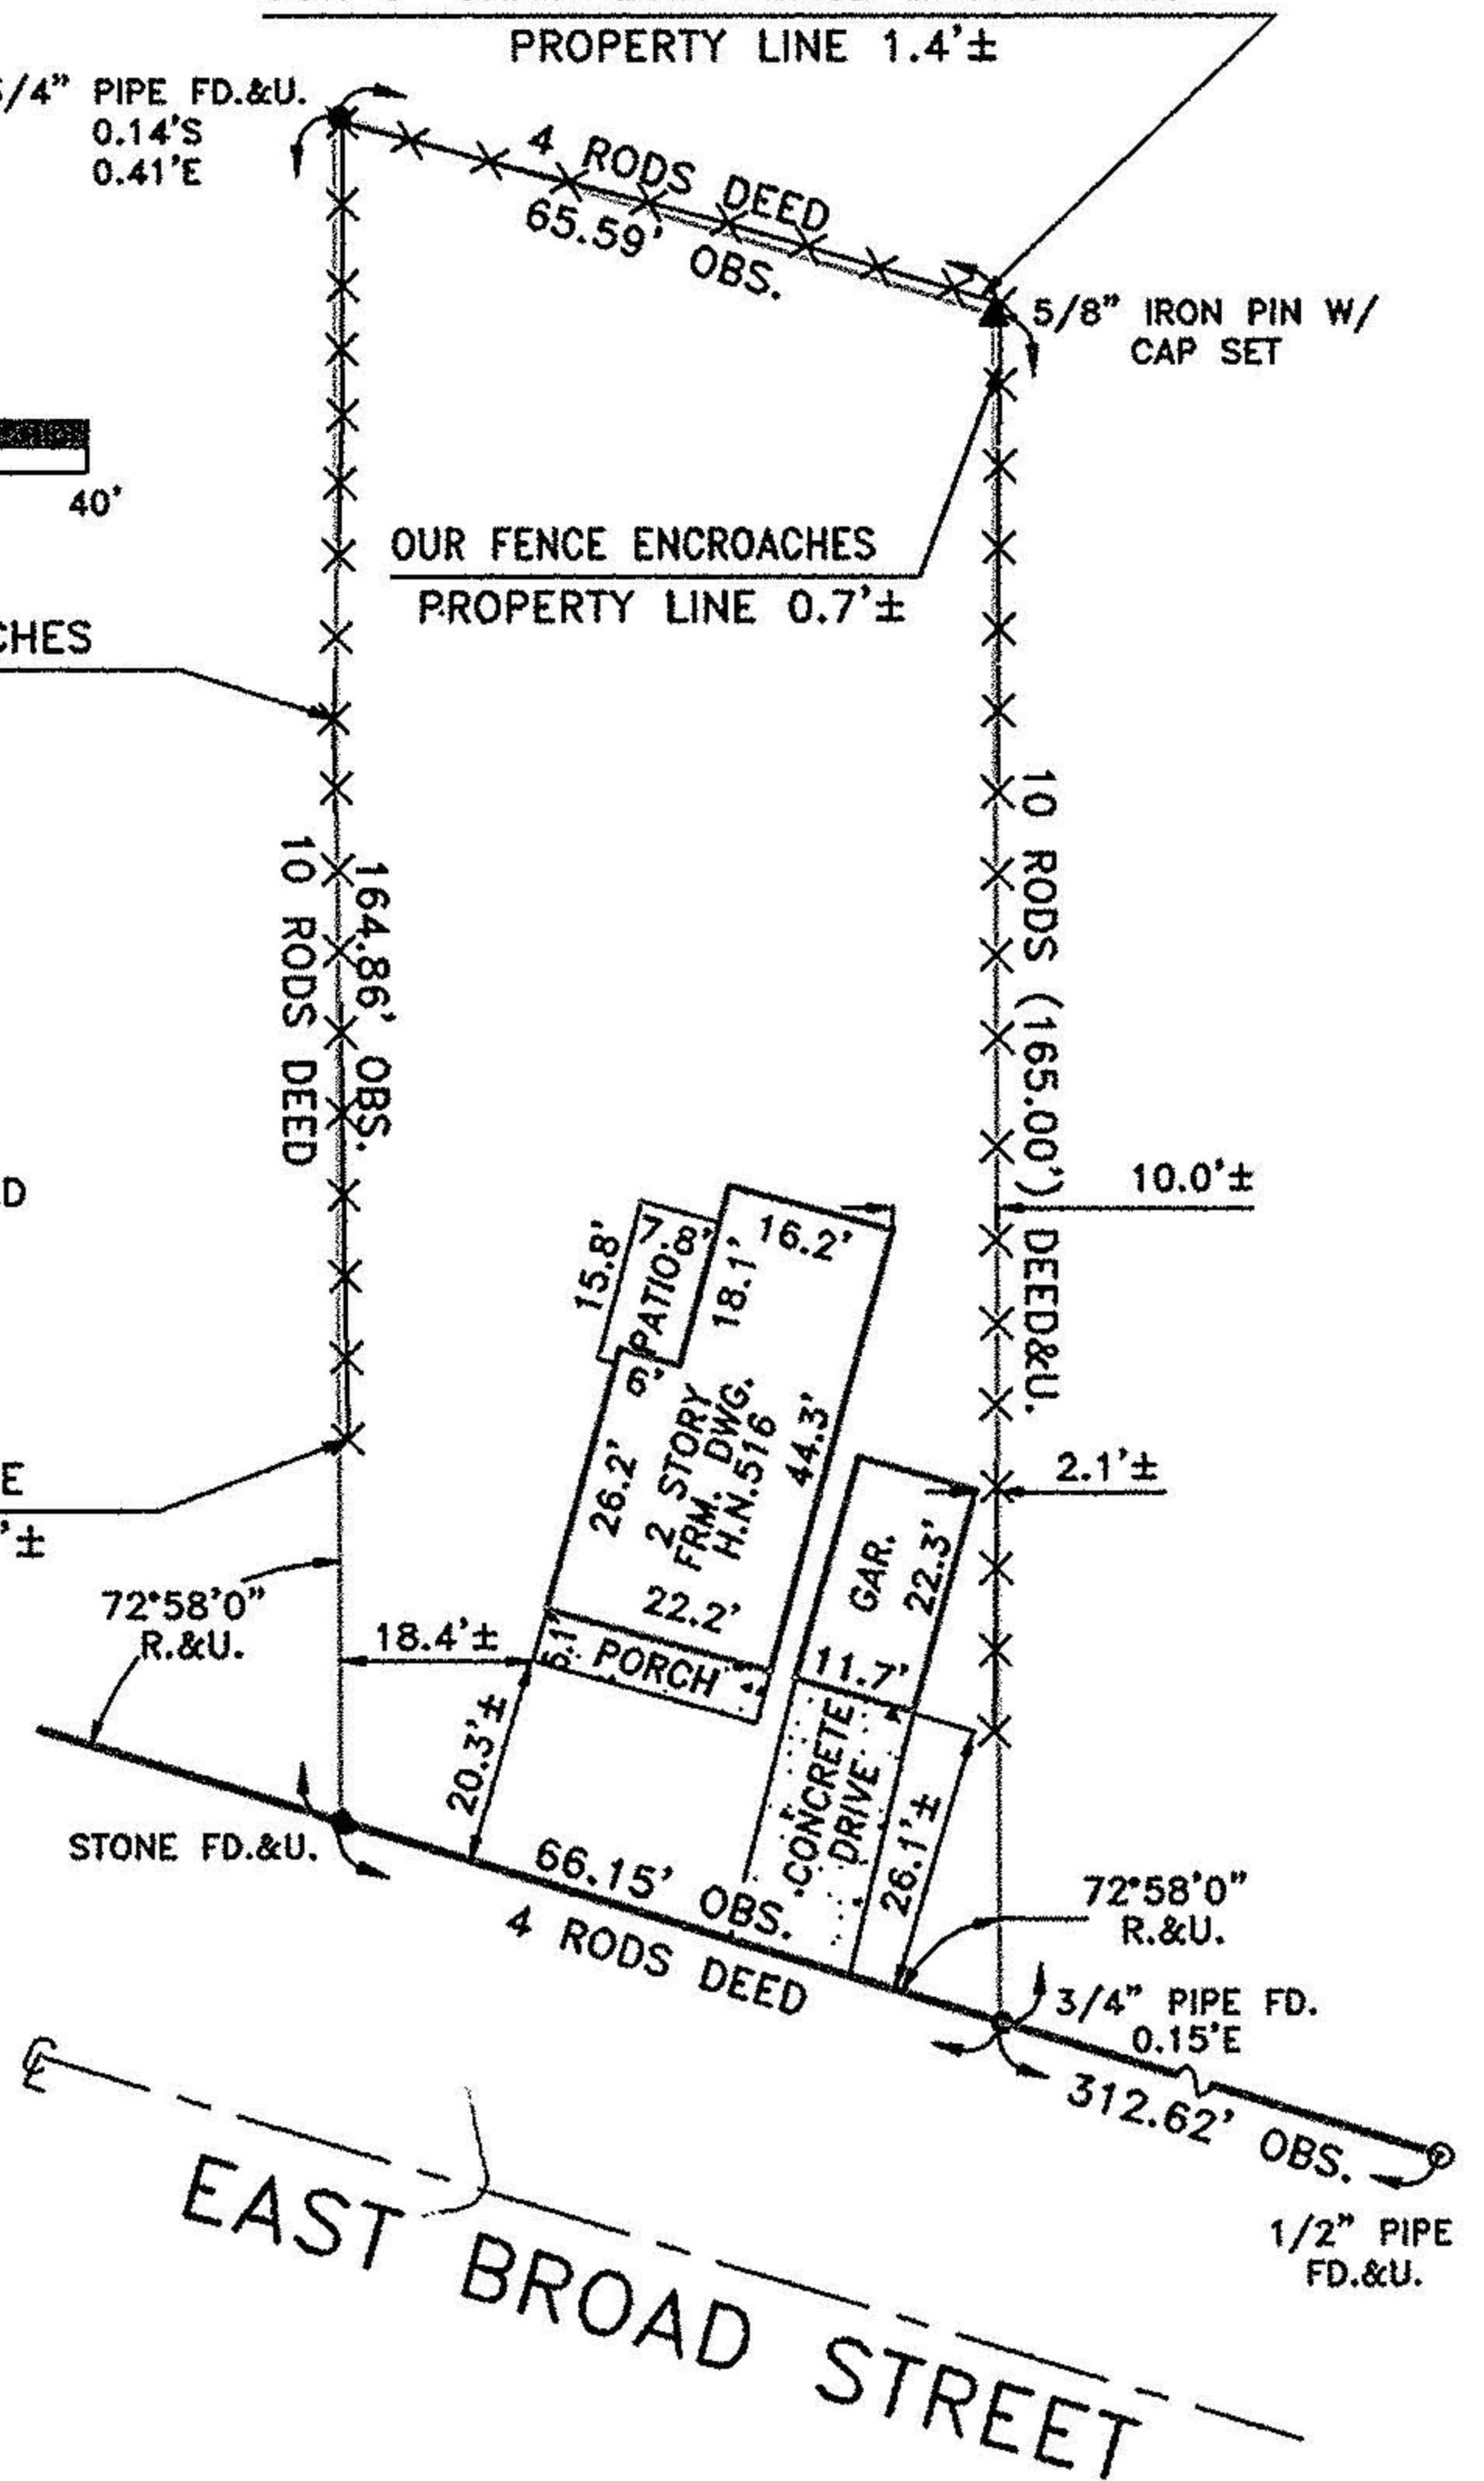

Richard R. Mackay
 RICHARD R. MACKAY
 REG# 4195

EAST BROAD STREET