

06-25-018-106-022

6-105


BELLFIELD AVE 50'

Walk

Street Line

40.0' rec 3 mcs

30.00'

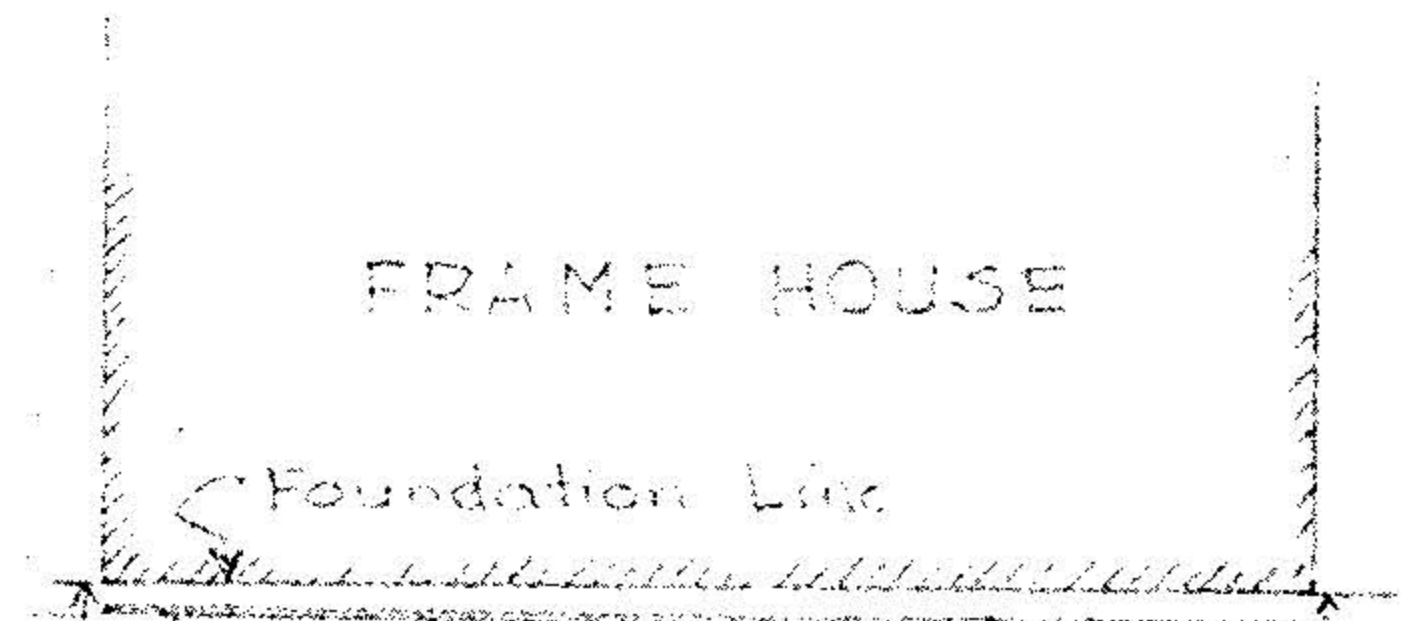

FRAME HOUSE

Foundation Line

Drive

810.712

69' 8.02

FRAME GARAGE

Back Line to Rec Line  
0.50'

122.92 rec 3 m.

Iron pin found  
1.65' W  
1.56' S of Record Lot corner

South Lot Line by Record

Line steel fence posts 0.50' South of Record Line

South Line Driveway, 10' 2" of Record Line

Line parallel to record Lot Line & 1.56' South  
formed by producing a line parallel to Lot Lot  
Easterly from Iron pin found.

Blue line to South edge  
eaves spacing 1.50'

SURVEY FOR WILLIAM C. & VIOLA M. STELZER  
 LOT 102 BELLFIELD PARK ALLT  
 P.V. 8-35 & 36 ELYRIA CITY  
 LORAIN CO. OHIO. SCALE 1"=10'  
 SEPT. 29, 54 T.W. LAUNDON REG. SURVEYOR