
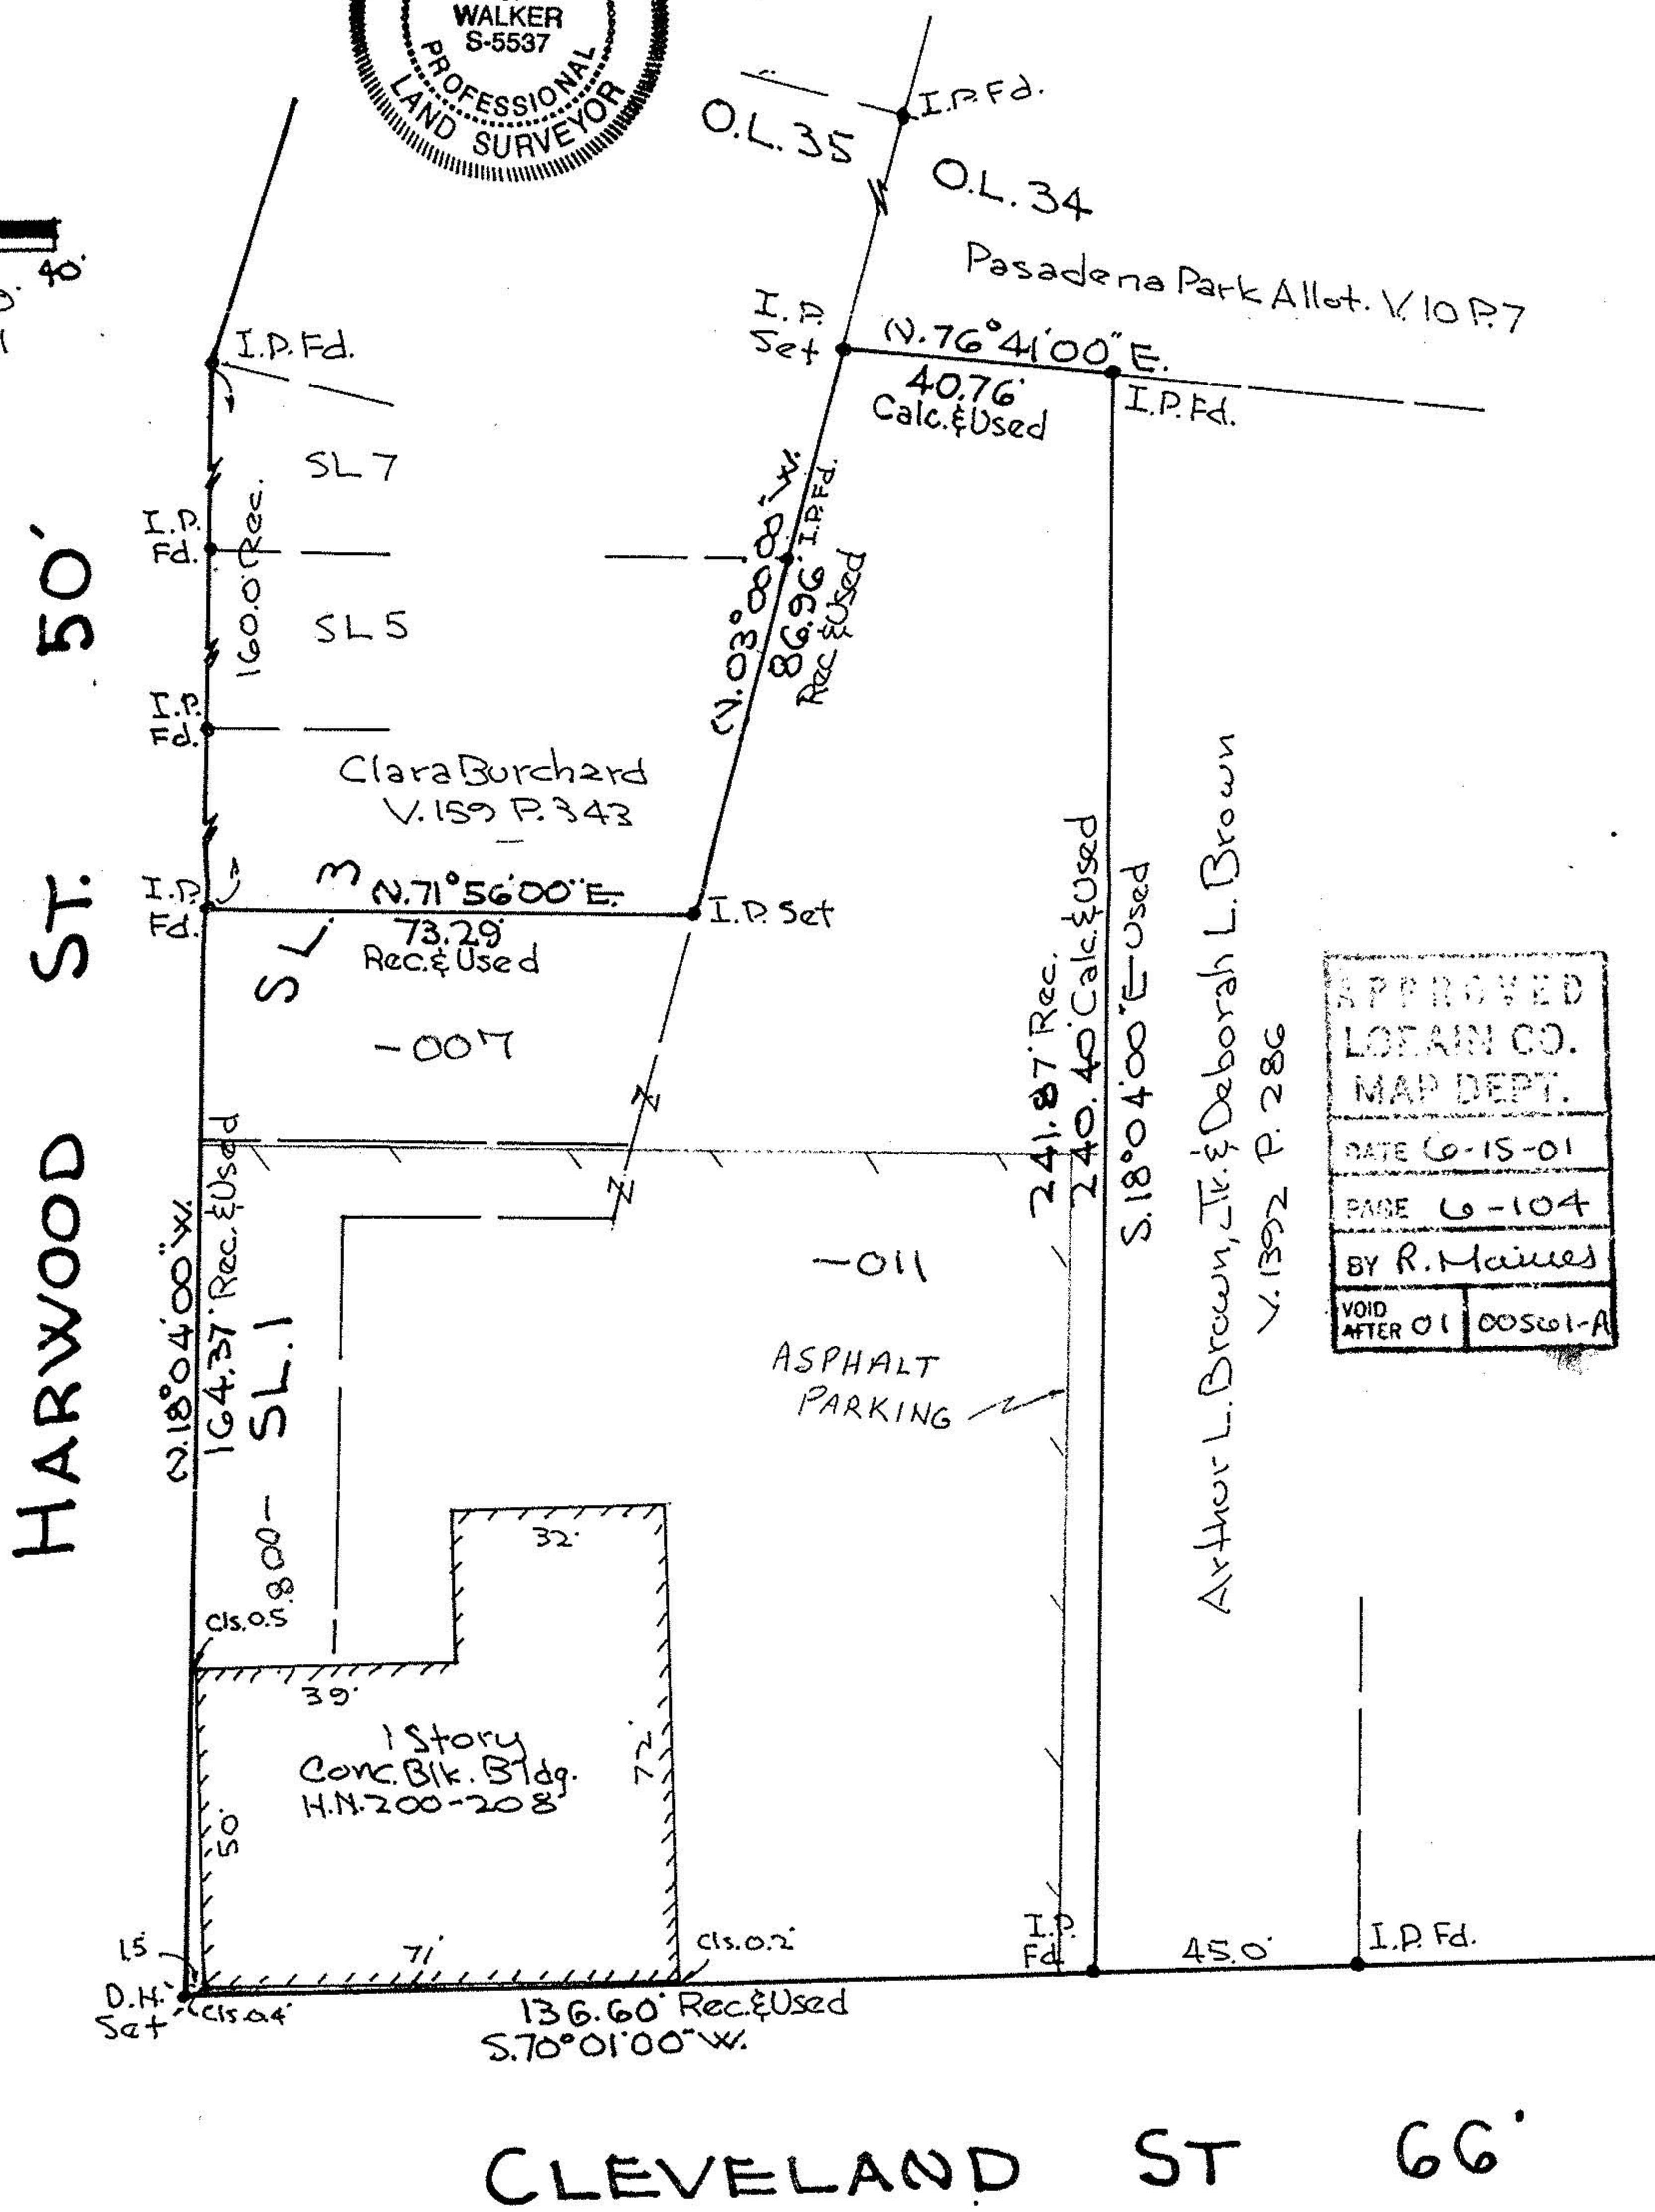


PROPERTY SURVEY FOR NICOLAS VERIKAKLIS

Being all of Sublot No. 1 and part of Sublot No. 3 in the R.P. Lersch Addition as recorded in Volume 6, Page 22 of Lorain County Map Records and also part of Original Elyria Township Lot No.'s 34 and 35 East of Black River now in the City of Elyria, County of Lorain and State of Ohio

Dimensions shown are hereon expressed in feet and decimal parts thereof. Mon. where found or set as indicated hereon. Bearings shown are to an assumed meridian and are for the sole purpose of describing the relative angular value between lines, all of which I certify to the best of my belief.

John S. Walker
JOHN S. WALKER
 Surveyor (No. 5537)
 8026 Wright Rd., Broadview Hts., Oh.
 Tel. No. - 1-440-717-0625

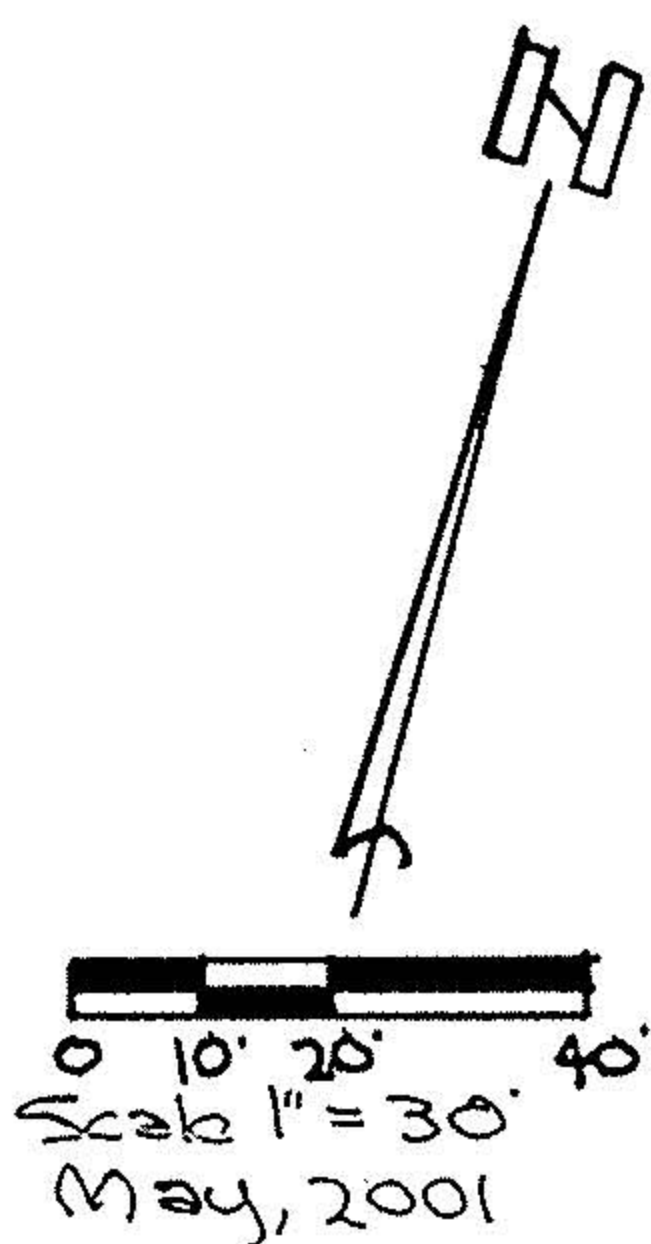

APPROVED	
LORAIN CO. MAP DEPT.	
DATE 6-15-01	
PAGE 6-104	
BY R. Maires	
VOID AFTER 01	00501-A