


West Line of Allotment

195.73 West to I.P. Found  
710 ST.

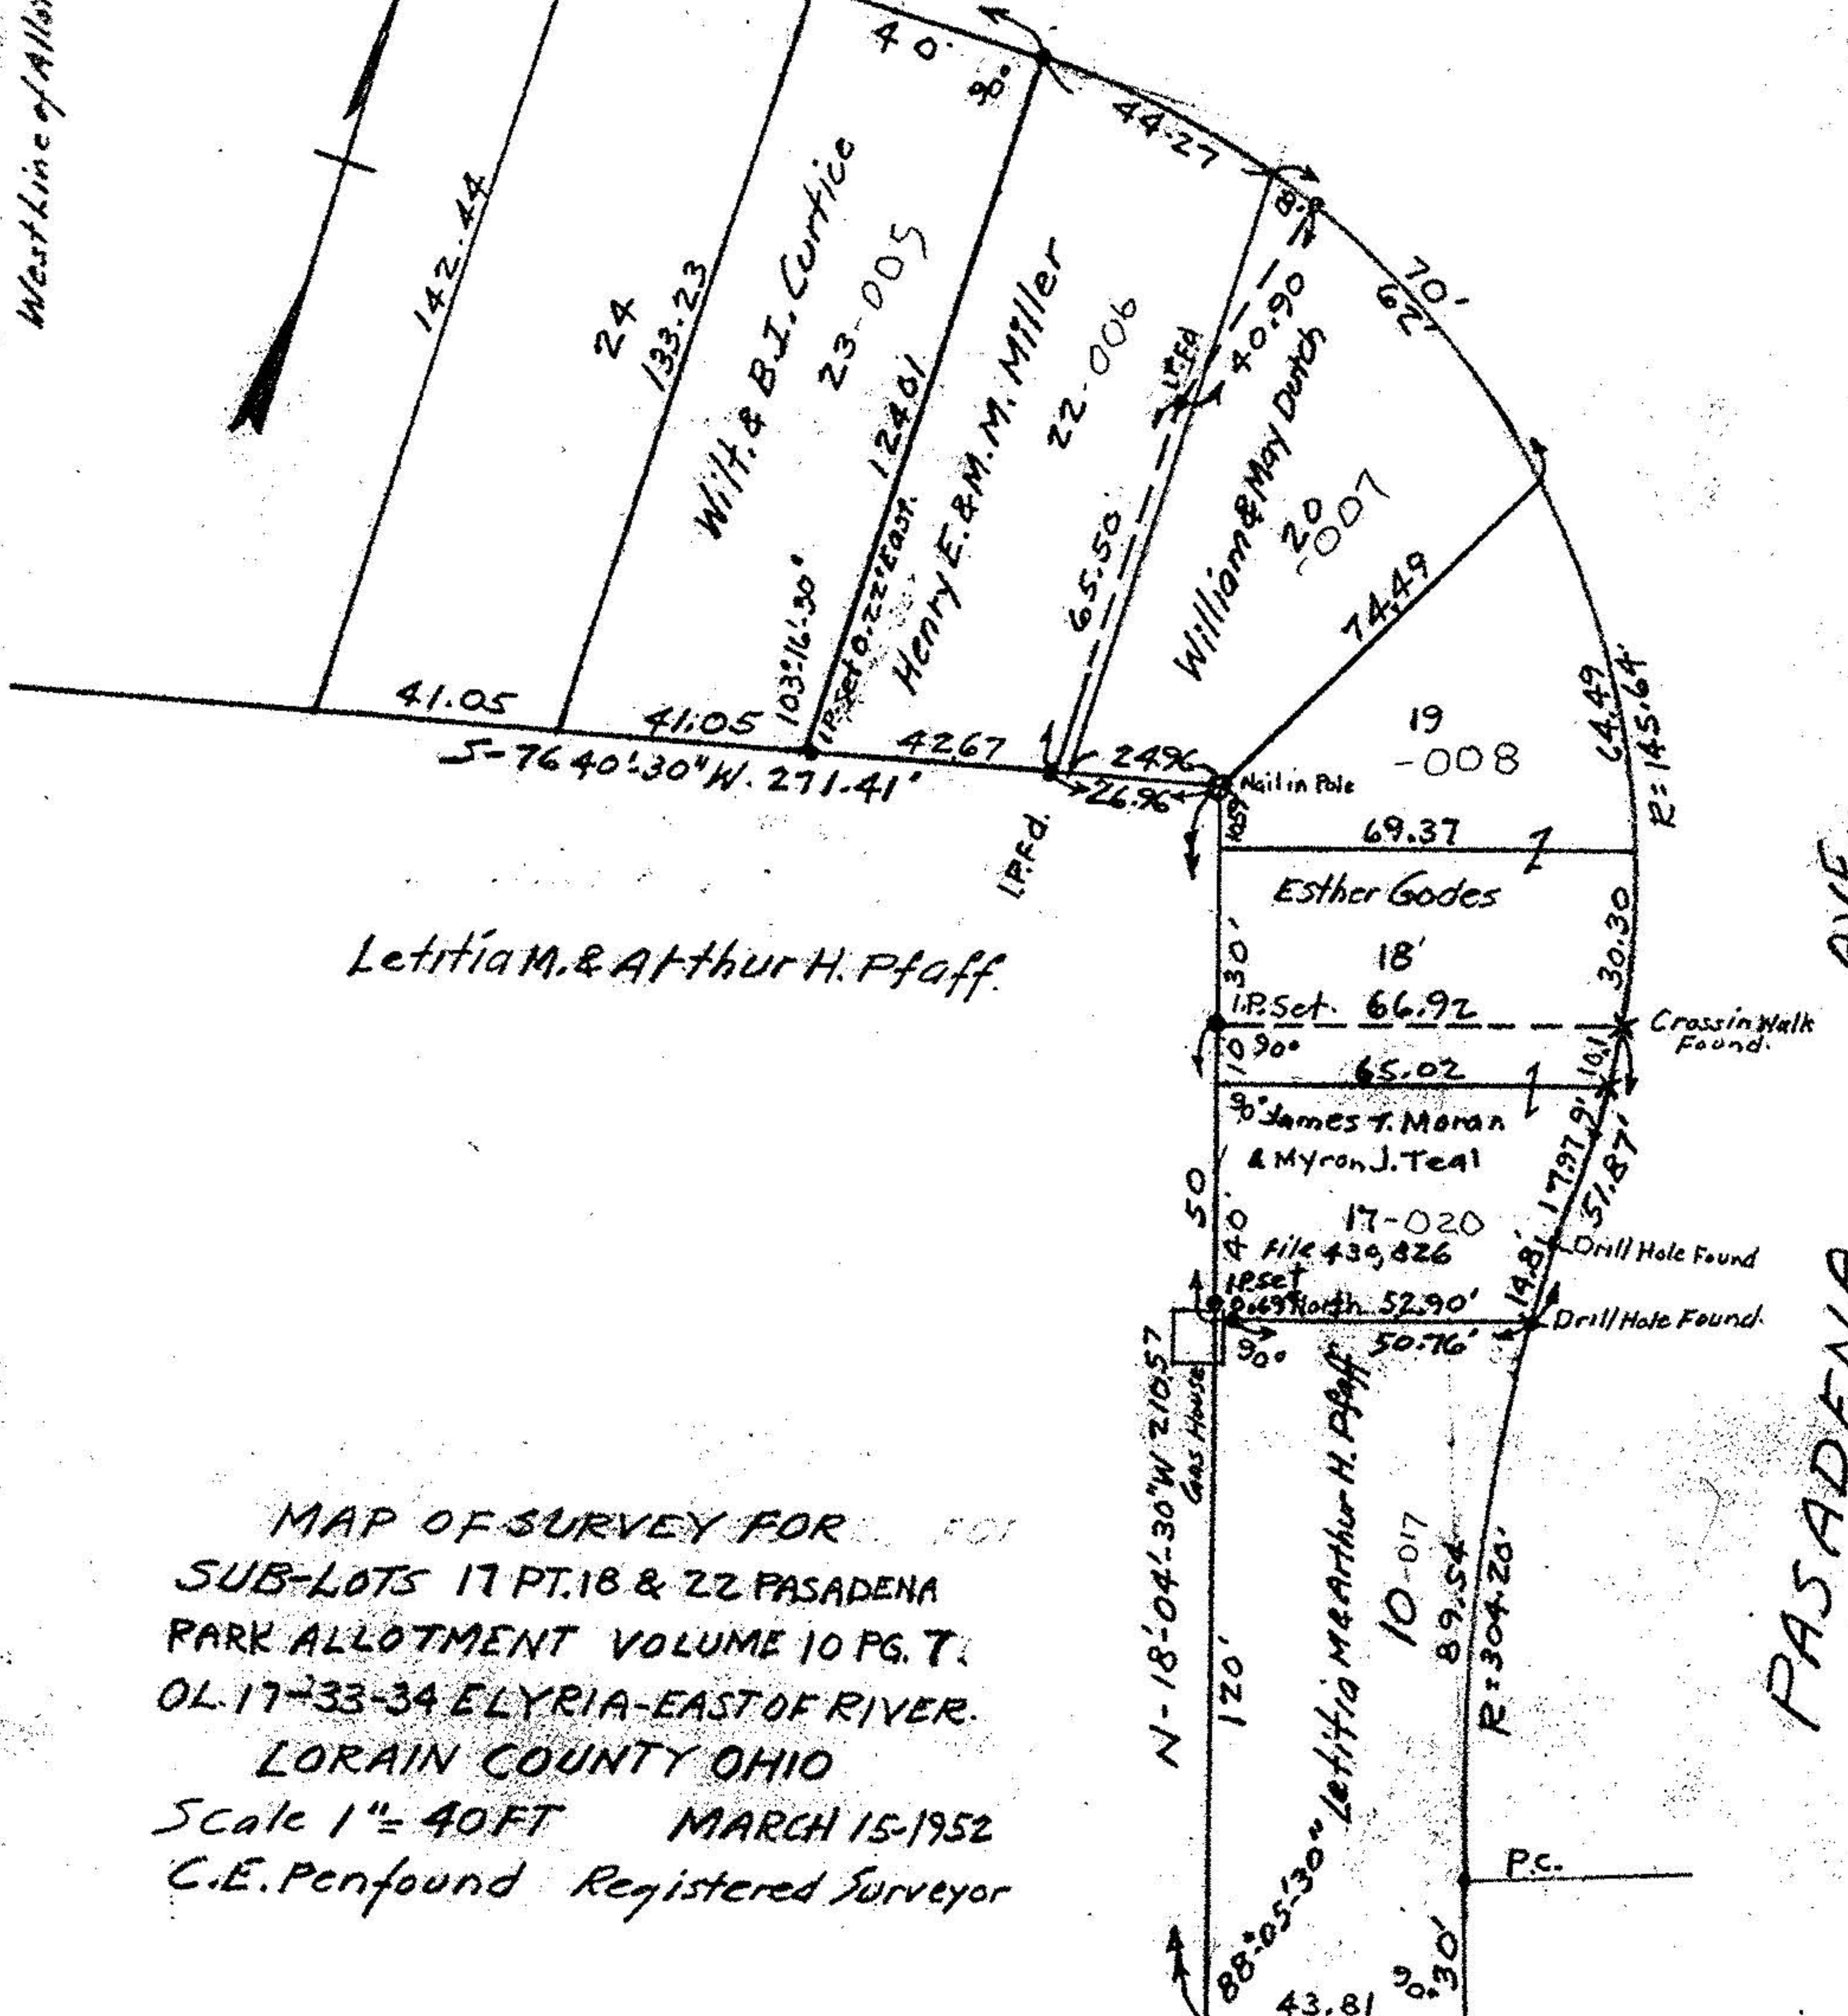

Letitia M. & Arthur H. Pfaff.

MAP OF SURVEY FOR  
 SUB-LOTS 17 PT. 18 & 22 PASADENA  
 PARK ALLOTMENT VOLUME 10 PG. 7.  
 OL. 17-33-34 ELYRIA-EAST OF RIVER.  
 LORAIN COUNTY OHIO  
 Scale 1" = 40 FT MARCH 15-1952  
 C.E. Penfound Registered Surveyor

S-70-01'-W.

CLEVELAND STREET.

PASADENA AVE.