


0101
O.L. 1
T. 26

06-26-001-102-026

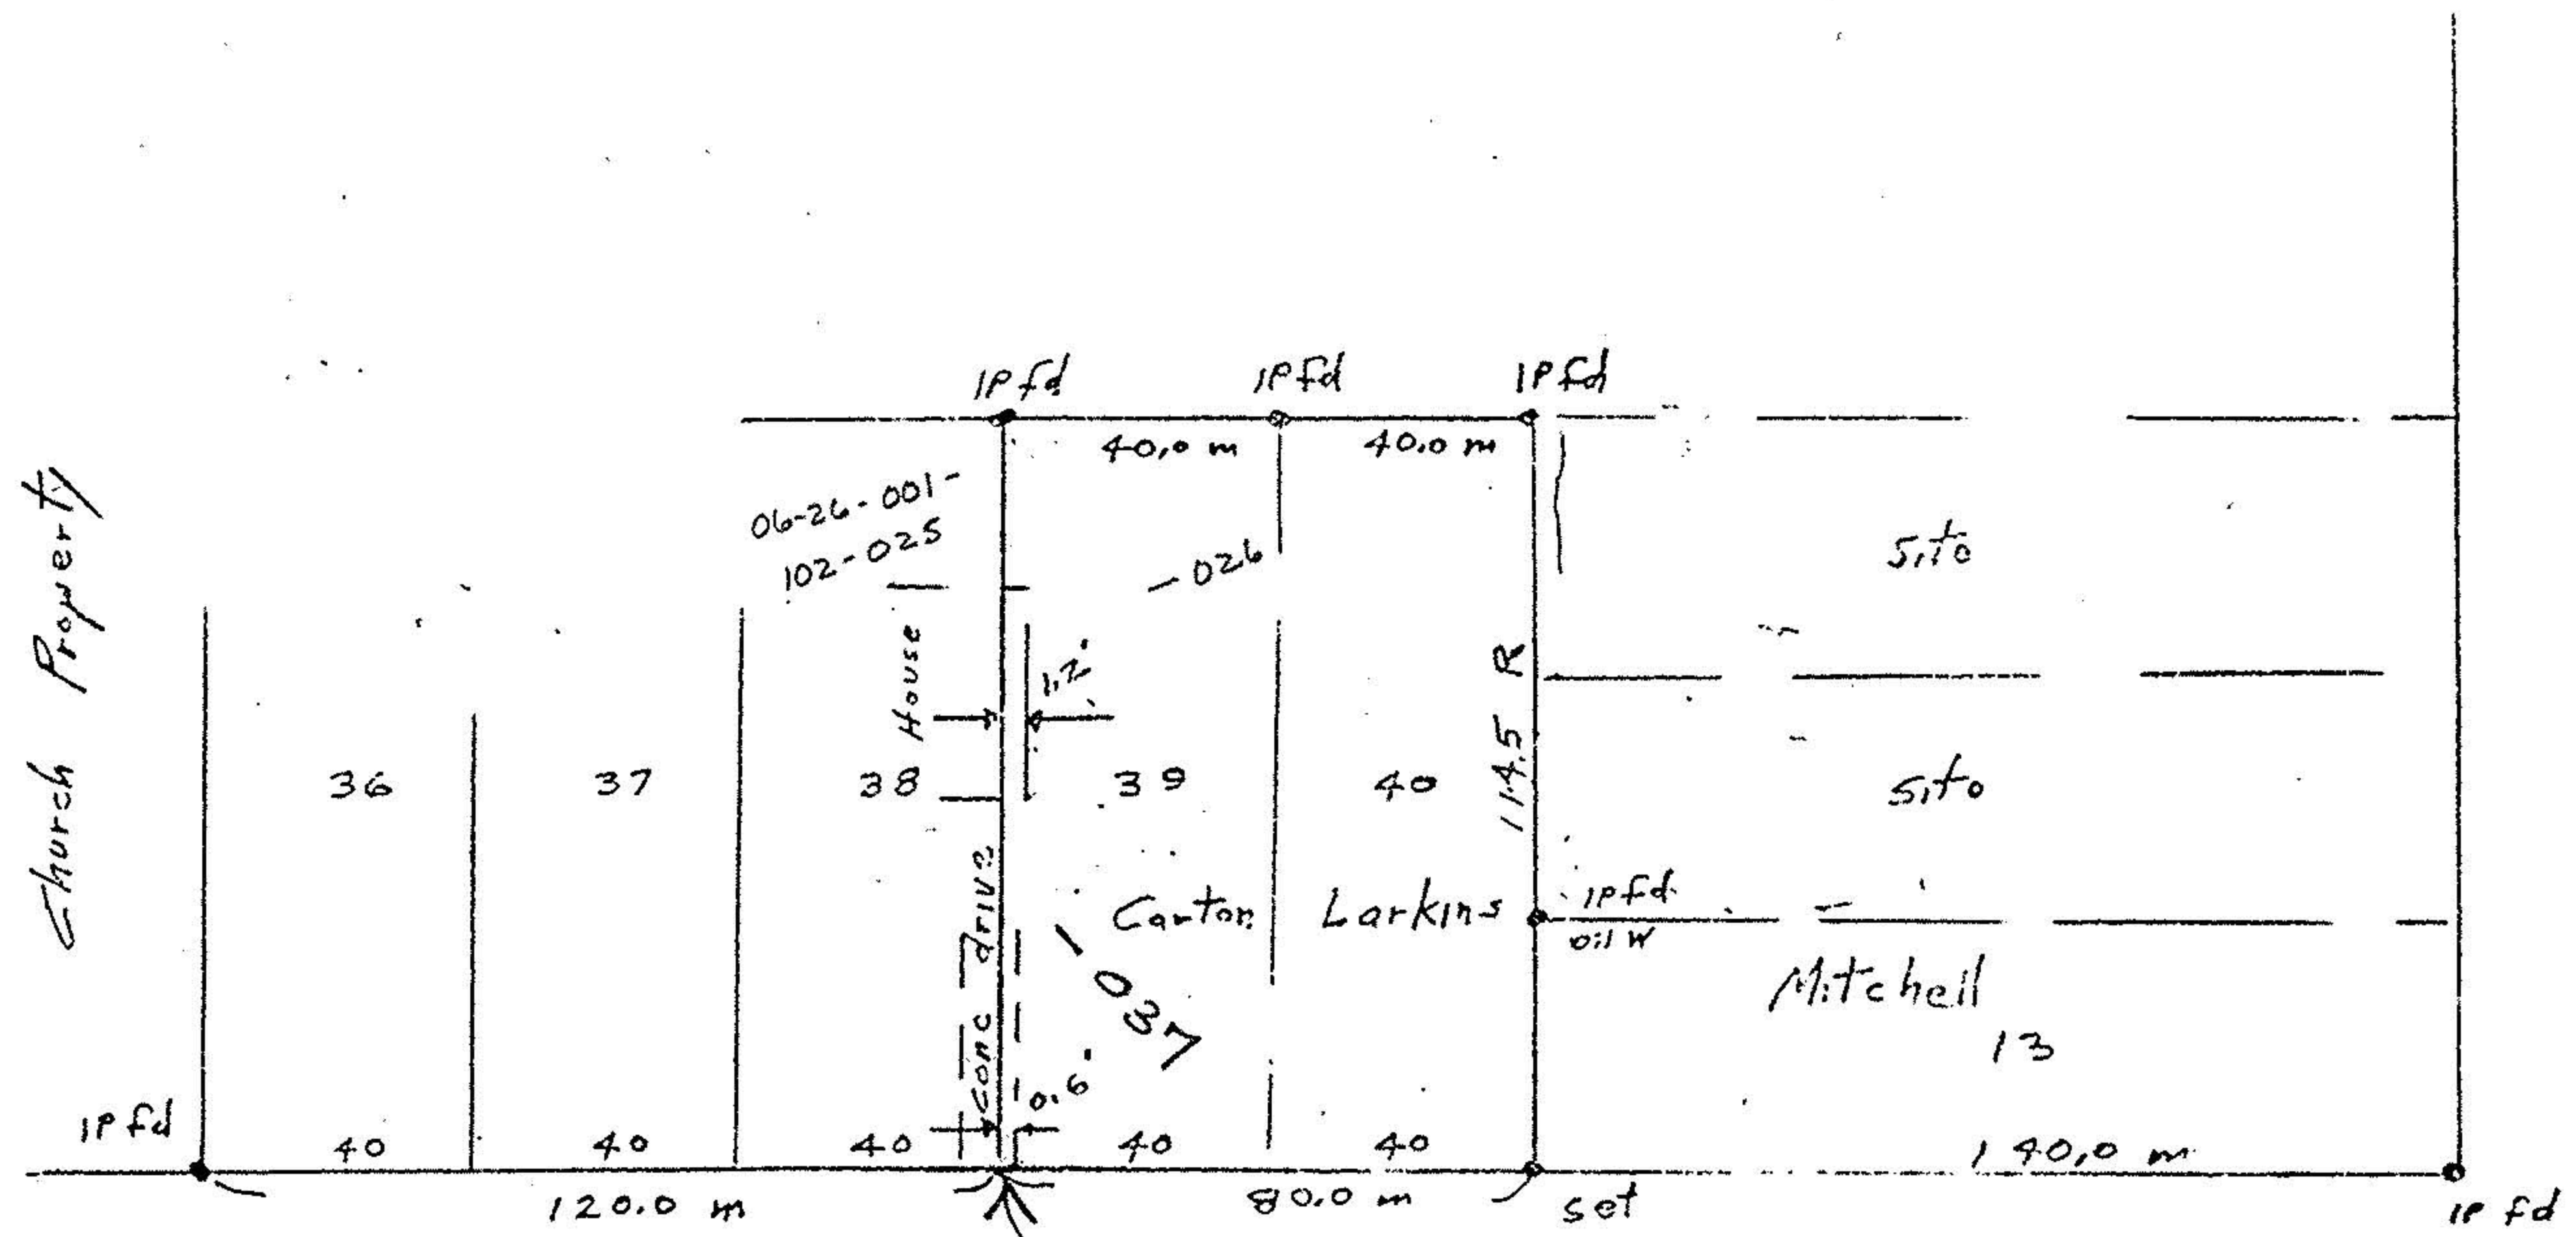

N

#16932

APPROVED	
LORAIN CO.	
MAP DEPT.	
DATE	8-11-86
PAGE	6-137
BY	C. FRANCIS
VOID AFTER	16932

Scale 1" = 40'

16th St
036

John Poznyurak
P.S.I. # 5292

Survey of sublots 39, 40
Mussey Ave All't P. Vol 8 Pg 49
Part of original Lot
Between the Black River's
City of Elyria
Lorain County Ohio
Scale 1" = 40' July 11, 1985