

06-26-014-10

138

AVE - 99

GATES

AVE 50


787.60 meas
787.00 Rec.

Cross
95.00

102

MIDDLE

239.30 record
237.73 meas

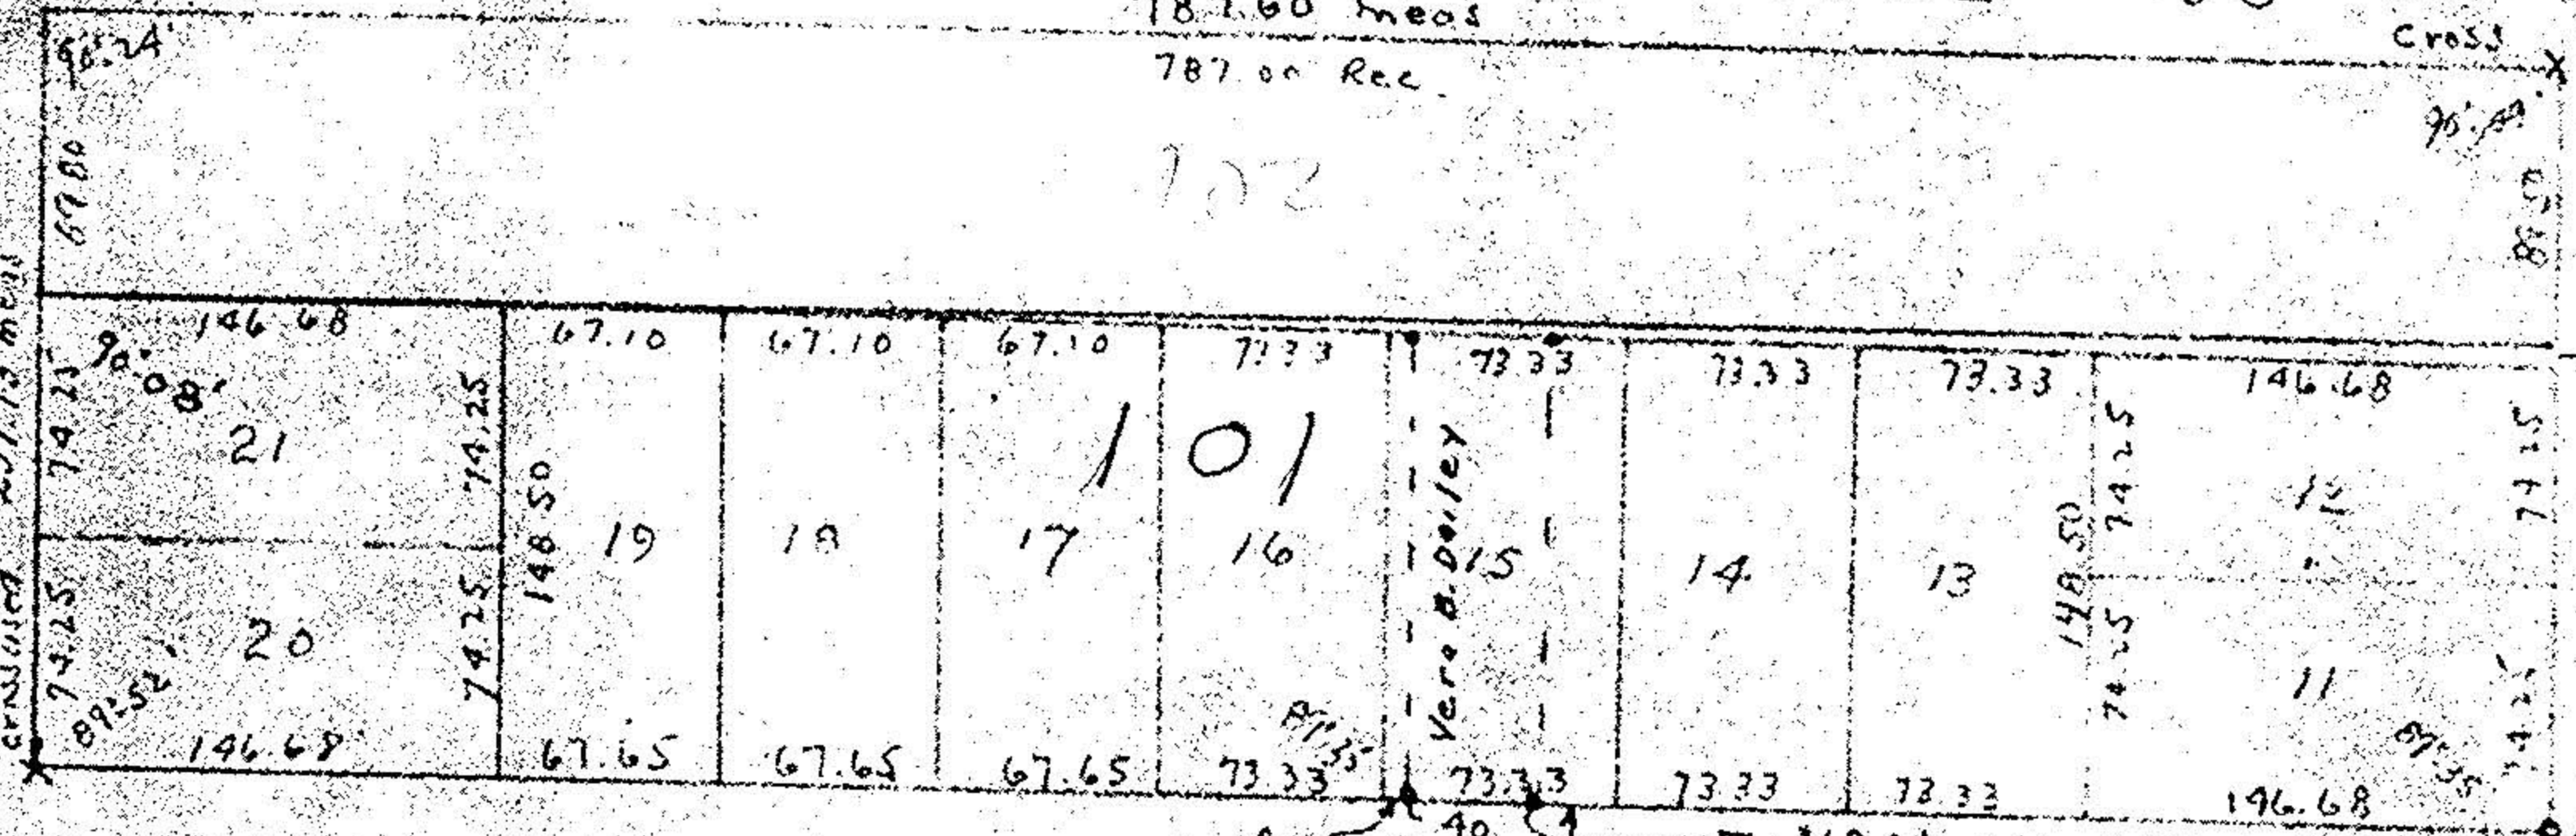

HOWE

787.63 meas
789.75 meas

ST 66

Vol 2 - Pg 8 A D Howe's Addition
Scale 1" = 100'

Copy of survey made for Vero B. Darley
By Warden & Landon
June 15-1920

3

EAST