


o iron pipes fd
 X PK nails set
 in Blacktop
 John Poznywak
 Reg Surveyor
 5292

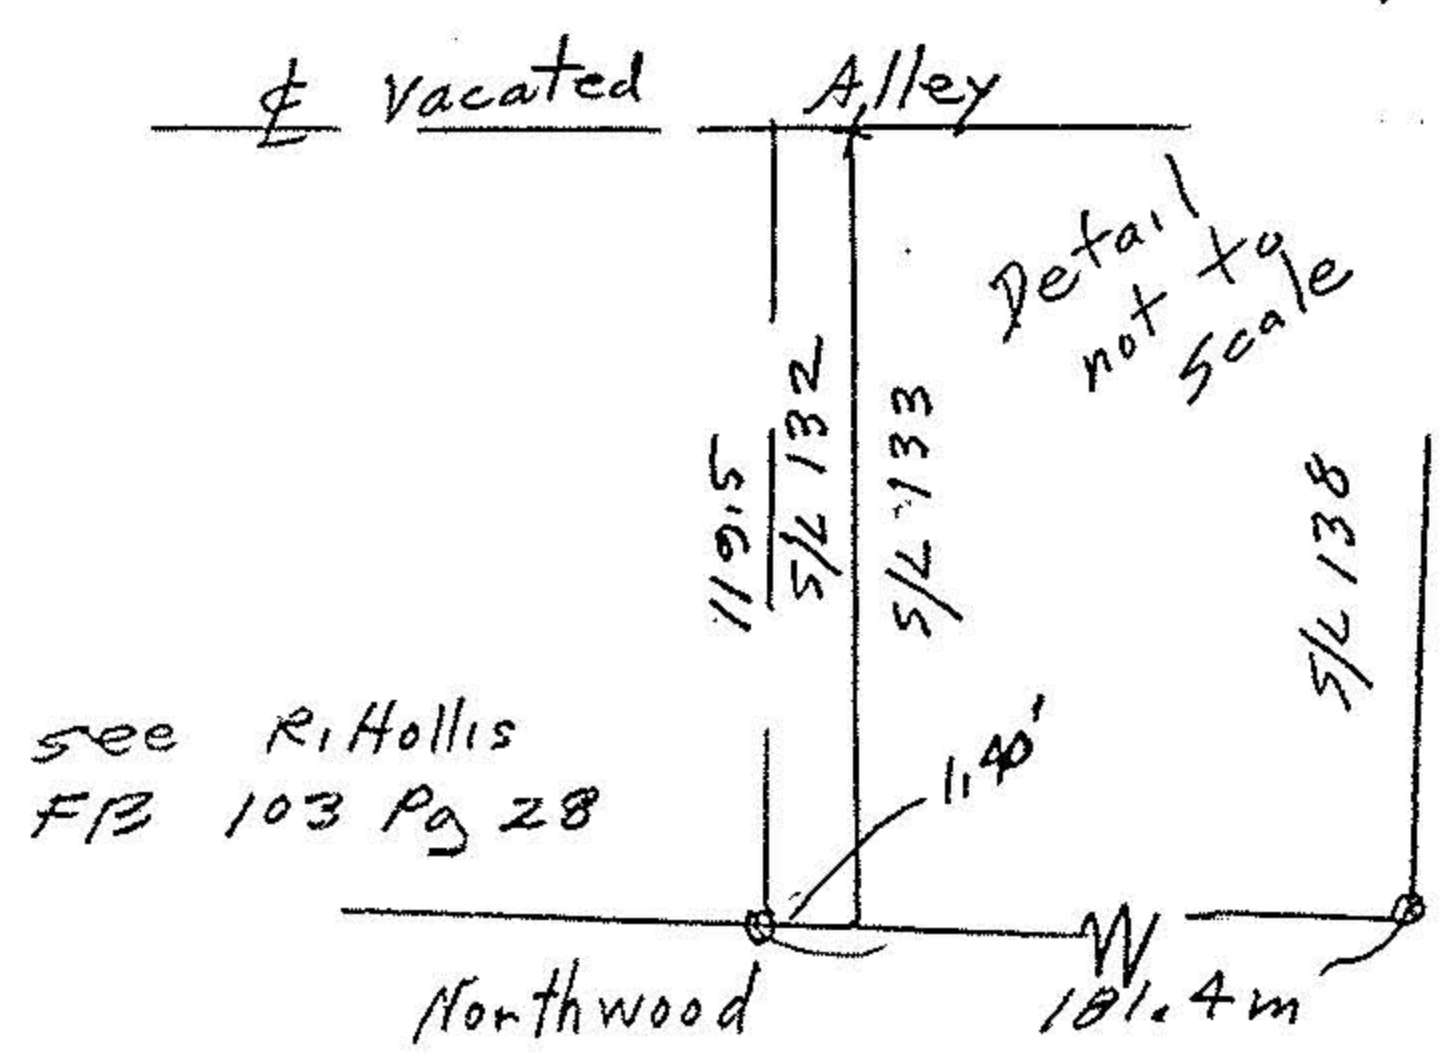

see R. Hollis
 FB 103 Pg 28

Survey for
 Irene Hampton
 sublots 125-132
 Clearview Subdivision
 P. Vol 10 Pg 8
 Original 18
 Burrell and Day Tract
 Elyria Township
 Lorain County Ohio
 Scale 1" = 50 May 21, 1995