



APPROVED
 LORAIN CO.
 MAP DEPT.
 DATE 7-29-96
 PAGE 6-8
 BY K.DYE
 VOID AFTER # 21858

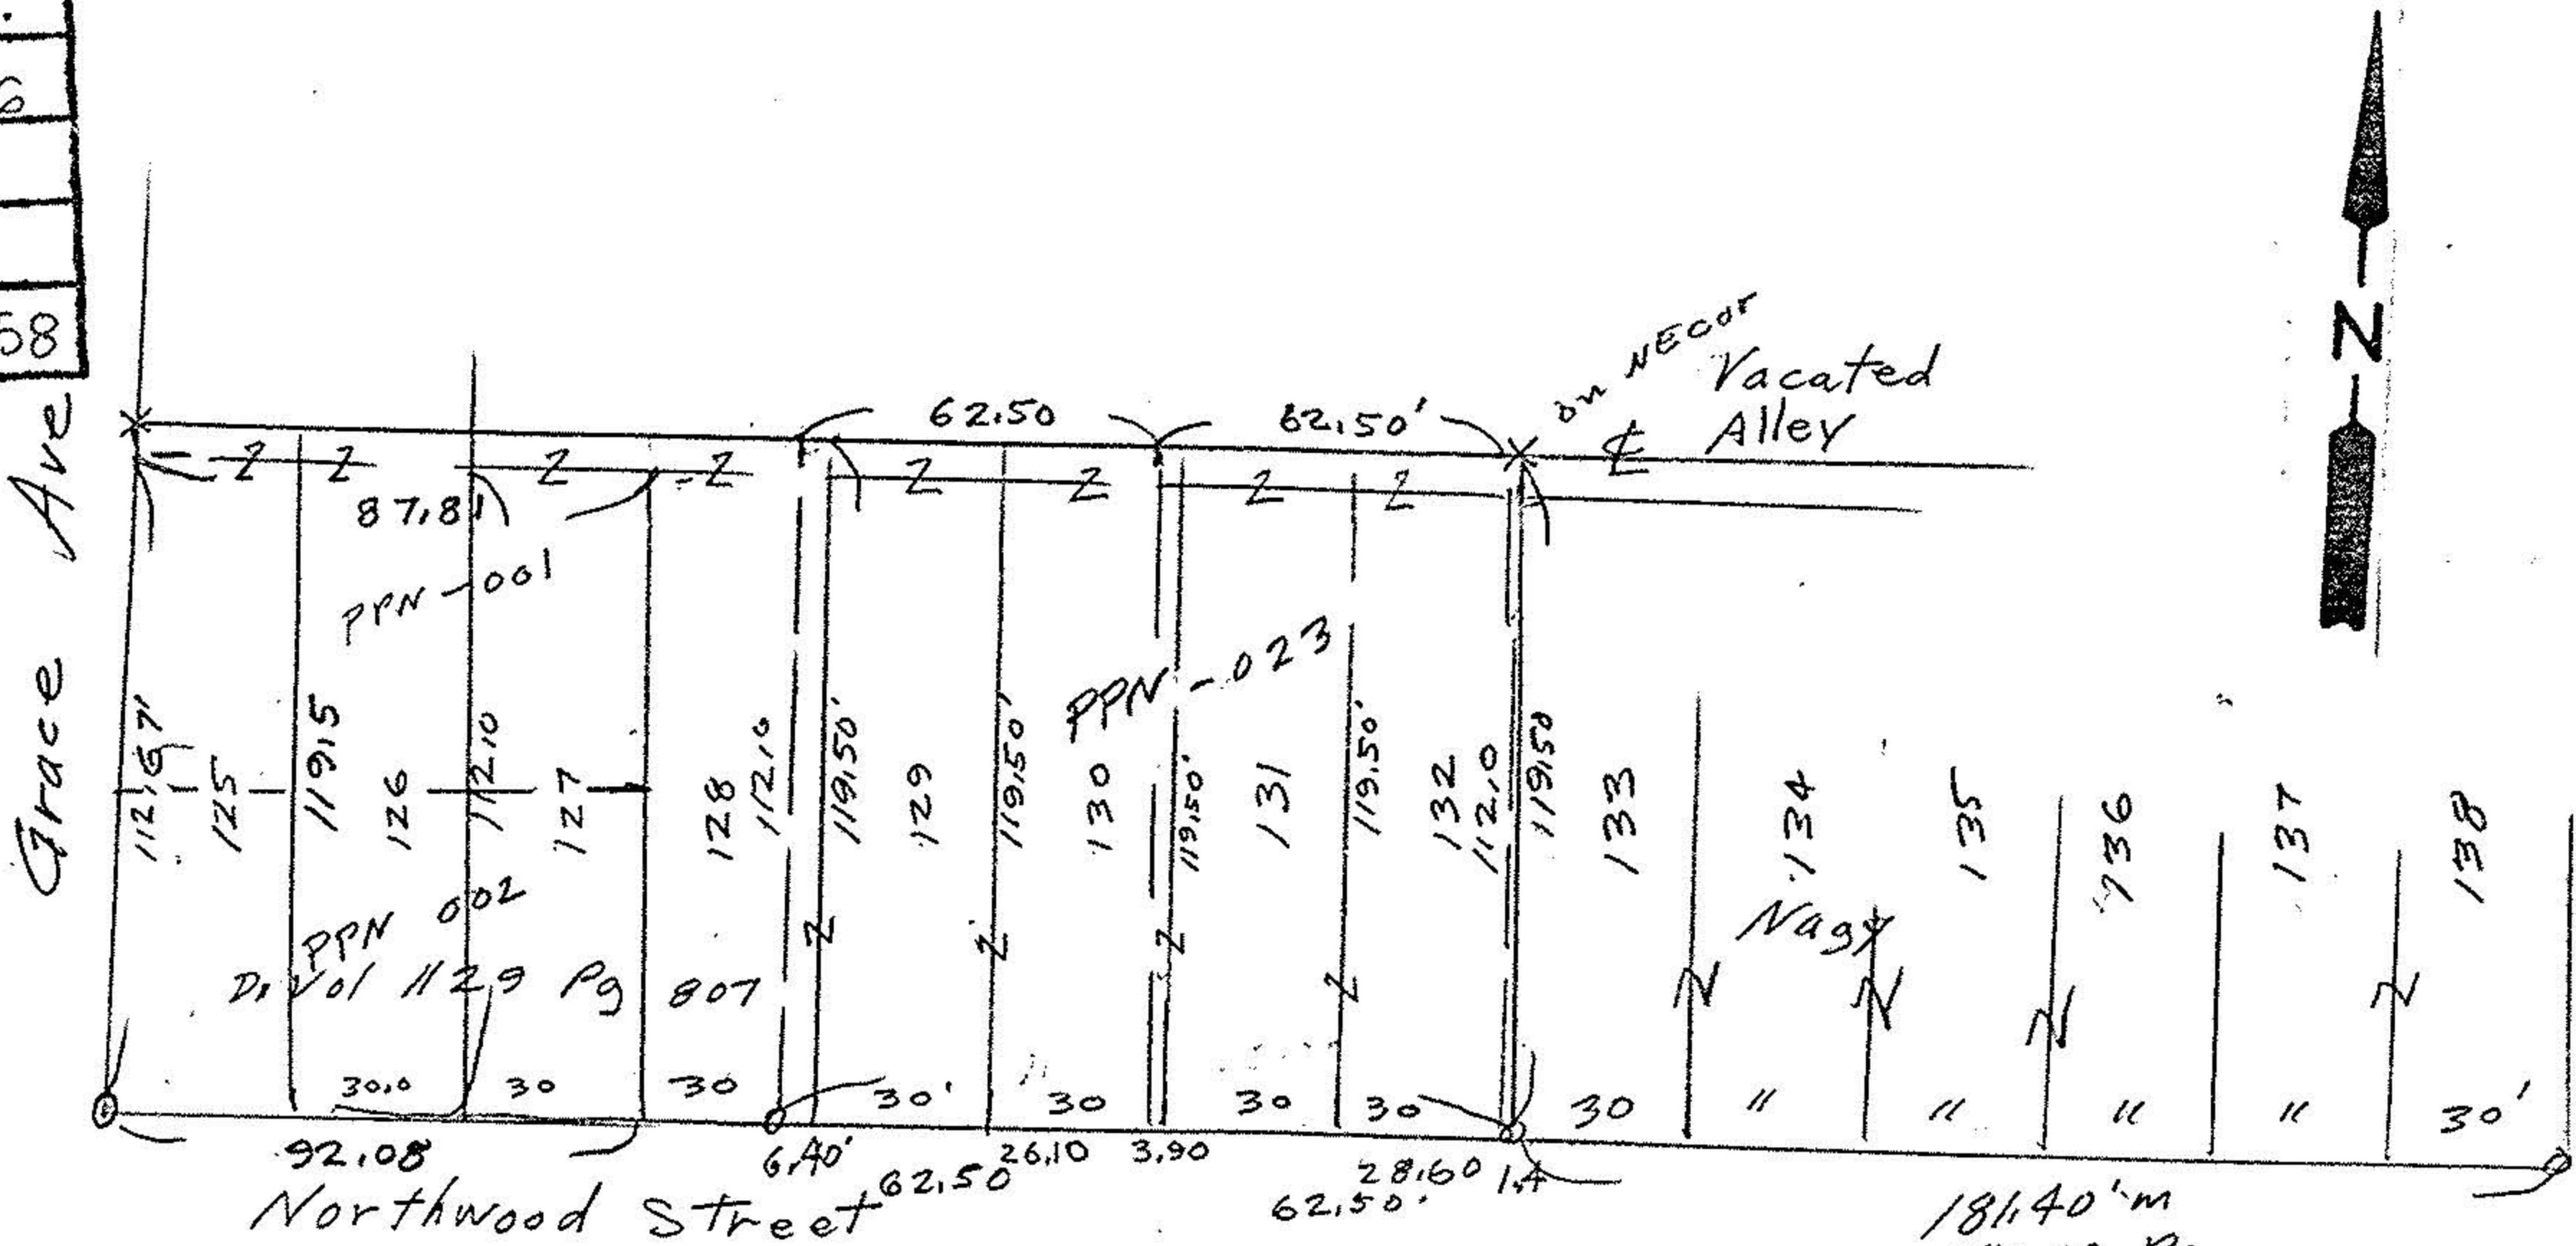

o iron pipes fd
 X PK nails set
 in Blacktop

John Pozywak
 Reg. Surveyor of Ohio
 JOHN POZYWAK
 5292 REGISTERED SURVEYOR

see R. Hollis
 FB 103 Pg 28

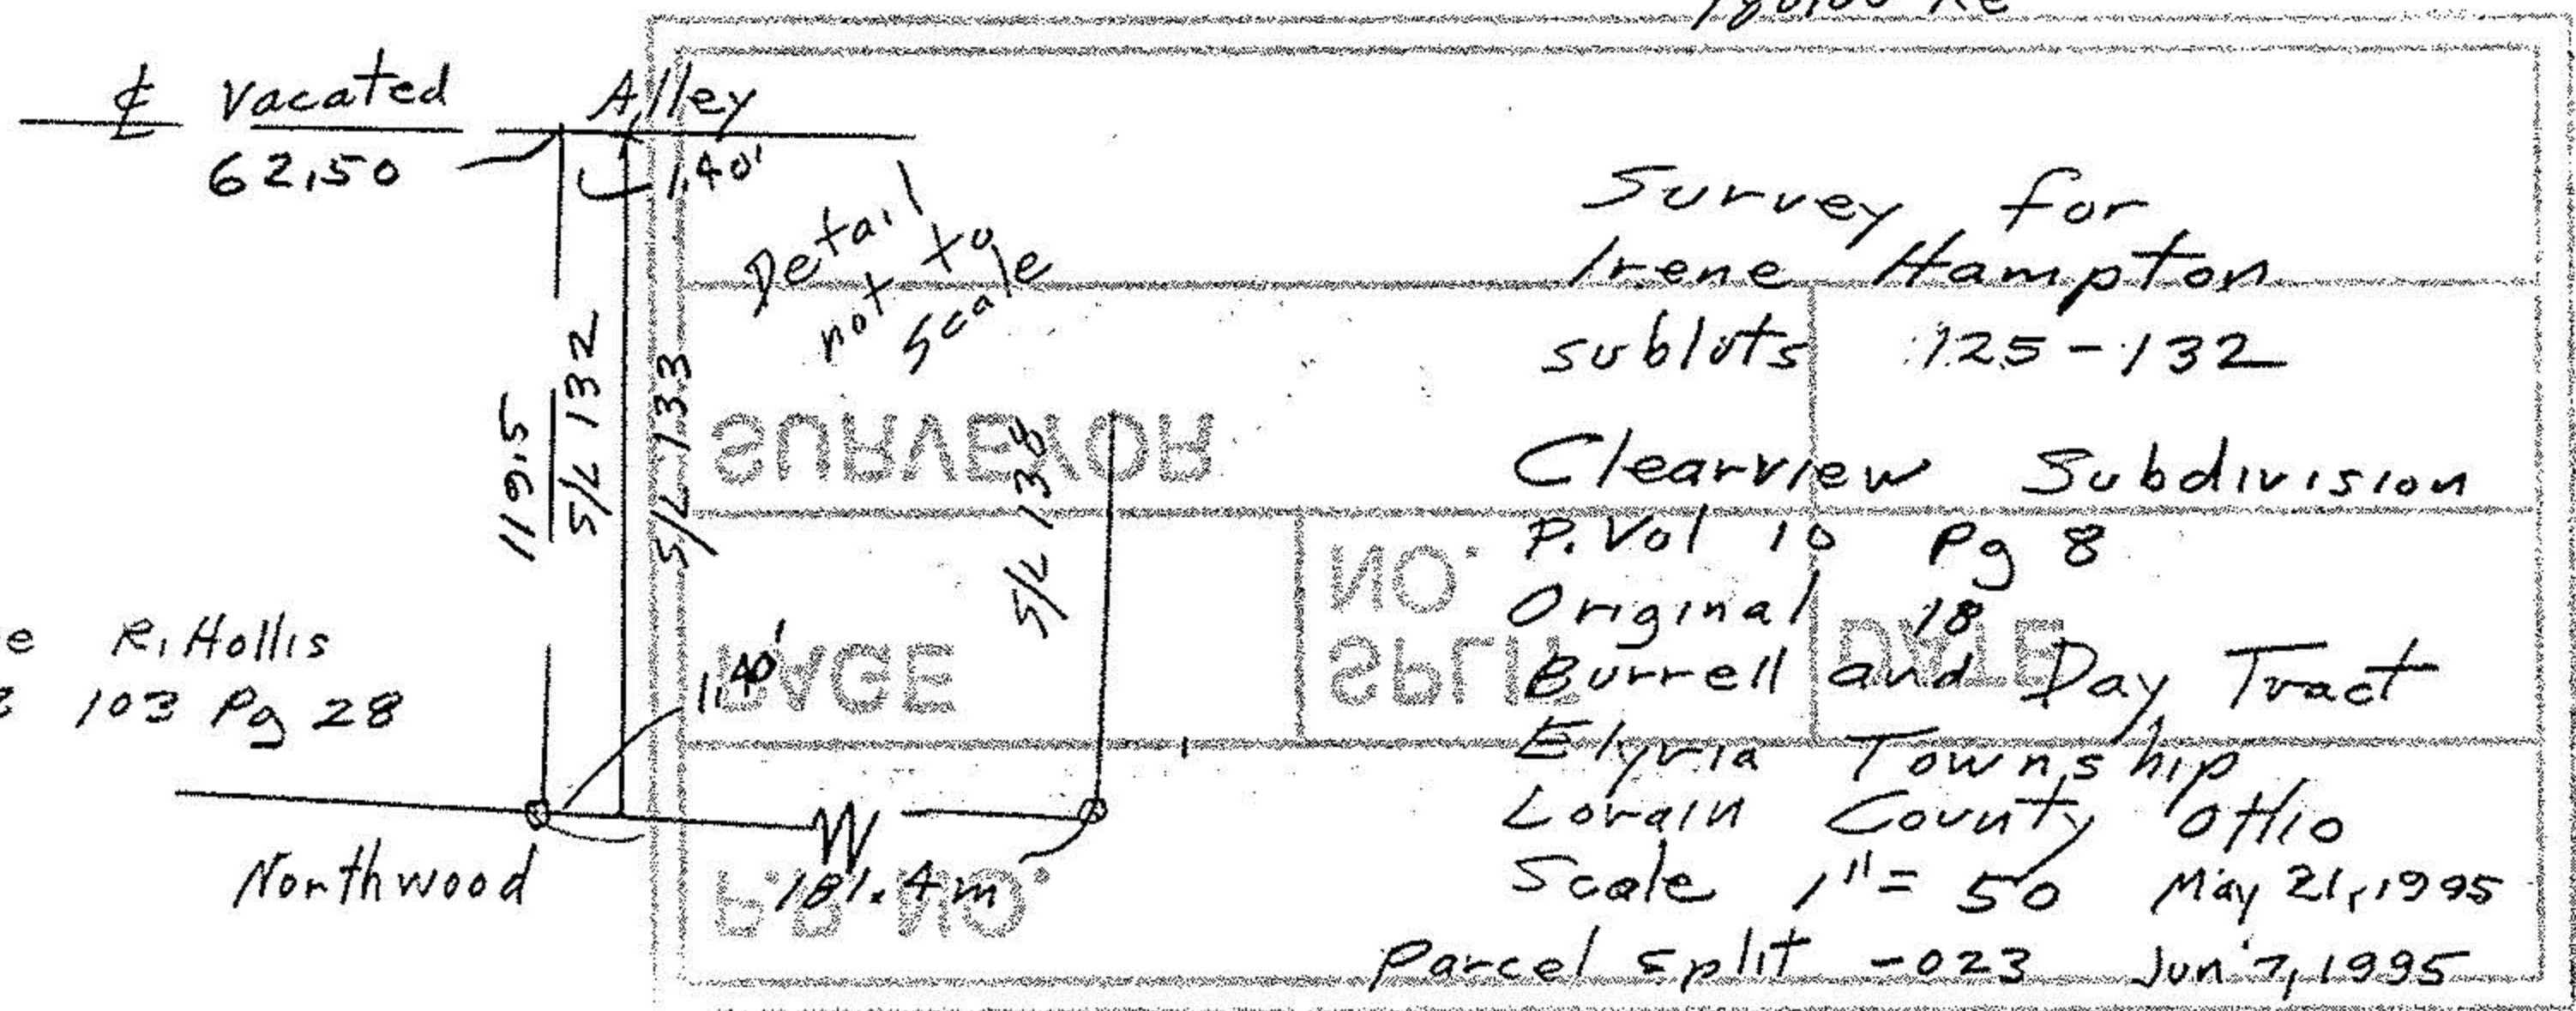

Survey for
 Irene Hampton
 sublots 125-132
 Clearview Subdivision
 P. Vol 10 Pg 8
 Original 18
 Burrell and Day Tract
 Elyria Township
 Lorain County Ohio
 Scale 1" = 50' May 21, 1995
 Parcel split -023 Jun 7, 1995