

PASADENA AVENUE 80 FT.



06-23-176-105-004

105.0'

Blain & Rita Sprague
80'
354

207.00'

John & Ita Mahnke


353

295.0'

Donald Halpin

352

Albert Haag
78'
351

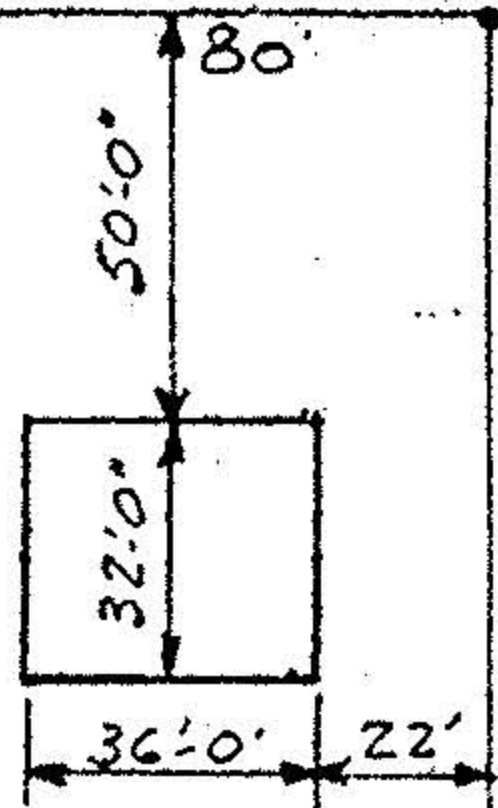

107.63'

118.93

W.J. & Nancy D. Parsons

92°45'

80.09'

84.48'

MAP OF SURVEY FOR.

John & Ita Mahnke

SUB-LOT 353 SPRING VALLEY

SUB'N NO 4 Q. 31 & 176

ELYRIA TWP. EAST OF BLACK RIVER,

LORAIN COUNTY OHIO

Scale 1" = 50' July 22-1950

C.E. Penfound Reg. Surveyor

16