

SURVEY


Sublot(s) _____
 Subd'n _____

Township ELYRIA Tract BRACE
 Orig. Lot(s) 19 Sec. _____
 County of LORAIN State of Ohio _____
 Corporation CITY OF ELYRIA

#16688
 APPROVED
 C. FRANCIS
 4-16-86
 6-30-81
 VOID AFTER

06-23-019-000
 16688
 0-4-19
 T-23

D.V. 568 P. 367
 THEODORE D. JURCZYNSKI

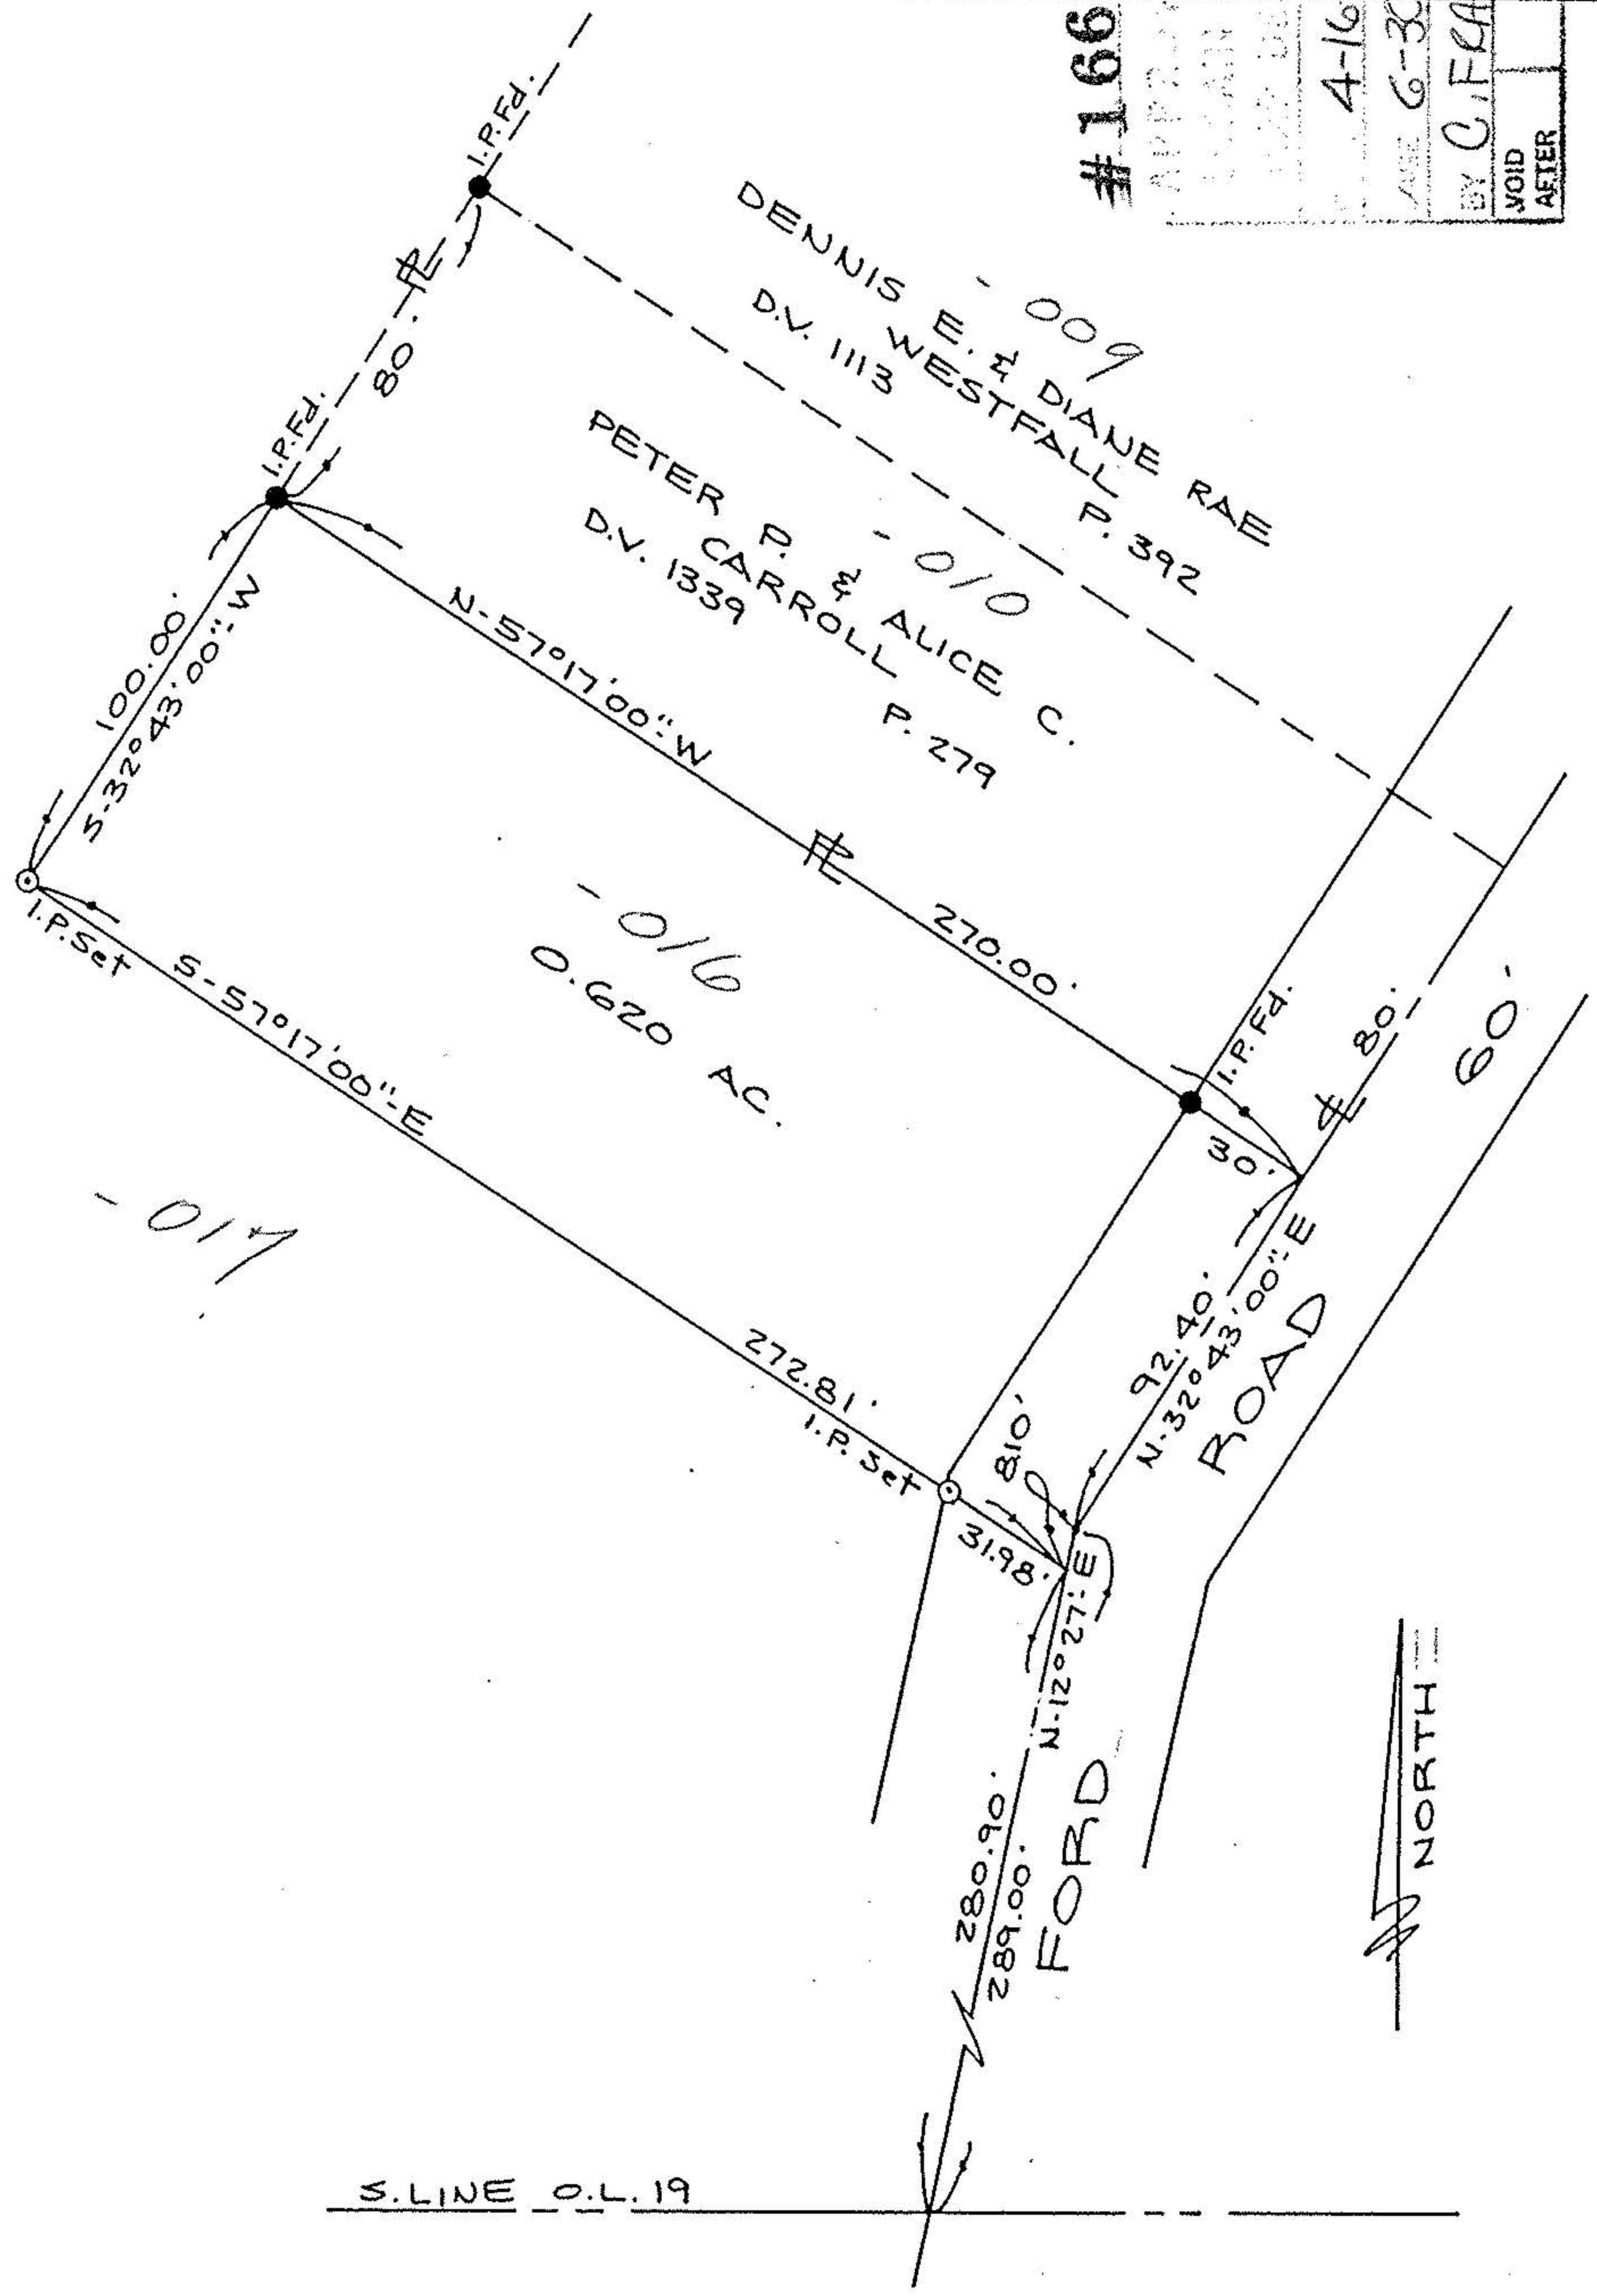

Prepared for: THEODORE JURCZYNSKI
 1460 FORD RD. ELYRIA, OHIO

Scale: 1" = 50' | Date: 3-30-86 | Dr. by: D.E. | Job No: 86-48