

6-40 7.23


330.00  
300.00

630.00

955.21

630.00

325.21

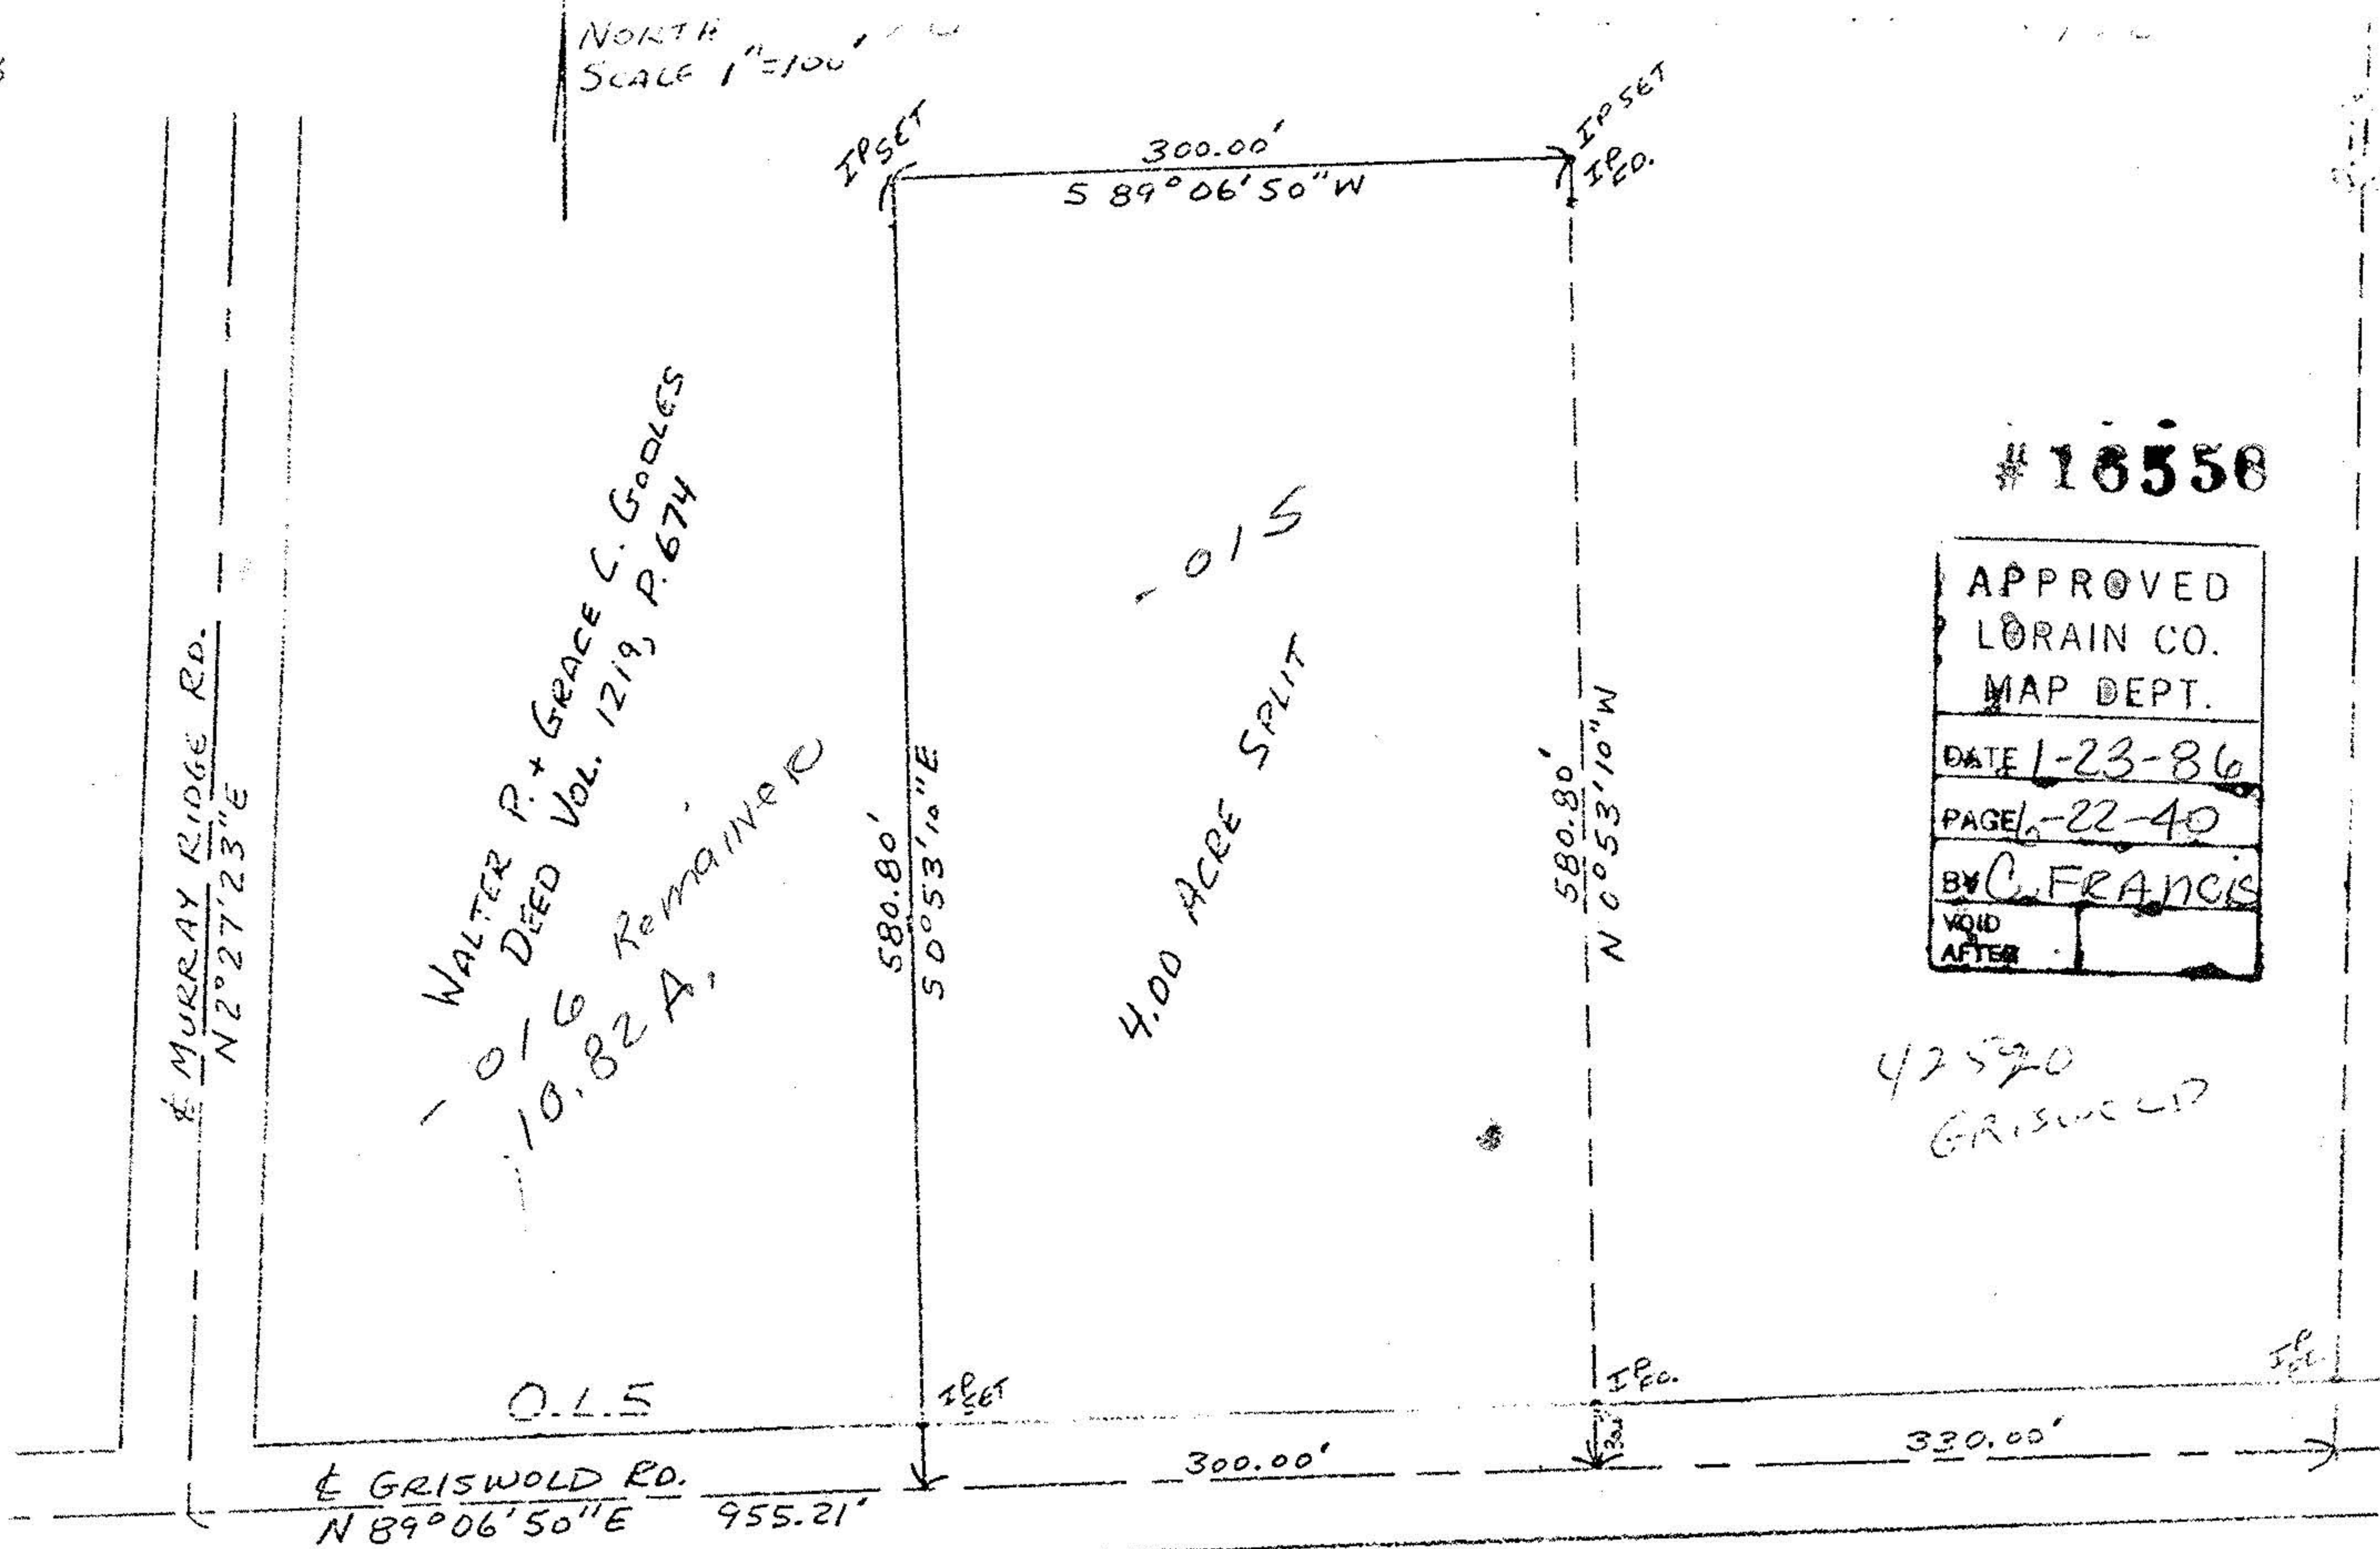

#16558

APPROVED  
LORAIN CO.  
MAP DEPT.

DATE 1-23-86  
PAGE 6-22-40

BY C. FRANCIS

VOID  
AFTER


42580  
GRISWOLD

42580 GRISWOLD RD

MAP OF SURVEY FOR W. GODLES  
D.L. 5 BEACE TRACT - ELYRIA TWP.  
LORAIN COUNTY AUG. 1985  
JOHN R. HAMILTON REG. SURV. #6861

This Line does Not match  
TAX MAPS.  
MURRAY RIDGE &

WALTER P. GRACE C. GODLES  
Decd Vol. 1219, P. 674

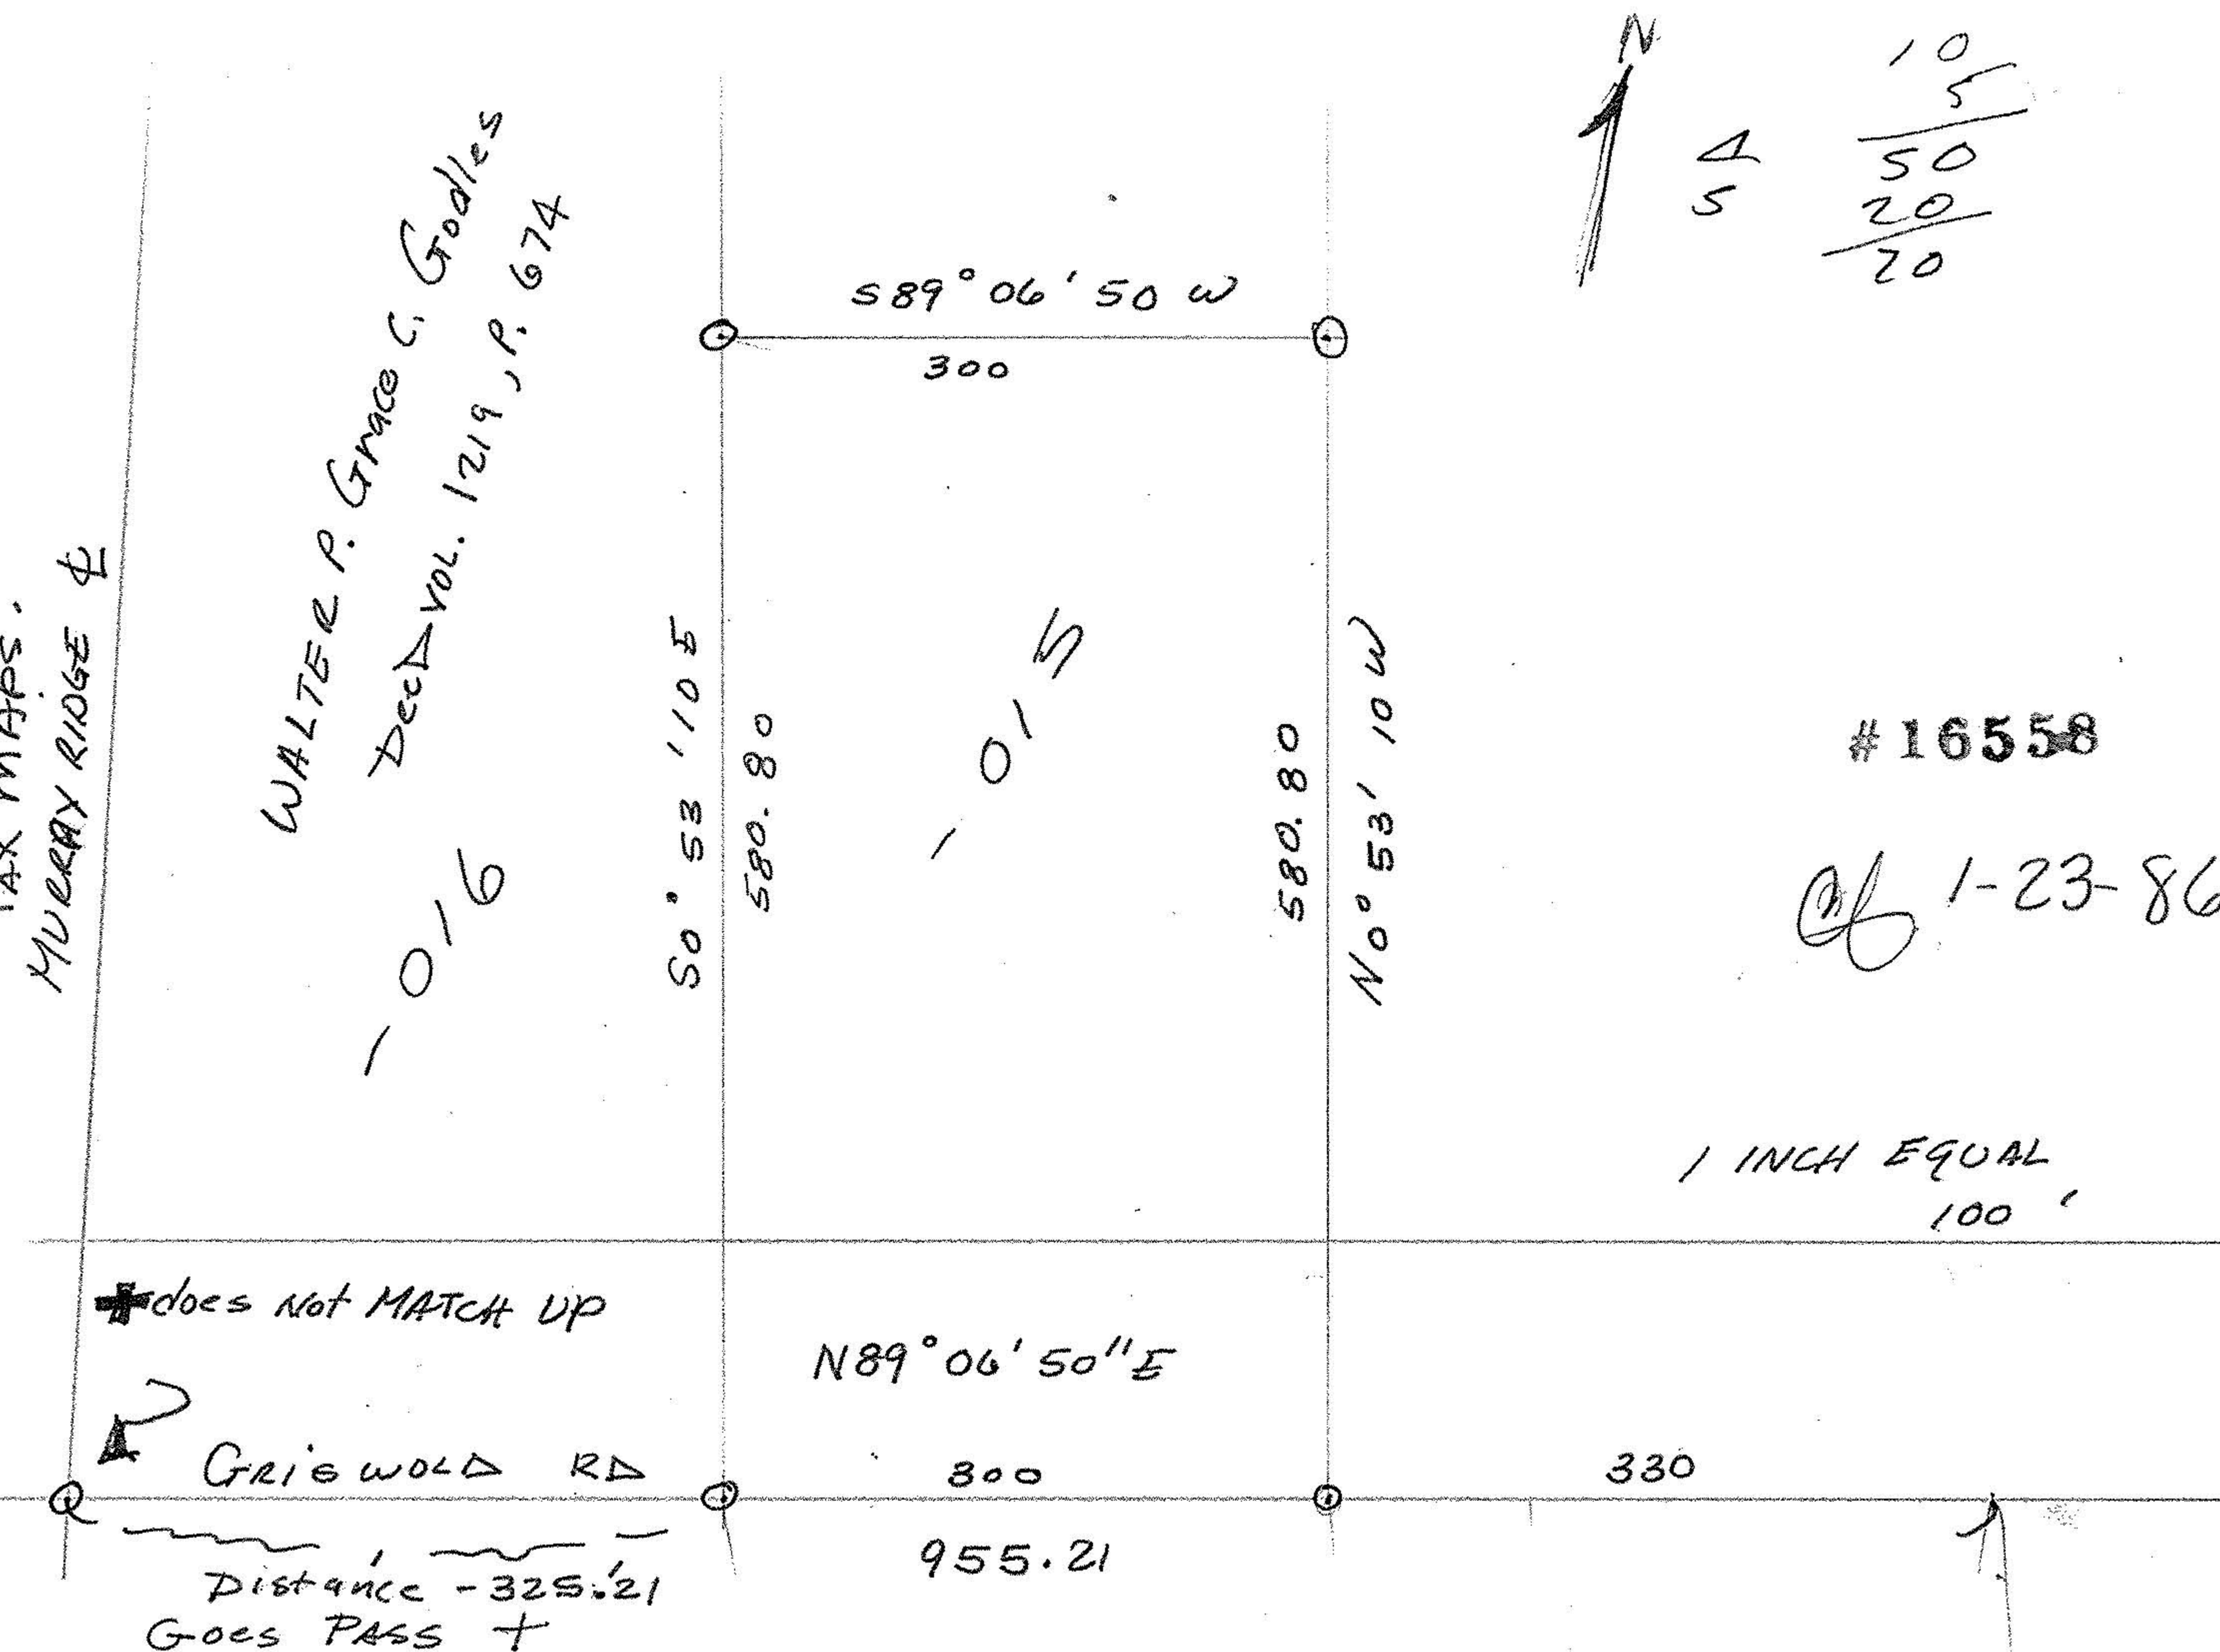

10  
5  
50  
20  
20

#16558

1-23-86

1 INCH EQUAL  
100'

✦ does not MATCH UP

GRISWOLD RD

Distance - 325.21  
Goes PASS ✦