


**SURVEY**

Sublot(s) \_\_\_\_\_  
 Subd'n \_\_\_\_\_

Township ELYRIA Tract BRACE  
 Orig. Lot(s) 1 Sec. \_\_\_\_\_  
 County of LORAIN State of Ohio  
 Corporation \_\_\_\_\_

06-23-001-103

#16467

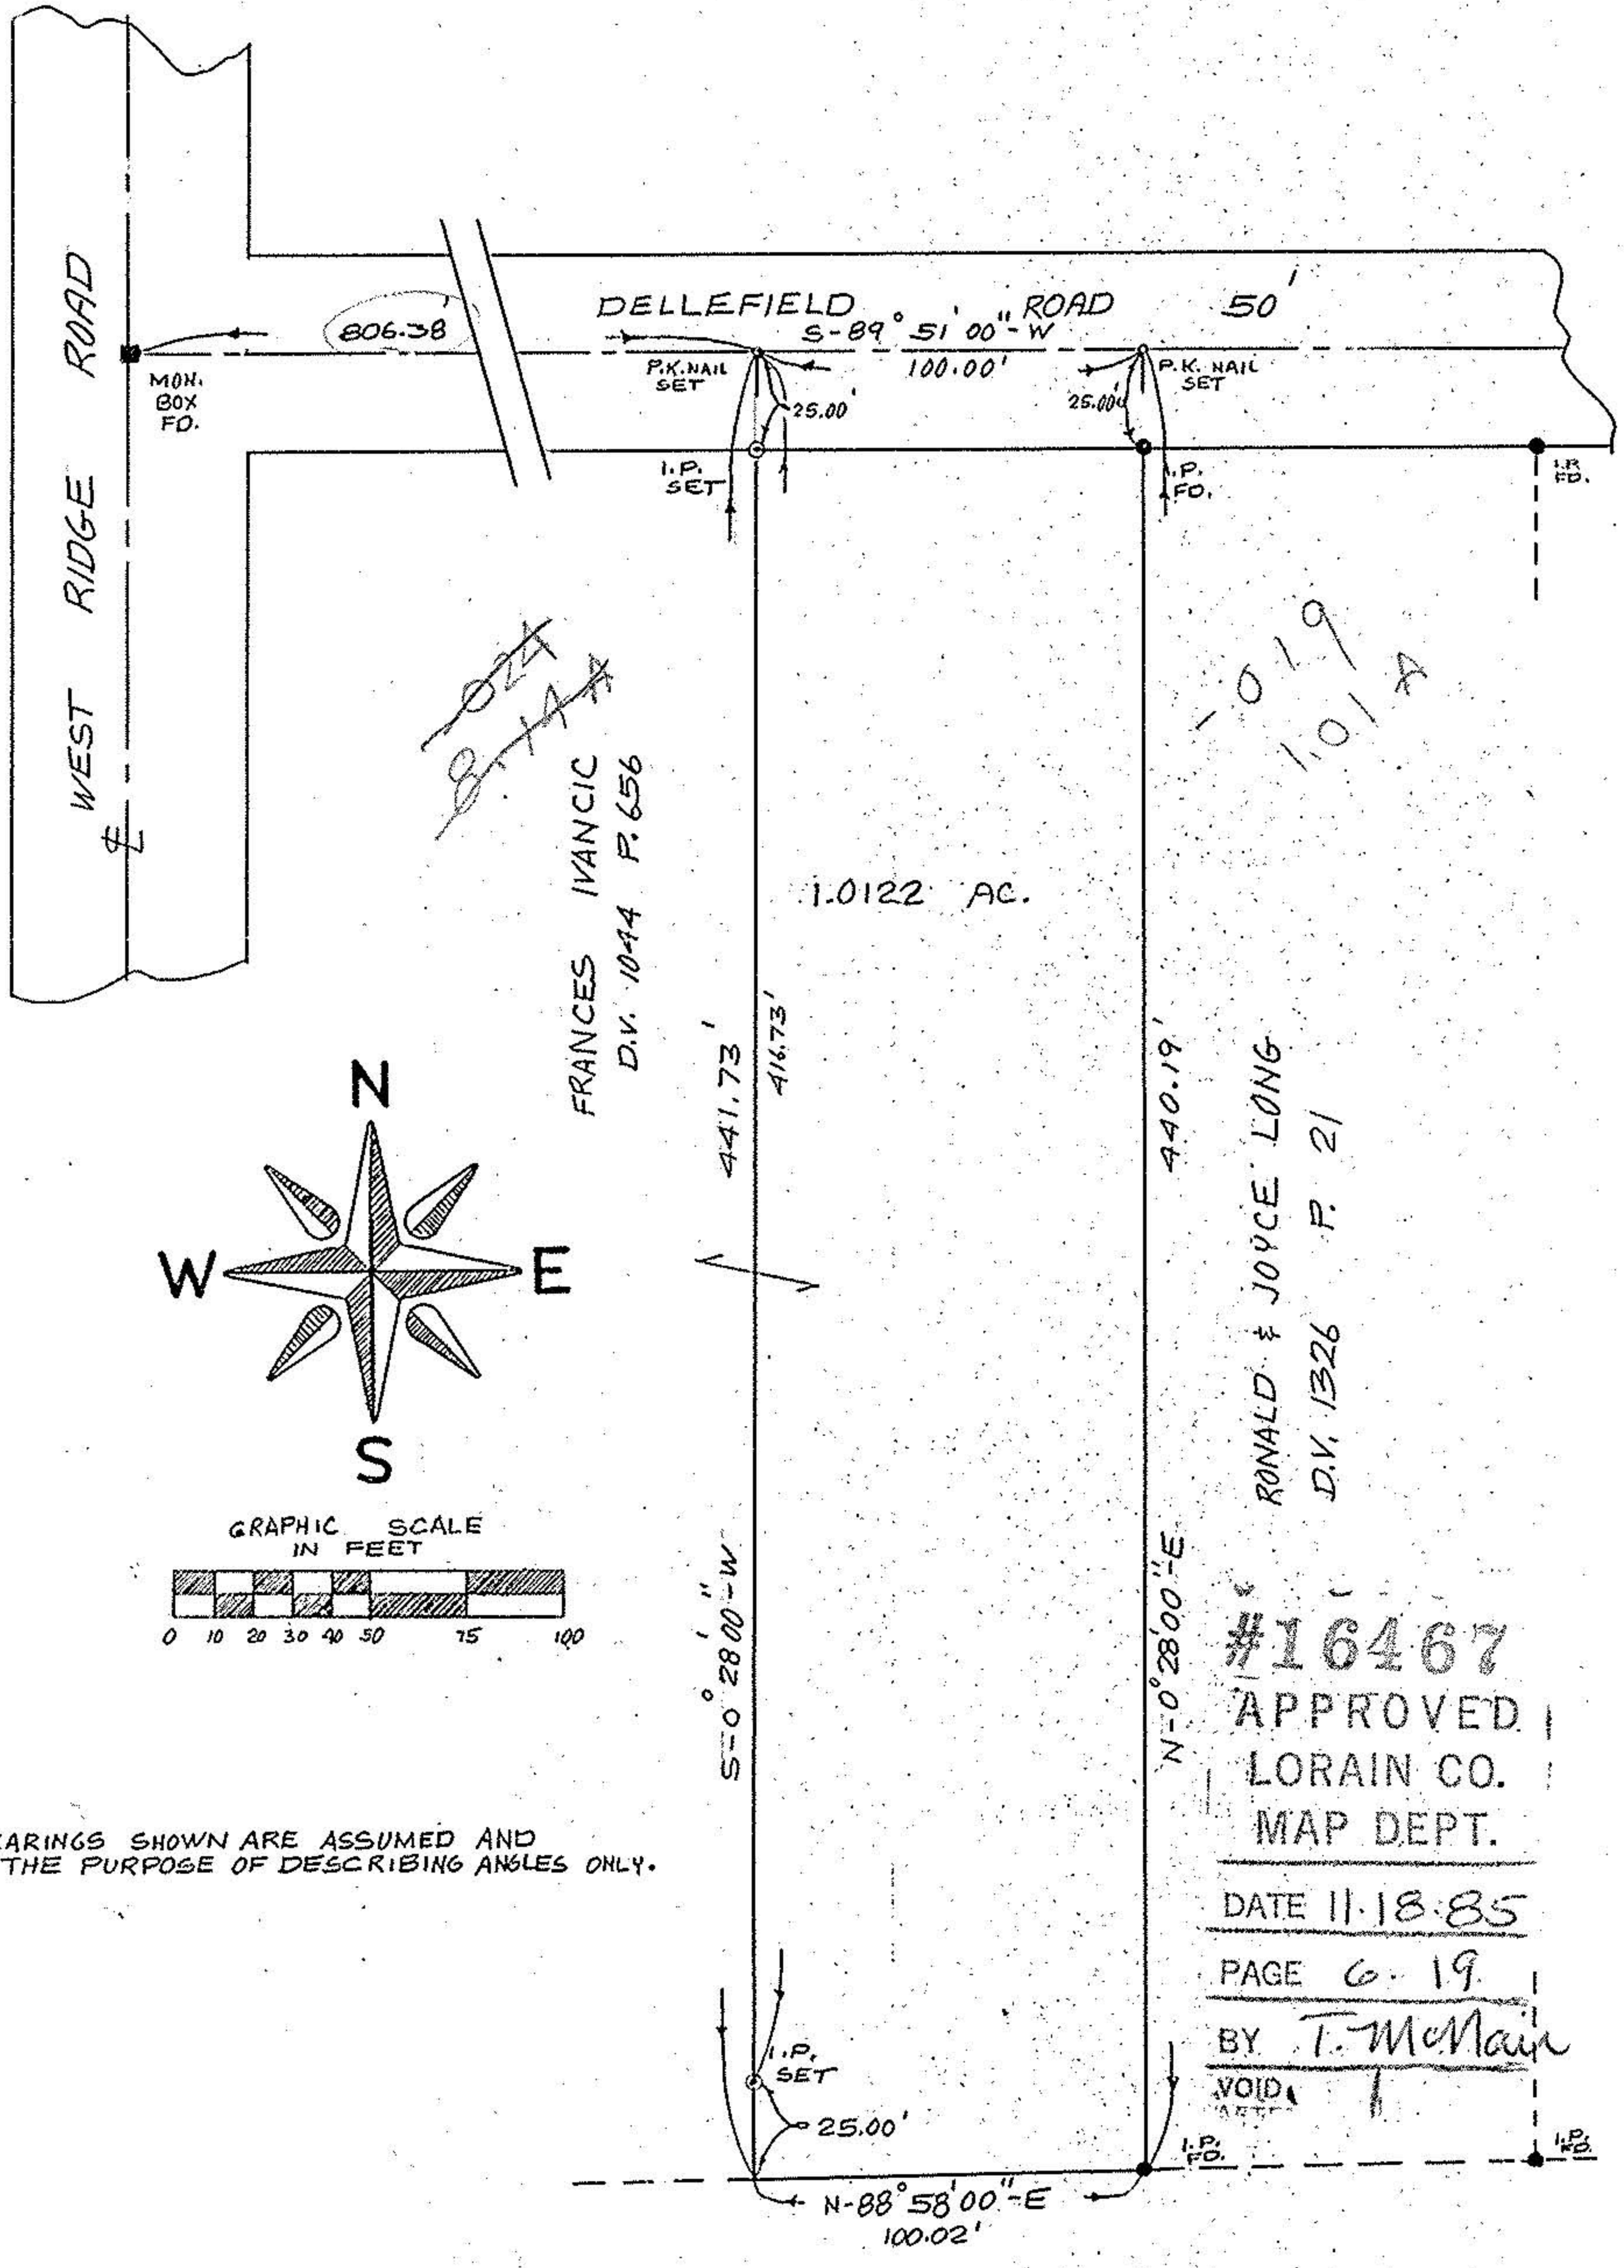

NOTE: BEARINGS SHOWN ARE ASSUMED AND ARE FOR THE PURPOSE OF DESCRIBING ANGLES ONLY.

#16467  
 APPROVED  
 LORAIN CO.  
 MAP DEPT.

DATE 11-18-85  
 PAGE 6-19  
 BY T. McNamee

VOID 1

Prepared for: WILLIAM J. IVANCIC

6-19