


06-24-005-000-

1000 COLUMBIAN TWP. E.

No. line OL 5



Kenneth A Crawford

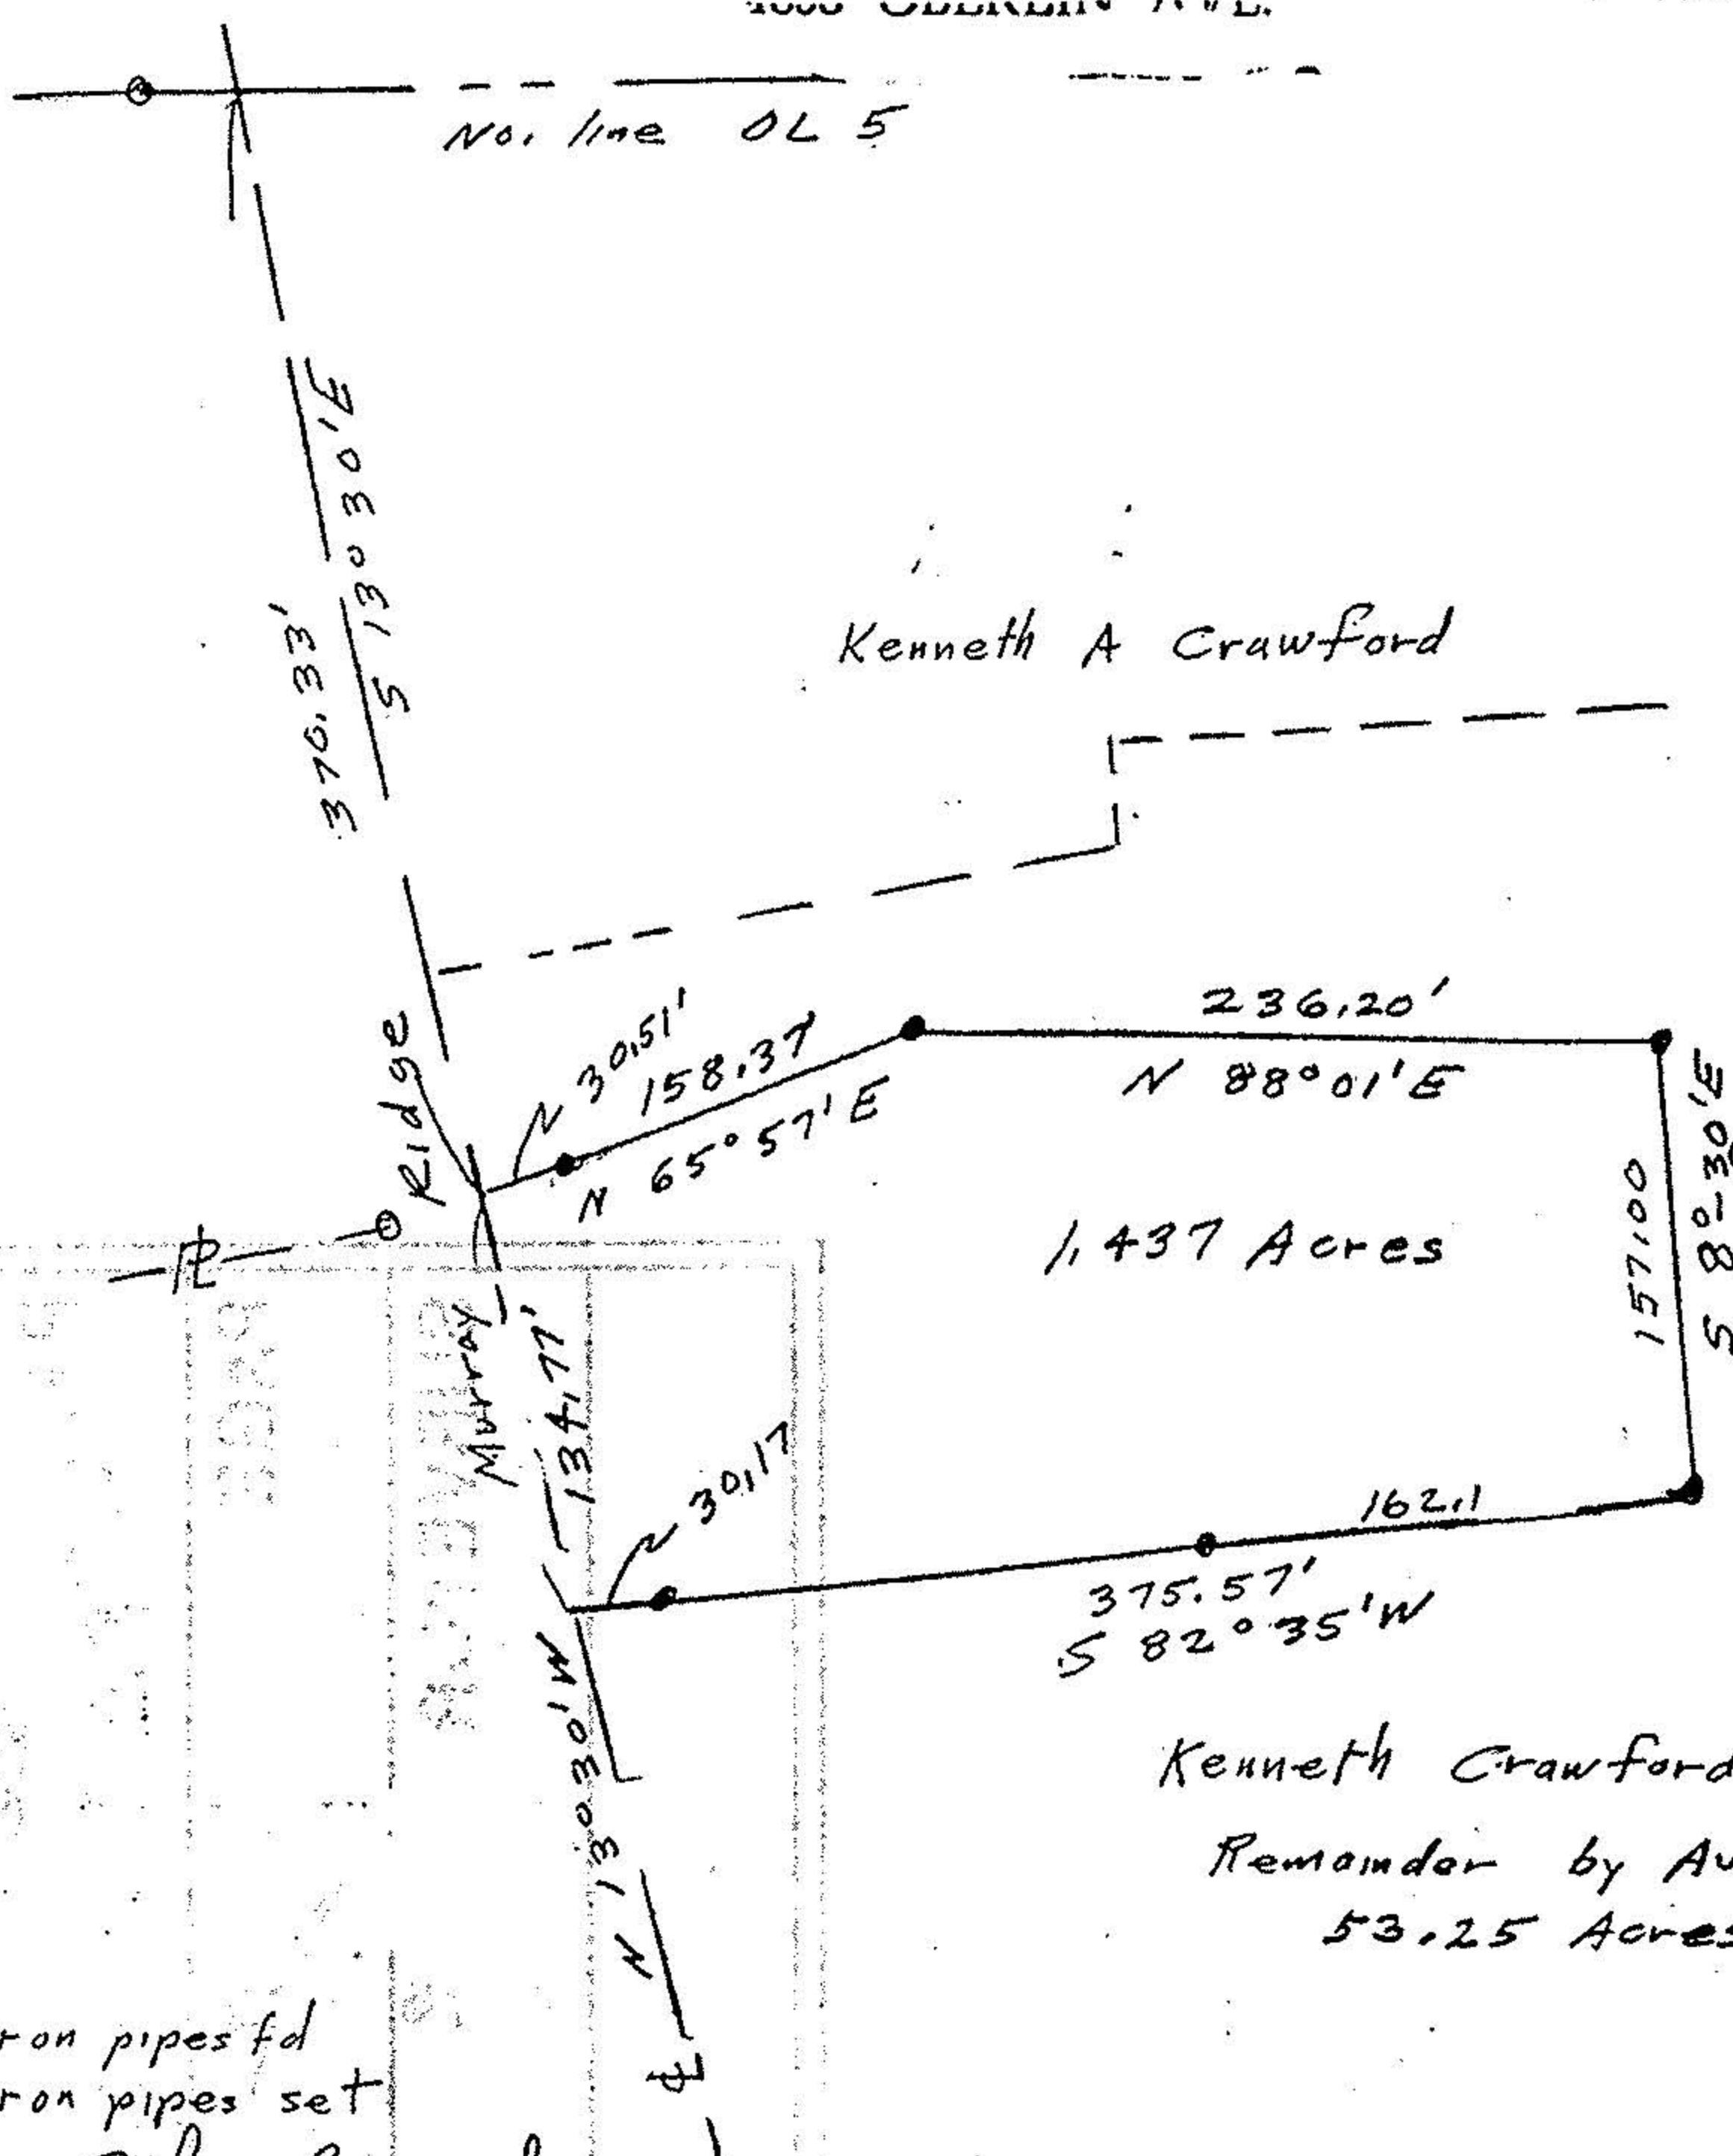

5-18-94  
20860  
VOID 20408

APPROVED
LORAIN CO
MAP DEPT
DATE 6-30-93
PAGE 6-130, 131
BY CAROLYN FRANCIS
VOID AFTER # 20409


Kenneth Crawford

Remainder by Auditor  
53.25 Acres

Kenneth Longford

- o iron pipes fd
- o iron pipes set

John Poznywak  
Reg Surveyor  
5292

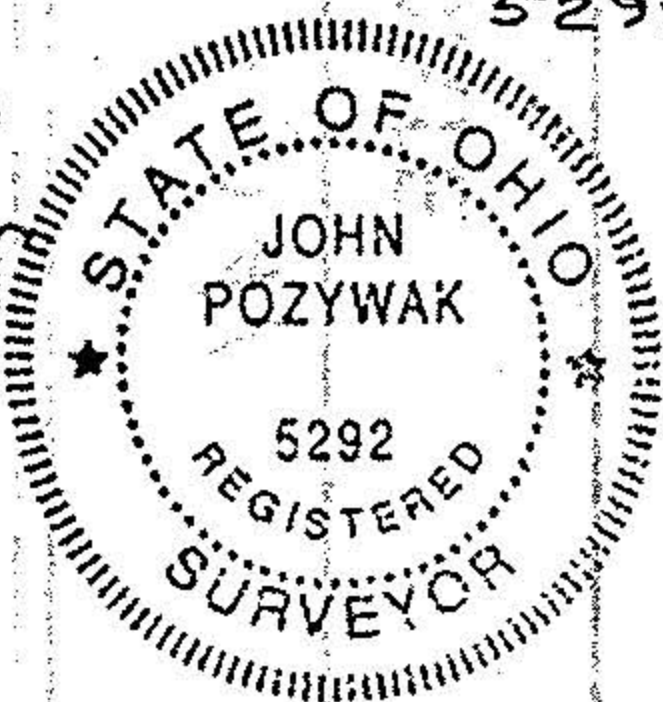

ORIGINAL LOT 5 West of BR DATE Apr 30, 1993  
 TOWNSHIP Elyria SCALE 1"=100'  
 CITY OF \_\_\_\_\_ FIELD BOOK N/A  
 COUNTY OF Lorain DRAWN BY J. Poz  
 STATE OF OHIO CHECKED BY \_\_\_\_\_  
 W. O. \_\_\_\_\_ FILE NO. 06-24-004

6-130 131

06-24-005-000-