



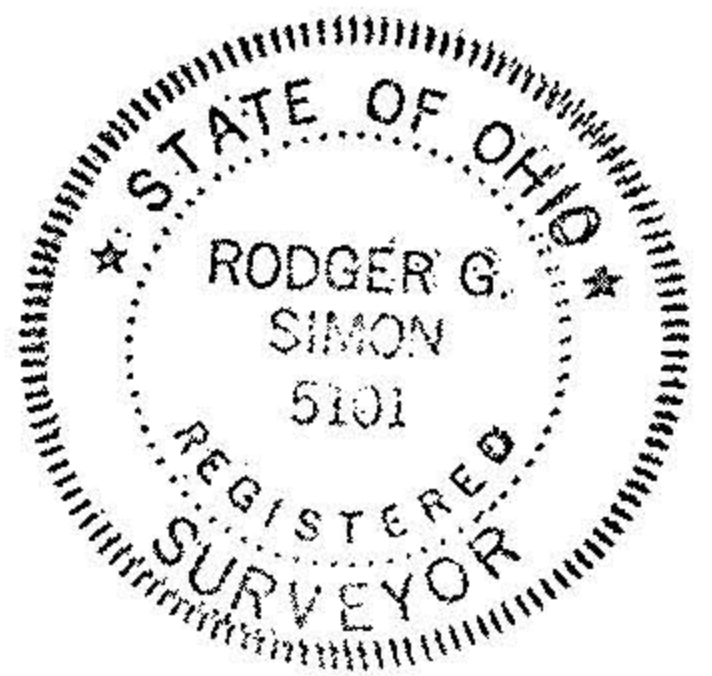

LAUNDON • SIMON • CAHL & ASSOC., INC.
 PROFESSIONAL LAND SURVEYORS
 110 MIDDLE AVE., ELYRIA, O. 44035

BANNON ALLOT. No. 1 P.V. 14 P. 19 FOR
 JEFFREY D. HEATHCOTE

Orig. Lot No. 26	City of ELYRIA	Date 1-21-98 Scale 1" = 50'
Orig. Sec No.	Village of	Dwn. by R.G.S. Chkd. by R.C.
Tract WEST OF RIVER	County of LORAIN	Job No. 97-3014 F.B. 242/48
Township of ELYRIA	State of Ohio	Printed

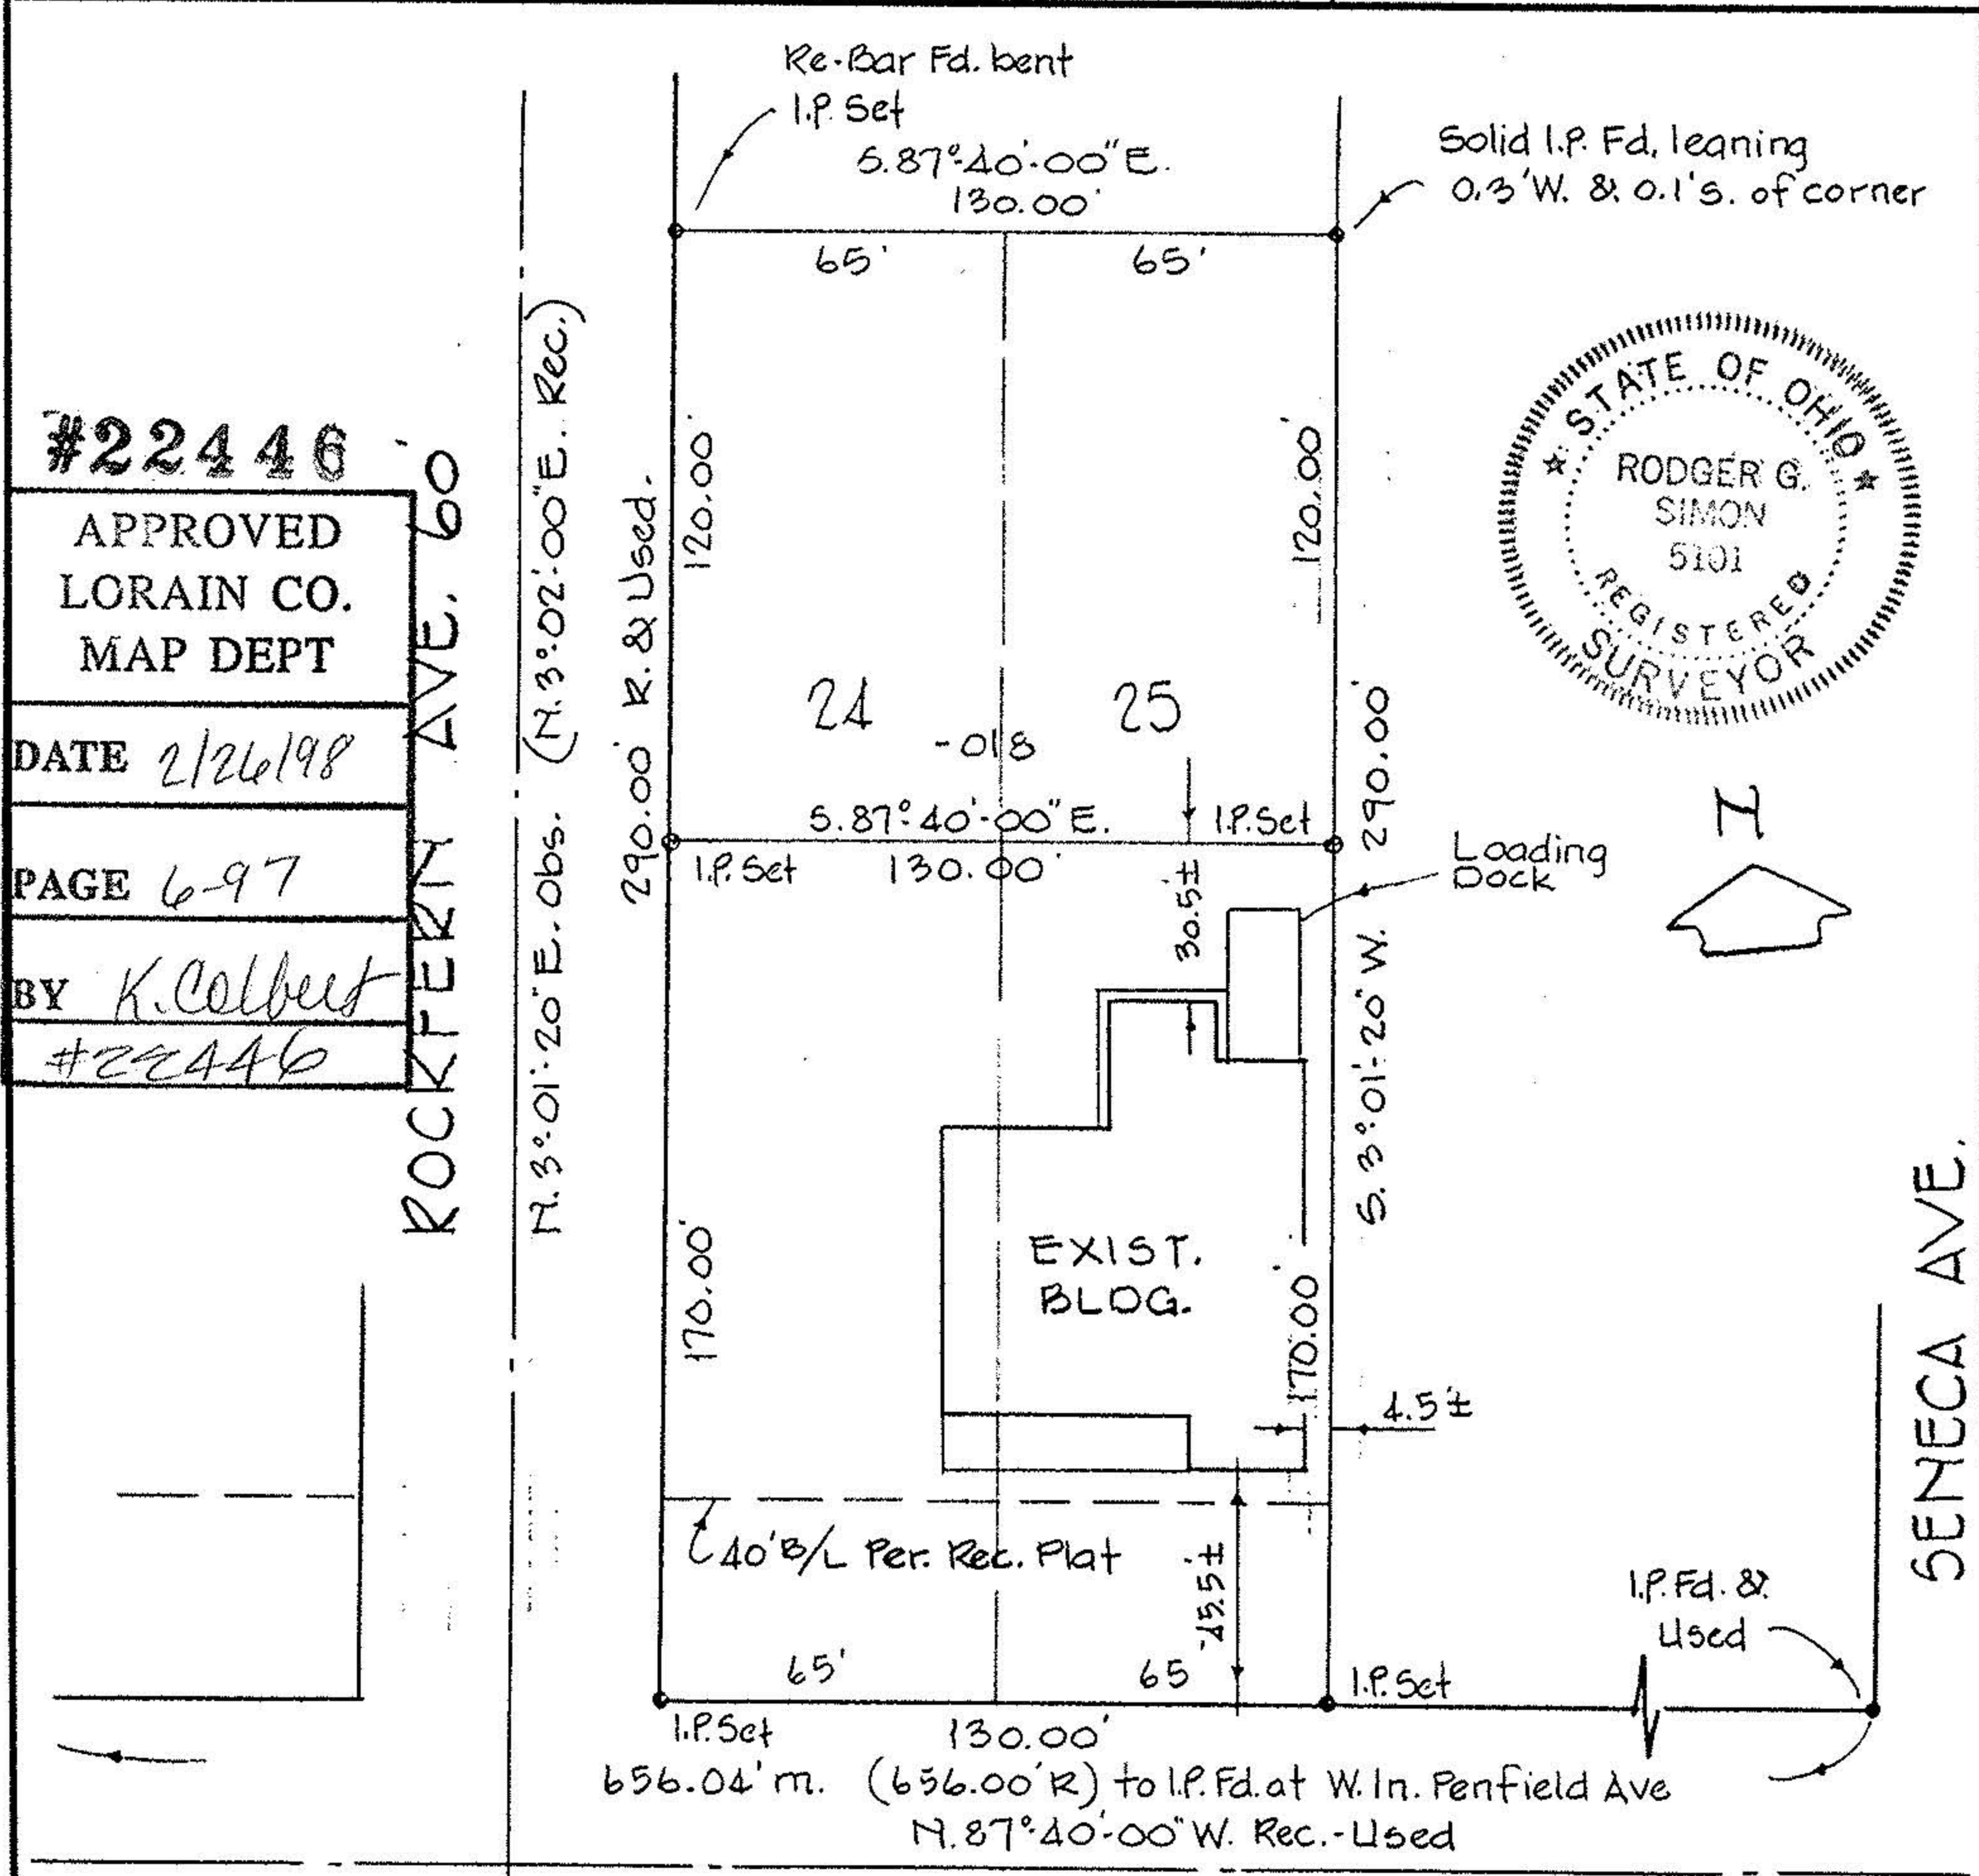

LOWELL ST. 66'

REVISED 2-4-98