


6-91

10488

6-91

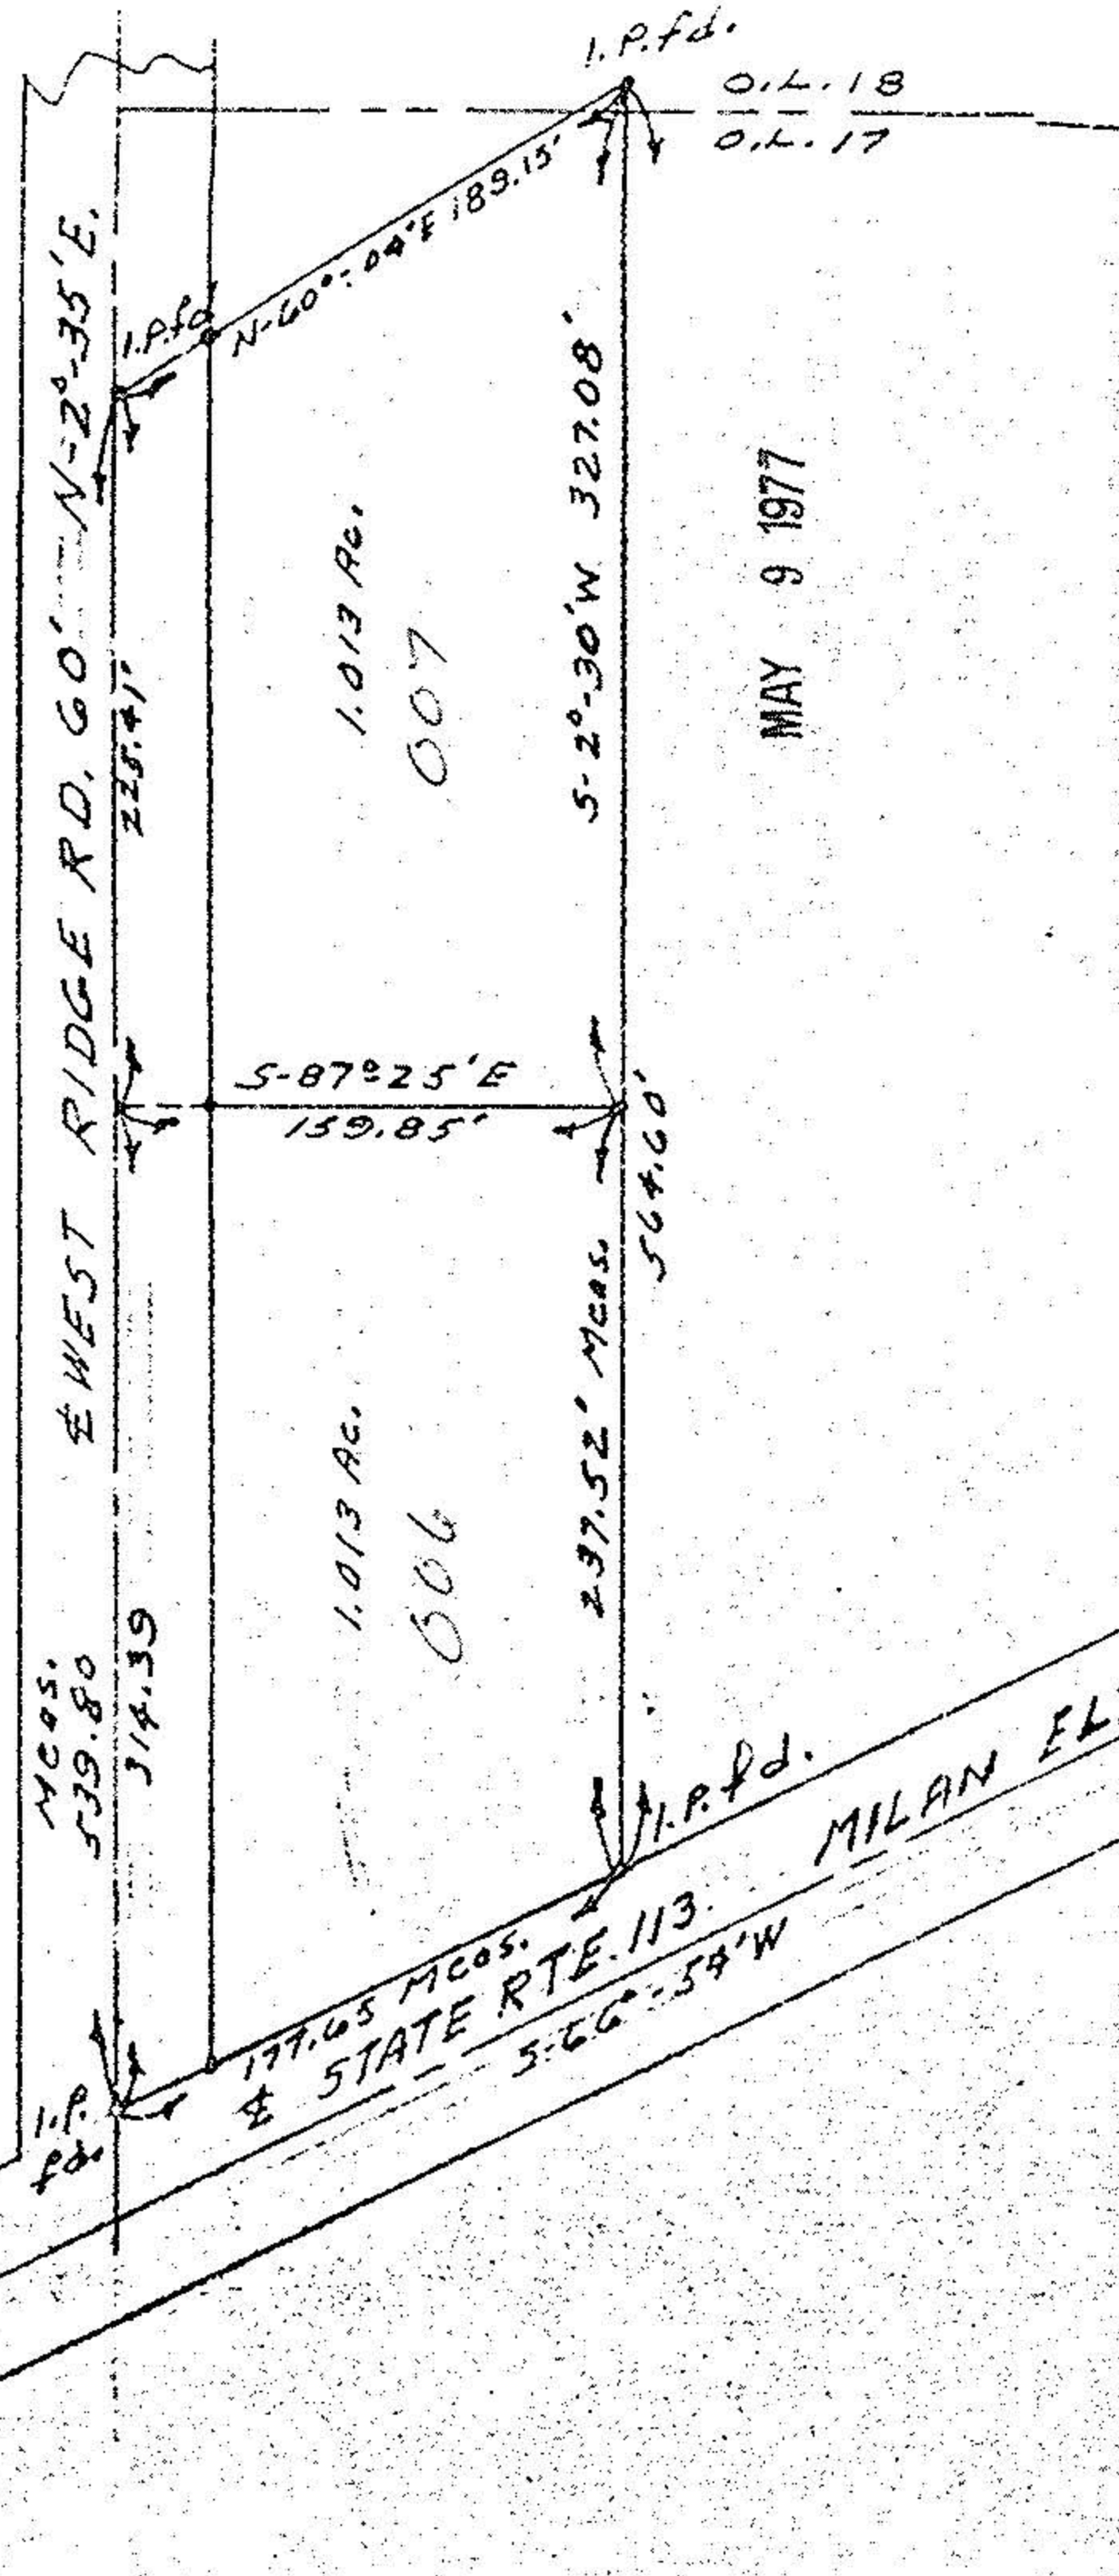

MAY 9 1977

Joe Sarbono
 32363 Lake Rd
 Avon Lake

SURVEY FOR ADELBERT KASTLER
 Part of Elyria Twp. Lot Nos. 17, 18
 Elyria Twp. Lorain Co. State of Ohio
 Febr. 12, 1977 Scale 1" = 200'
 A. D. Jernicola Reg. Surveyor