

06-24-018-000-

20084

6-73

18005#



RIDGE ROAD

WEST

N-1°00'-E

709.10' REC. & USED
608.72' REC. & MEAS.

572.39' MEAS.

36.33' REC.

60' R.

100' R.

100' R.

300.38'

280.38'

Iron Pin Set

Iron Pin Found 30' E.

N-89°00'-W
270.00'

S-89°00'-E

N-1°00'-E
101.70'

Iron Pin Set

20'

Iron Pin Set

81.70'

527.90' REC.

257.90'
N-89°00'-W

Iron Pin Set

Iron Pin Set

527.90' R.
(06-24-018-000-012) 1.21 AC.
BOBBY RAY & SHIRLEY A. ARMES
D.V. 1275 P. 88
527.90' R.

(06-24-018-000-016) 1.21 AC.
ROBERT CARL & BARBARA JEAN SCHEITHAUER
D.V. 1090 P. 356

S-89°00'-E 527.90' R. & U.

4.0000 AC.

(06-24-018-000-024)
WAYNE F. & SUSAN L. STANG
D.V. 1274

382.08'

27.63 AC.
P. 798
(24.62 AC. Rem.)

S-1°00'-W

Iron Pin Found 0.20' W.

(06-24-018-000-025)
8.39 AC. (7.40 AC. Rem.)

WAYNE F. & SUSAN L. STANG
O.R.V. 435 P. 647

776.11' REC.

20084

APPROVED
LORAIN CO.
MAP DEPT.

DATE 9-15-92

PAGE 6-73

CAROLYN BY FRANCIS

LOT 18 20084

BOUNDARY SURVEY


PART OF ELYRIA TOWNSHIP ORIGINAL
TRACT WEST OF BLACK RIVER
TOWNSHIP OF ELYRIA COUNTY OF LORAIN
STATE OF OHIO

SCALE: 1" = 100'

JULY 1, 1992

PREPARED BY
KS ASSOCIATES INC.
ENGINEERS SURVEYORS

David L. Elwell
DAVID L. ELWELL R.S. N. 6333

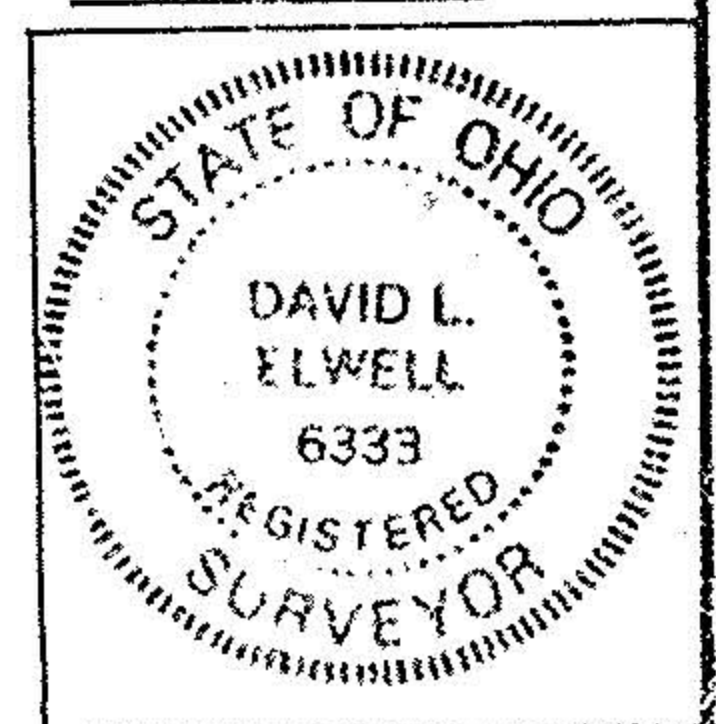

CONSOLIDATED
RAIL
CORP.