



KLEINOEDER · SCHMIDT

and ASSOCIATES

ENGINEERS — SURVEYORS — CONSULTANTS IN LAND PLANNING

ELYRIA · NORWALK · MEDINA

OHIO

SURVEY

Sublot(s) 1 & 2 BLOCK 23
1, 2, & 3 BLOCK 33

6 BLOCK 32

Subd'n ACRE FARMS ALLOT. NO. 1

P.V. 9 P. 21

Township ELYRIA

Orig. Lot(s) 34

County of LOBAIN

Corporation CITY OF ELYRIA

Tract WEST OF BLACK RIVER

Sec. _____


State of Ohio

BRACE AVENUE 50'

06-24-03A-107

#16984

6-62

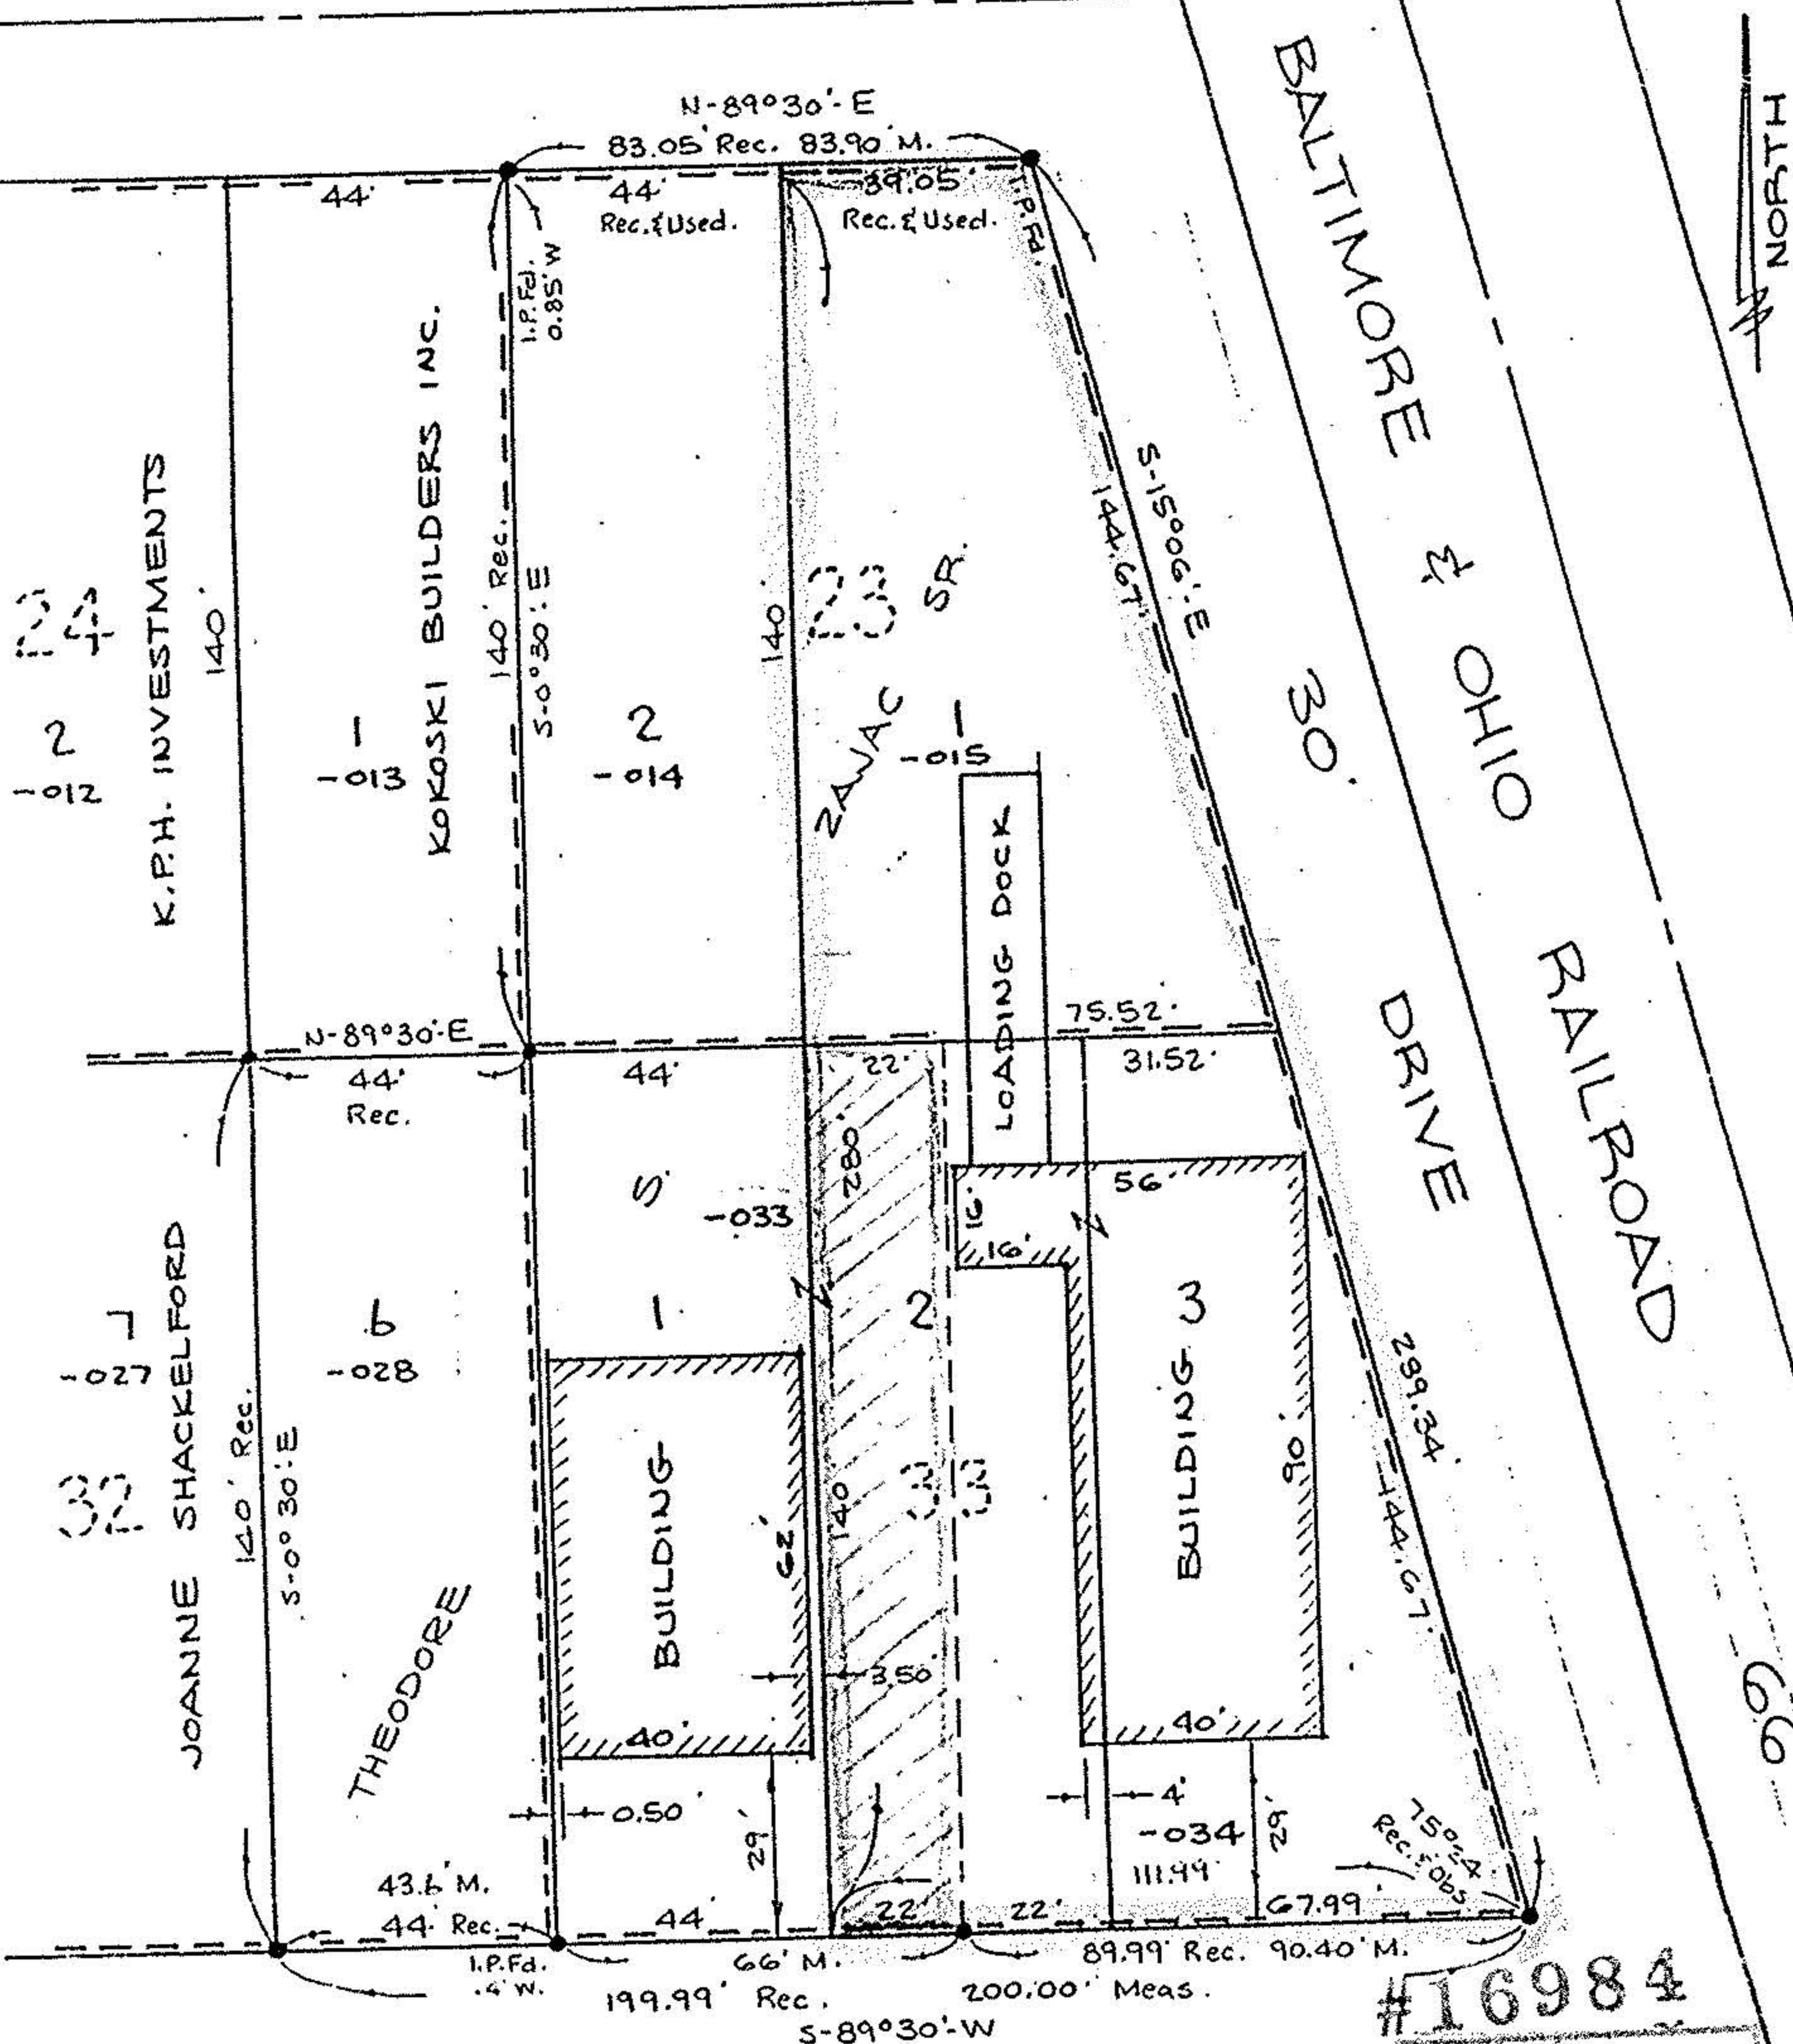

M-1 ZONING

MORGAN AVENUE 50'

#16984

APPROVED
LORAIN CO.
MAP DEPT.

DATE 9.8.86

PAGE 6-62

BY T. McMain

VOID
AFTER

Prepared for: LOGOS DEVELOPMENT

Scale: 1" = 40'

Date: 8-23-86

Dr. by: D.E.

Job No 86-193