


6-Block Tract - 039-101-000

-069

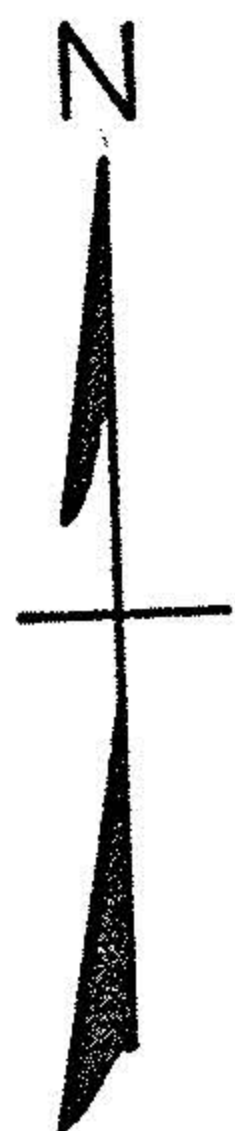

NOTE: • indicates iron pin set.

DRIVEWAY ENCROACHMENT SURVEY
 FOR IRVIN & AGNES DELLEFIELD
 ORIG. LOT 39 WEST OF RIVER
 ELYRIA TOWNSHIP
 LORAIN COUNTY OHIO
 SCALE: 1" = 20' MARCH 11-1968
 Gary E. Penfound
 Registered Surveyor No. 4457