

6-40,91 6-59 6-88 #18879 06-24-040-102





LAUNDON . SIMON . CAHL & ASSOC. INC.
CONSULTING ENGINEERS & SURVEYORS
219 COURT ST. ELYRIA, OHIO 44035

SURVEY FOR

BERNARD & MARY ELLEN
JANKOWSKI

Orig. Lot 40	City of	Date 3-8-88	Scale 1"=150'
Orig. Sec	Village of	Dwn. by R.G.S.	Chkd. by C.J.
Tract WEST OF BLACK RIVER	County of LORAIN	Job No. 88-1680	F.B. -
Township of ELYRIA	State of OHIO	Printed	Mar 7 1988

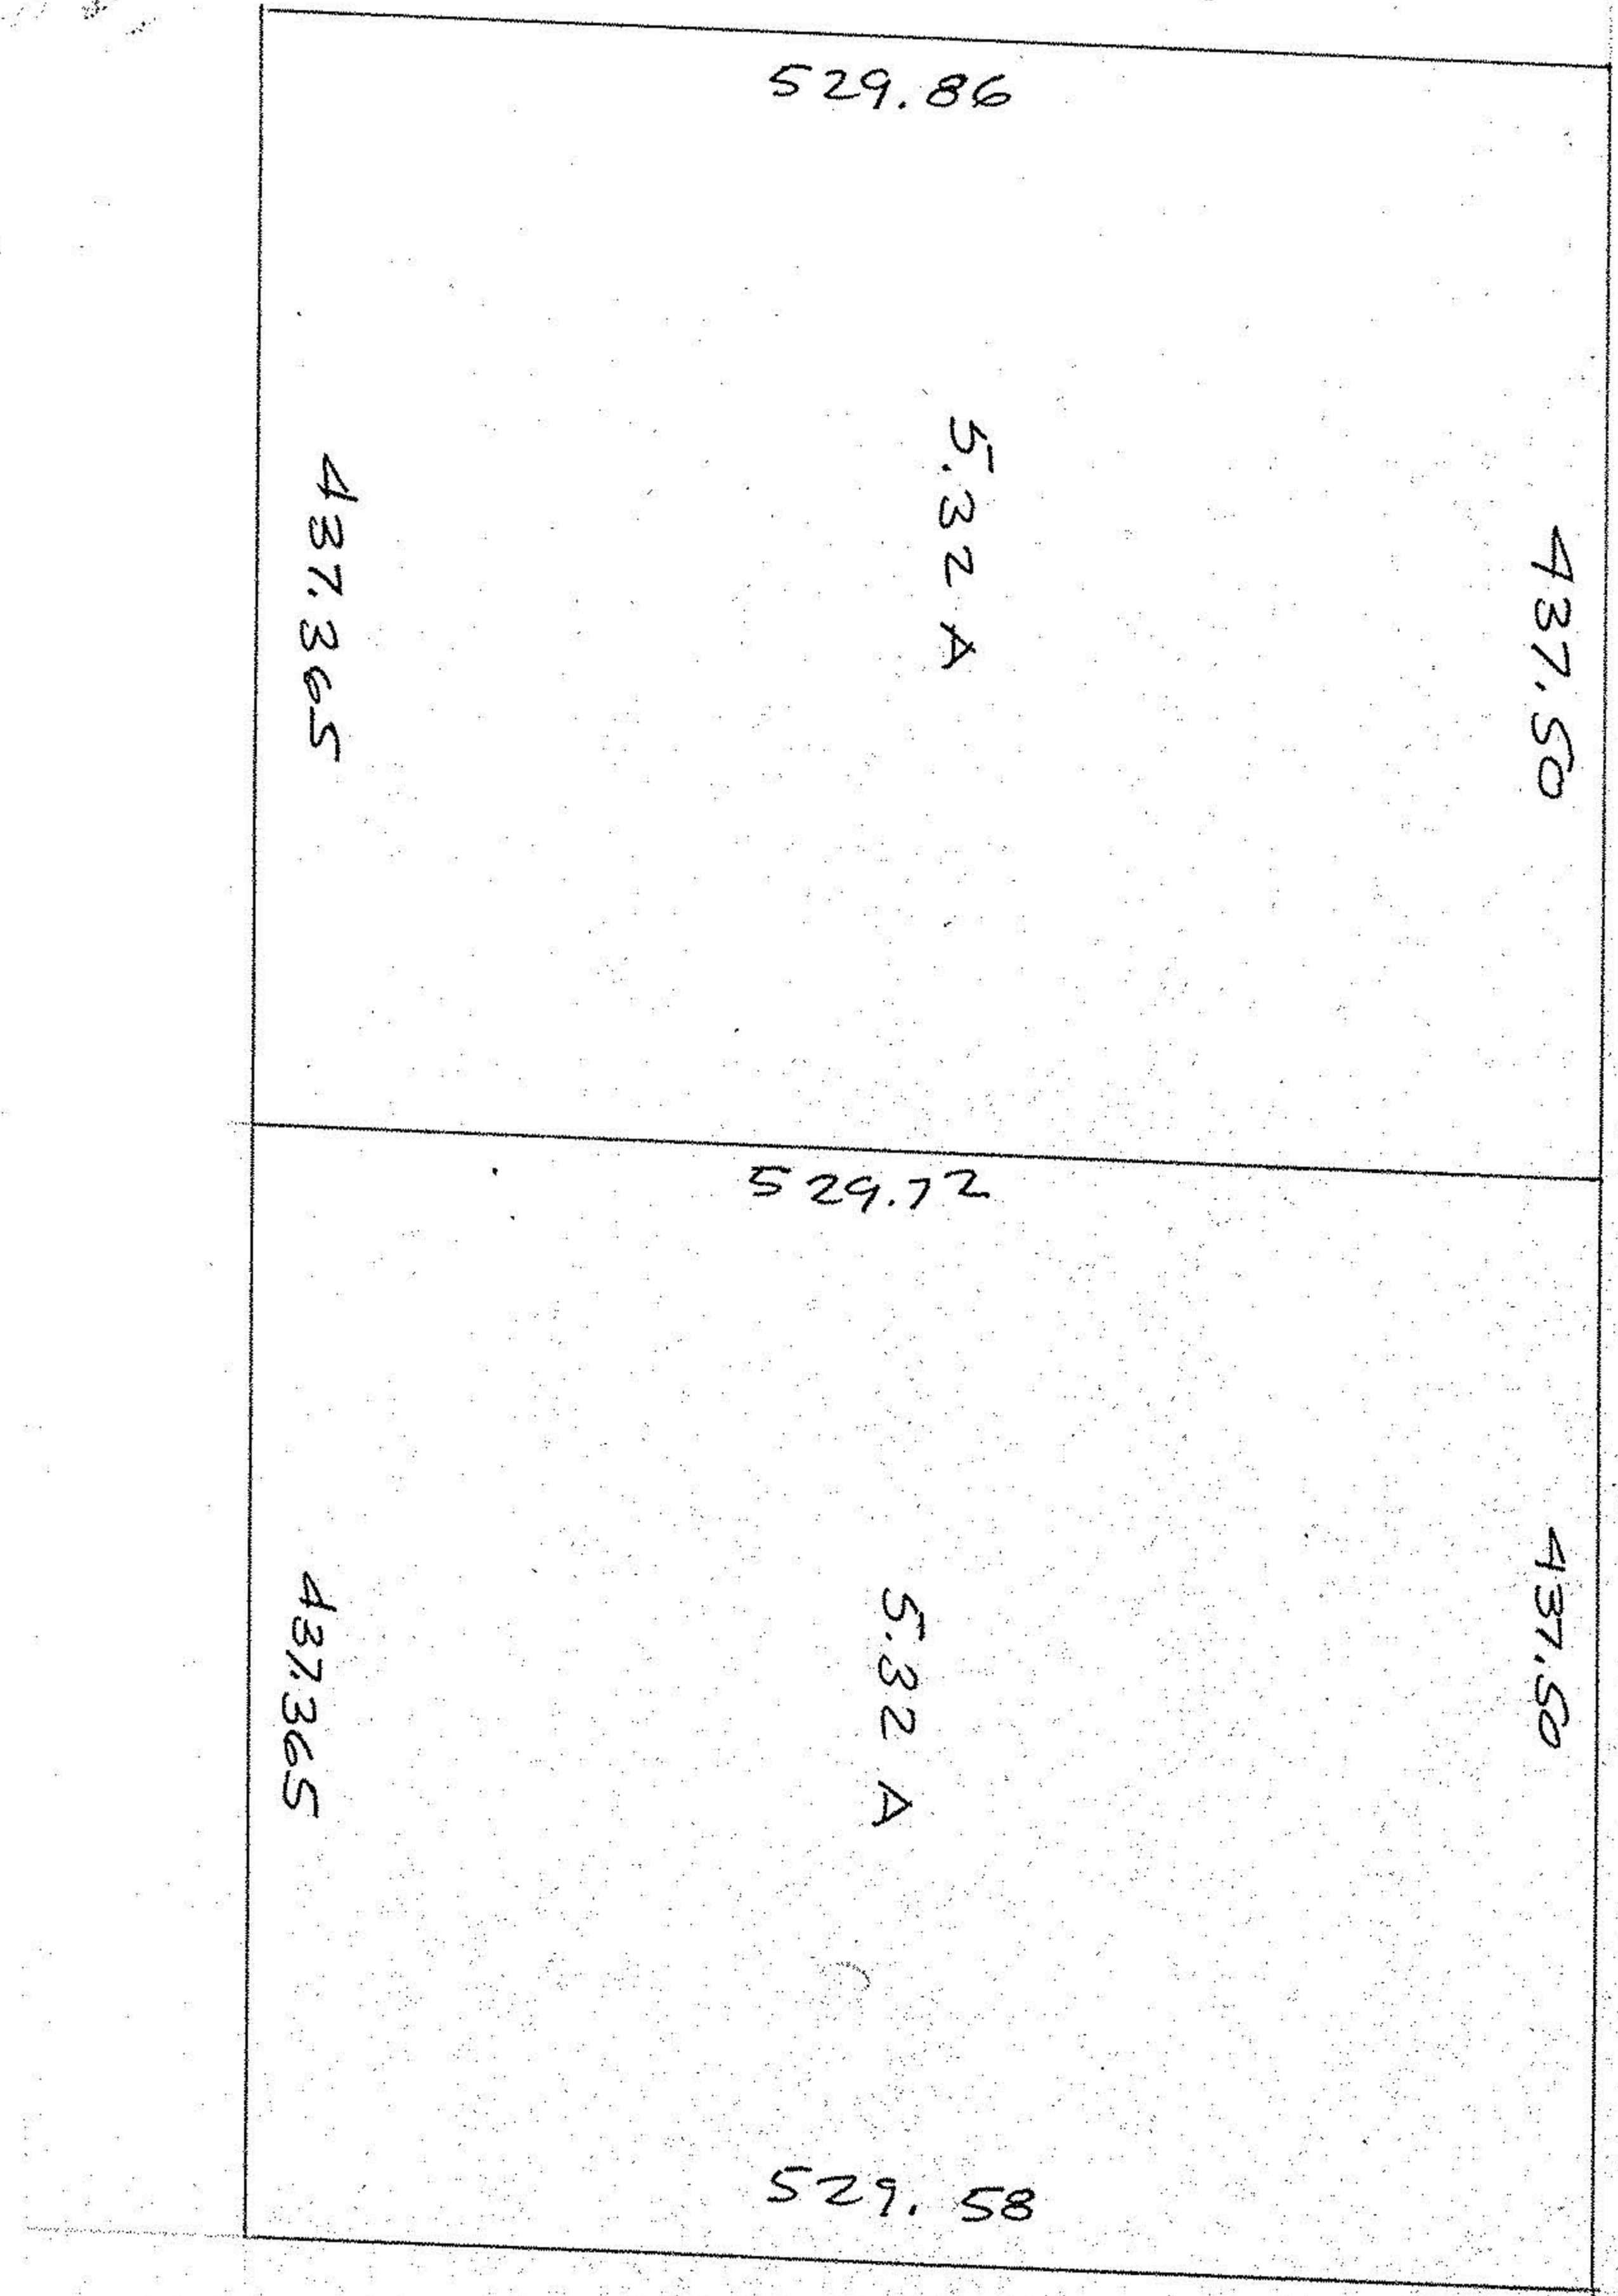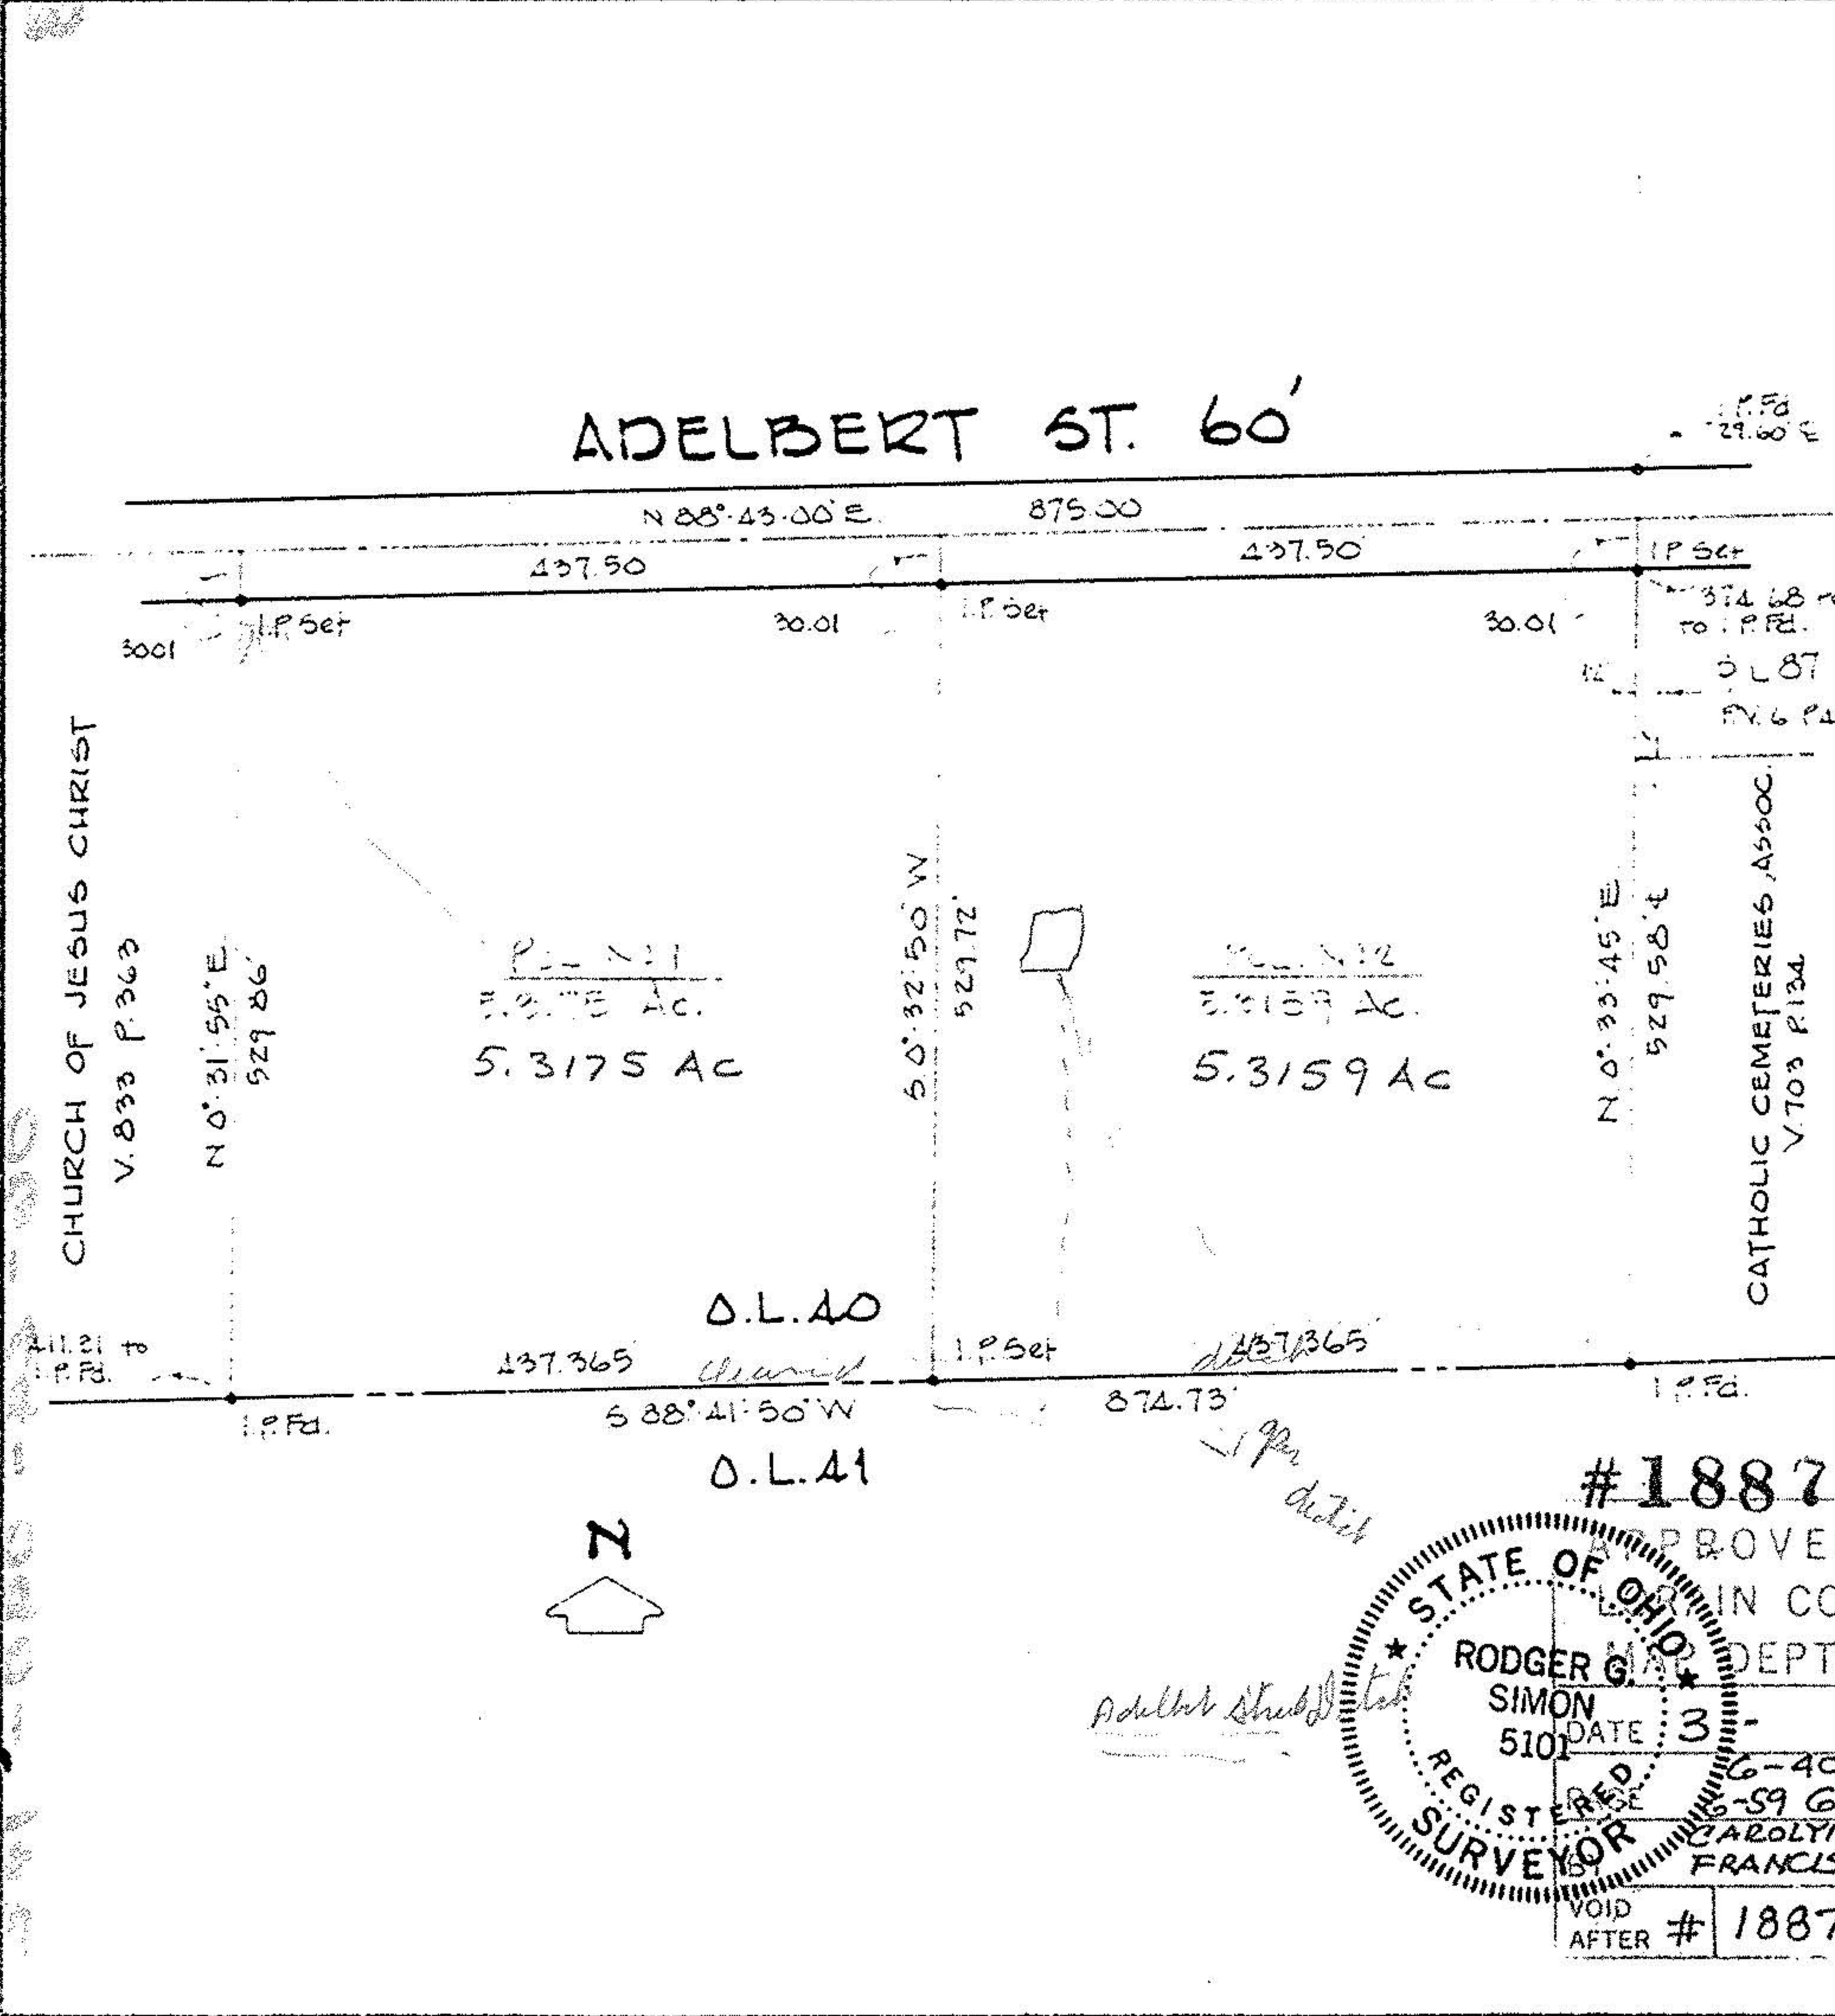

ADELBERT ST

#18879
 APPROVED
 STATE OF OHIO
 IN CO. DEPT.
 RODGER G. SIMON
 5101
 DATE 3-8-88
 REGISTERED SURVEYOR
 CAROLYN FRANCIS
 VOID AFTER #18879