

# KLEINOEDER · SCHMIDT

and ASSOCIATES

ENGINEERS — SURVEYORS — CONSULTANTS IN LAND PLANNING

ELYRIA · NORWALK · MEDINA

OHIO

# SURVEY

Sublot(s) 27

Subd'n MANOR-JAY SUBDIVISION


P.V. 15 P. 31

Township ELYRIA Tract WEST OF BLACK RIVER

Orig. Lots 45 Sec. \_\_\_\_\_

County of LORAIN State of Ohio

Corporation \_\_\_\_\_

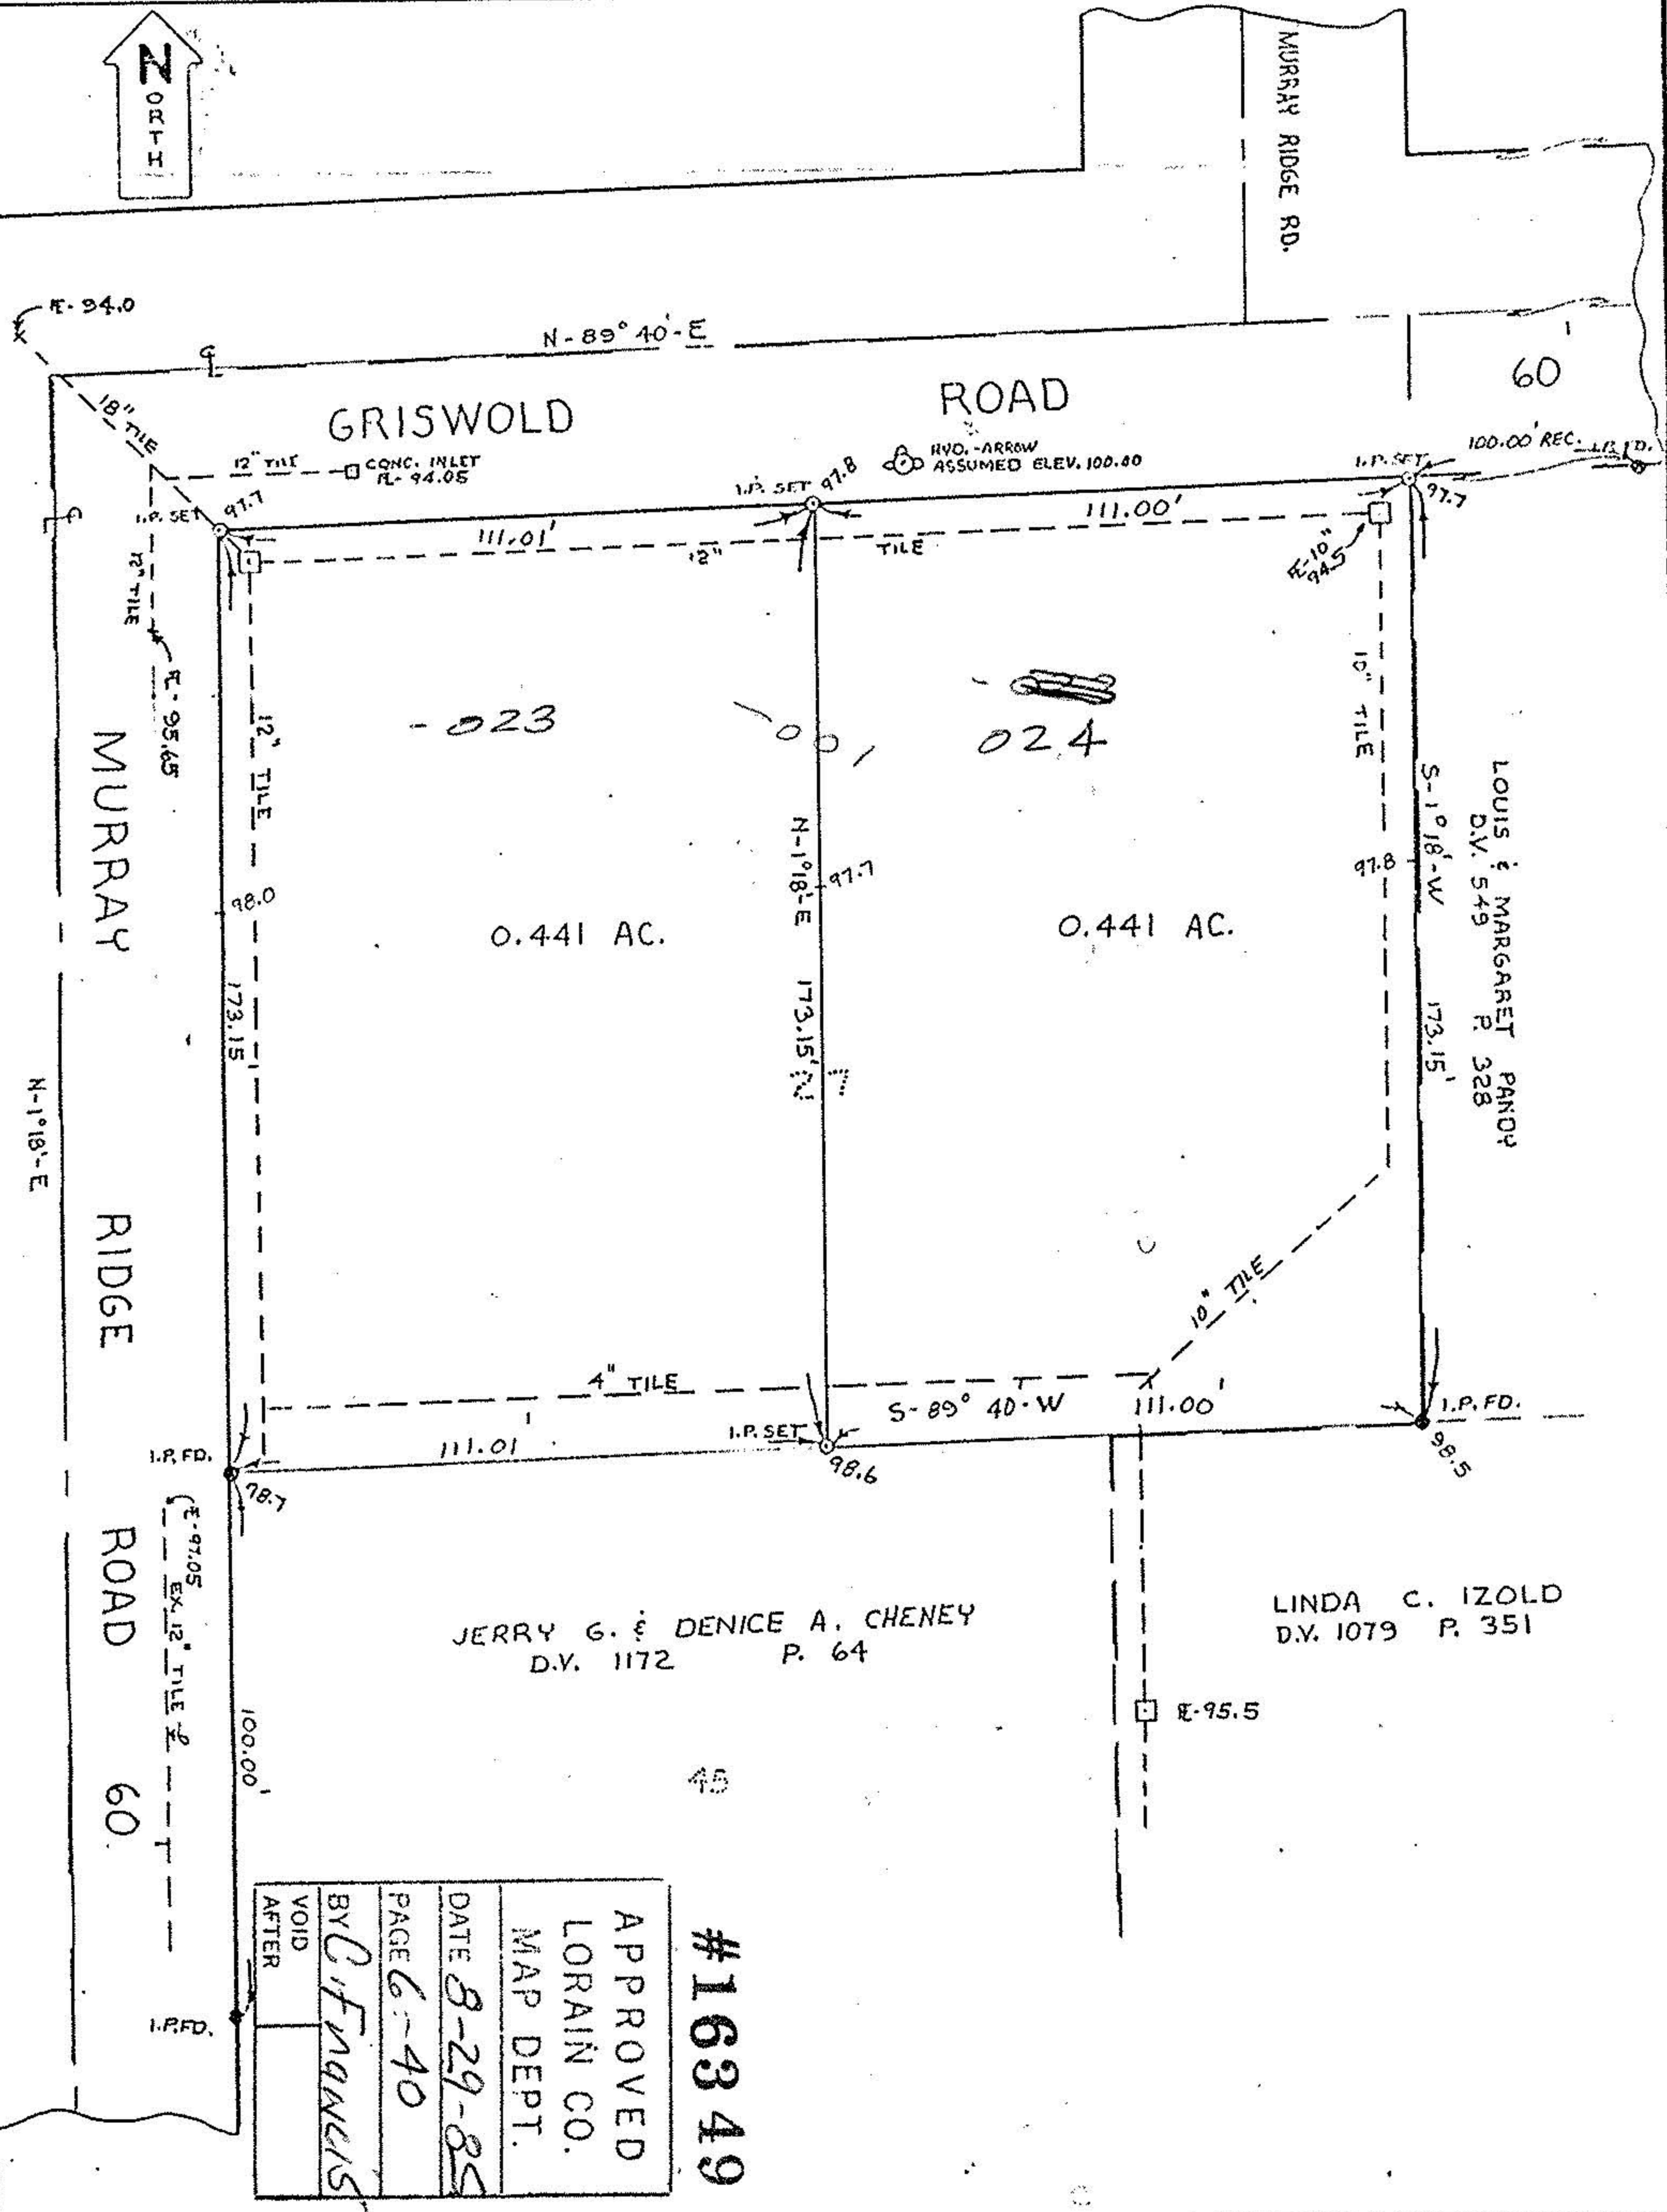

APPROVED  
 LORAIN CO.  
 MAP DEPT.  
 DATE 8-29-85  
 PAGE 6-40  
 BY C. F. MANCIS  
 VOID AFTER \_\_\_\_\_

## #16349

Prepared for: JOHN J. ENGEL  
 7162 N. MURRAY RIDGE ROAD  
 ELYRIA OHIO 44035

Scale: 1" = 40'      Date: 1-10-80      Dr. by: K.V.S.      Job No 80-03

06-24-045-105-105

#

06-24-045-105-105