


06-24-048-000

CARDINAL SURVEYS
PLAT OF SURVEY
PREPARED FOR CHARTER RENTY

1507401

647 3212

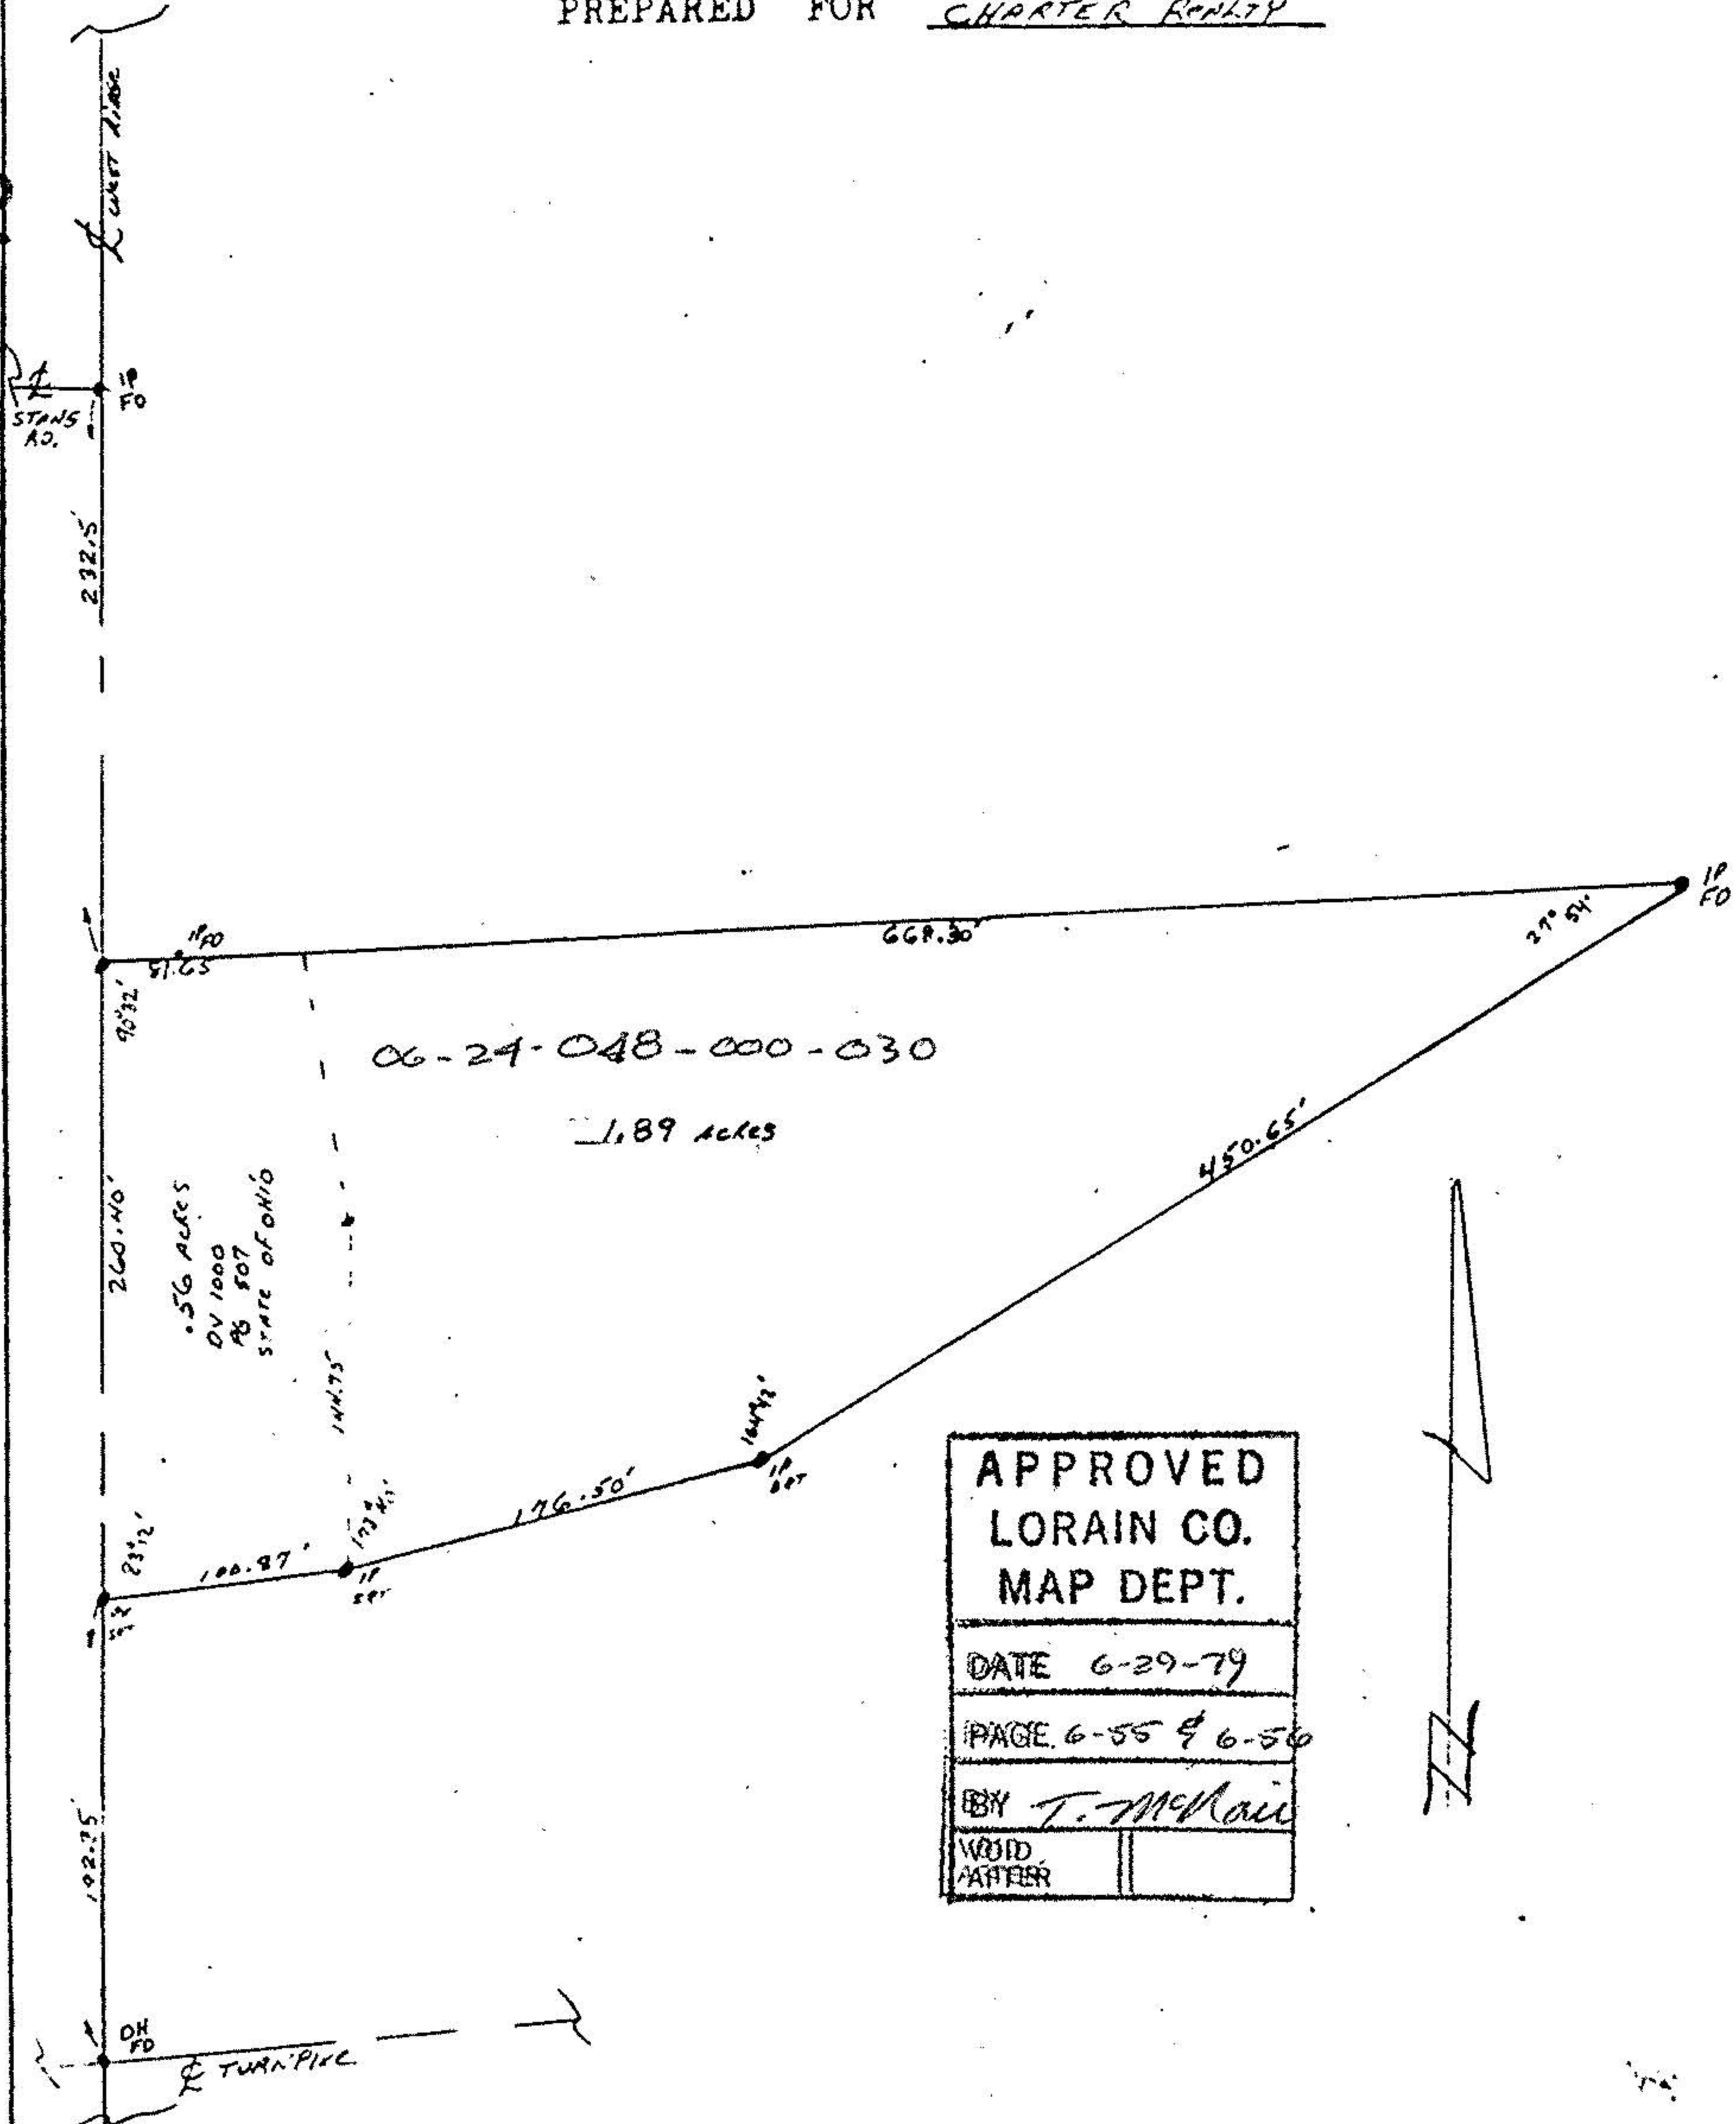

APPROVED
LORAIN CO.
MAP DEPT.

DATE 6-29-79

PAGE 6-55 & 6-56

BY T. McNeil

VOID
AFTER



DATE: MAY 20th, 1979

SCALE: 1" = 100'

6-55
6-56

6-55