



WILLIAM B. BARTON
 Reg. Land Surveyor No. 4438
 188 PARKWOOD AVENUE
 AVON LAKE, OHIO 44012
 TELEPHONE (216) 933-6662

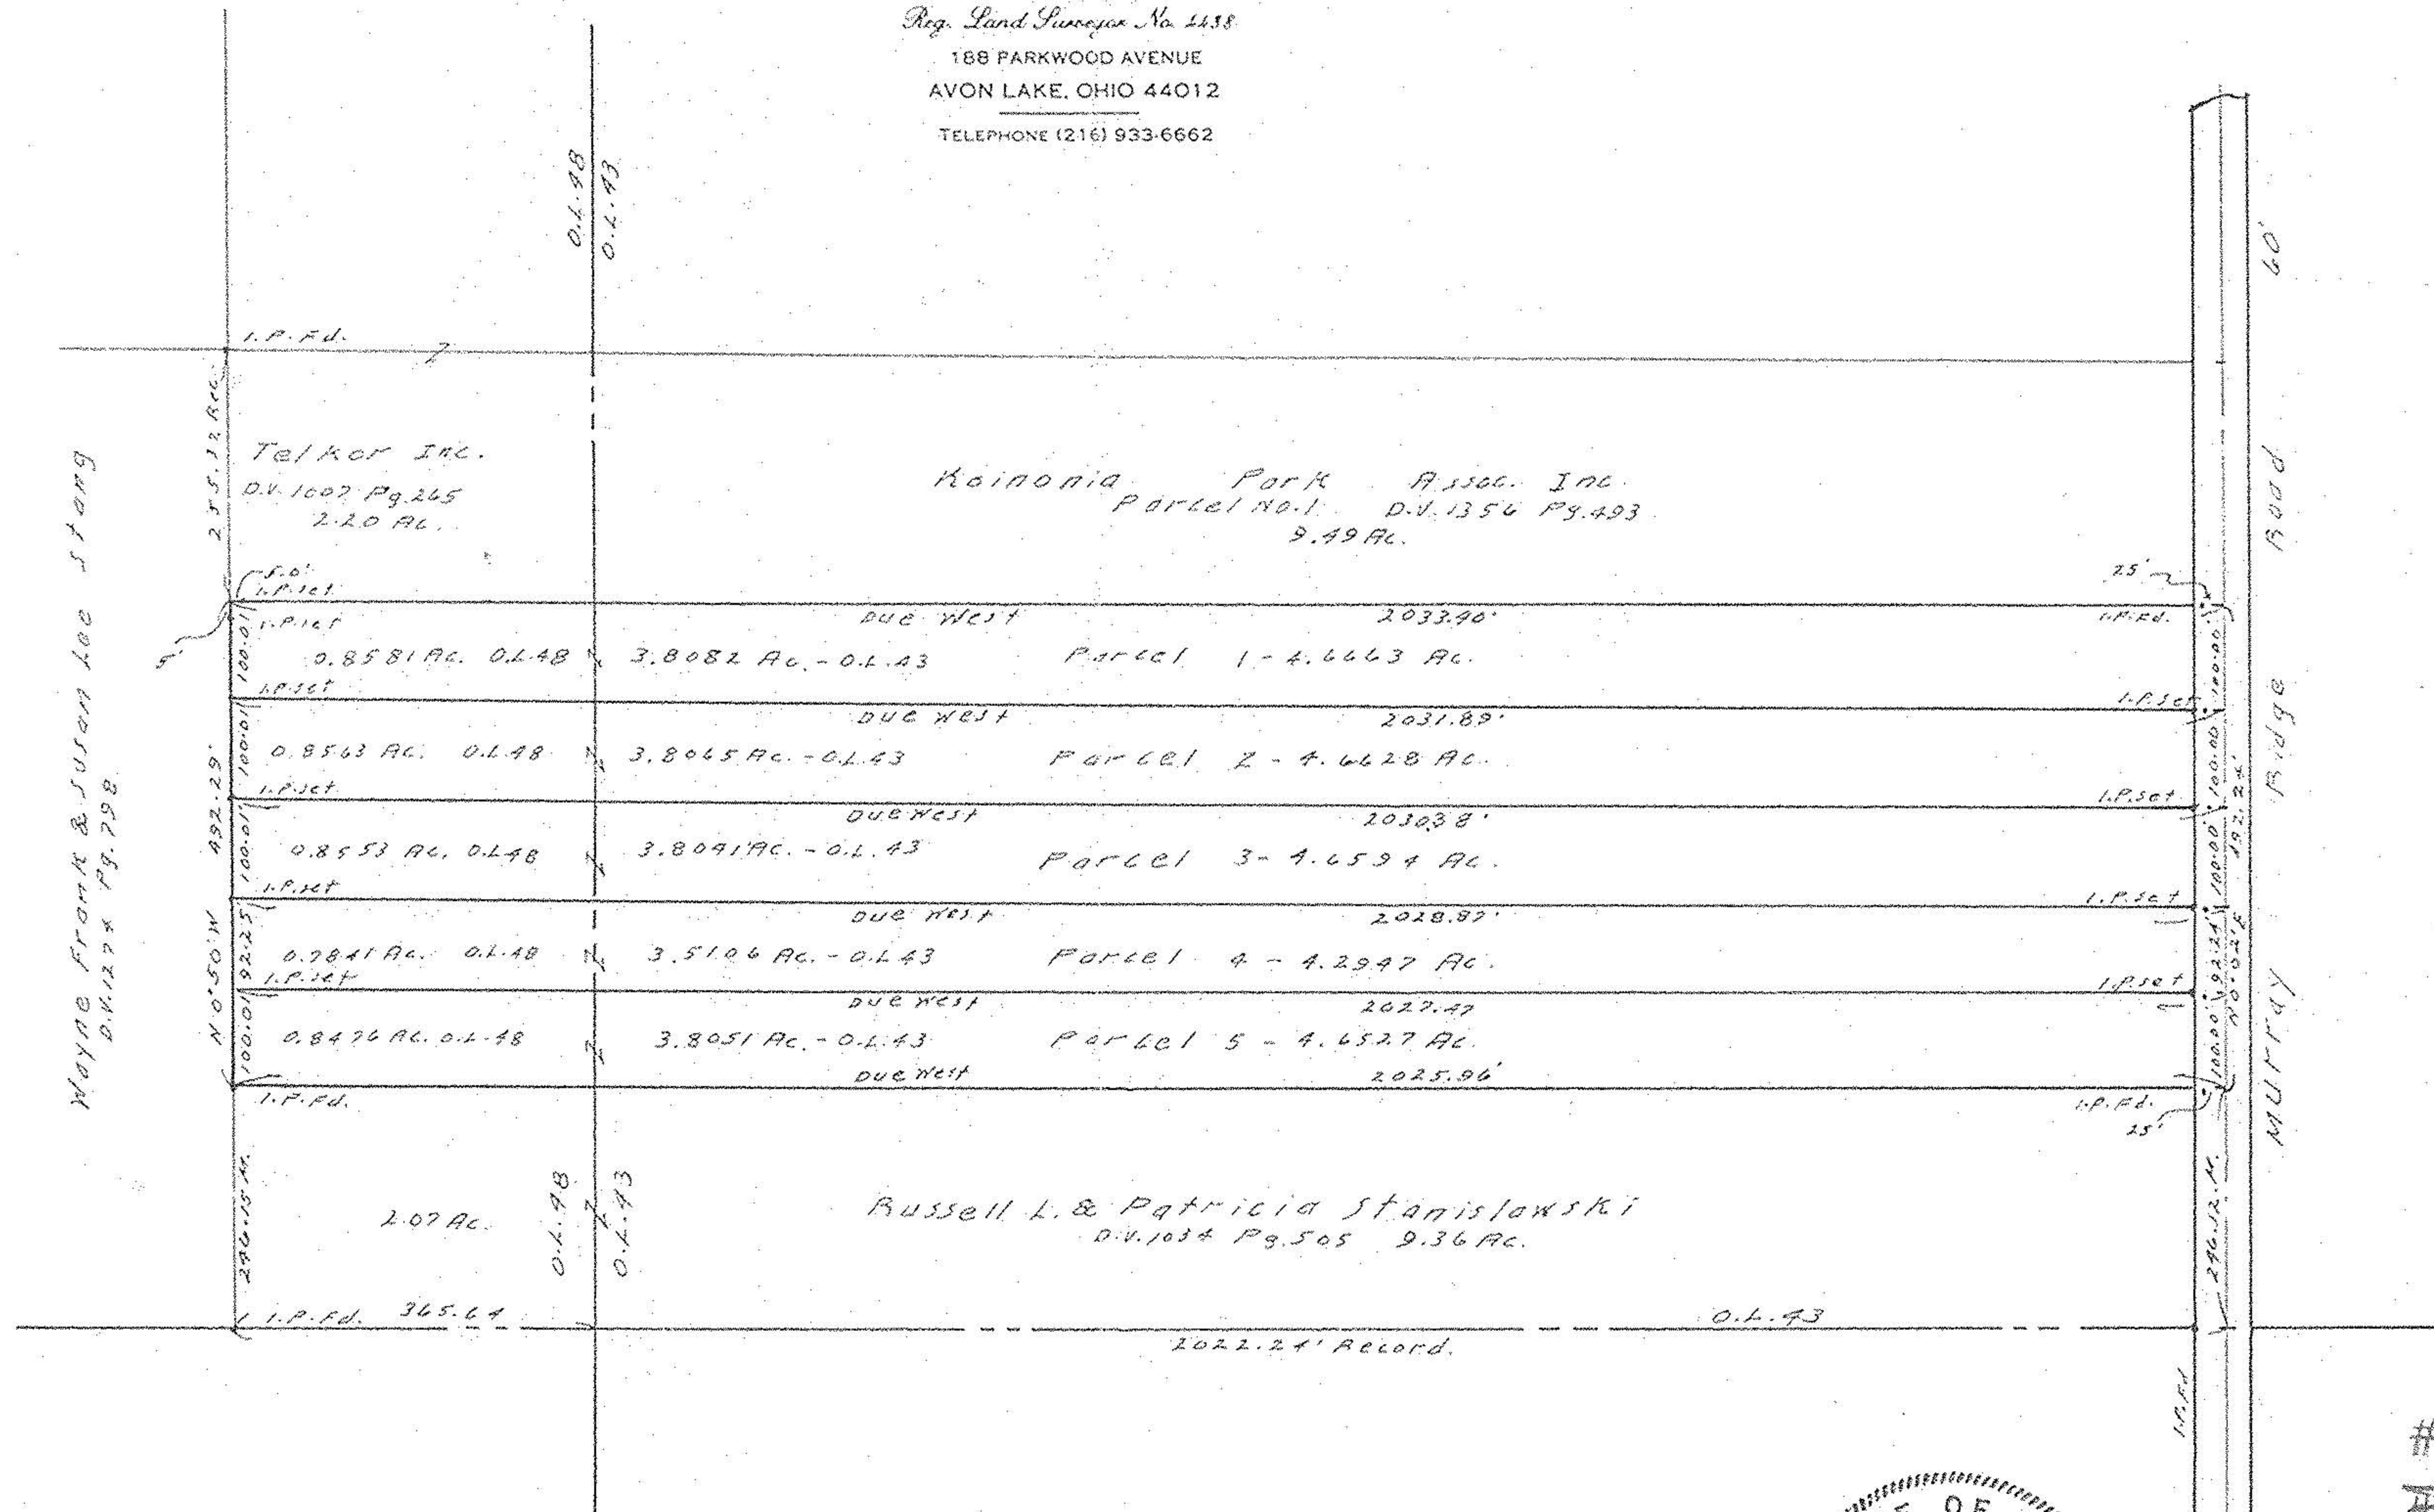

SURVEY
 of
 Parts of Original Lots 43 and 48 west of Black River
 Elyria Township, Lorain County Ohio. March 26, 1988.
 Scale 1"=200'.

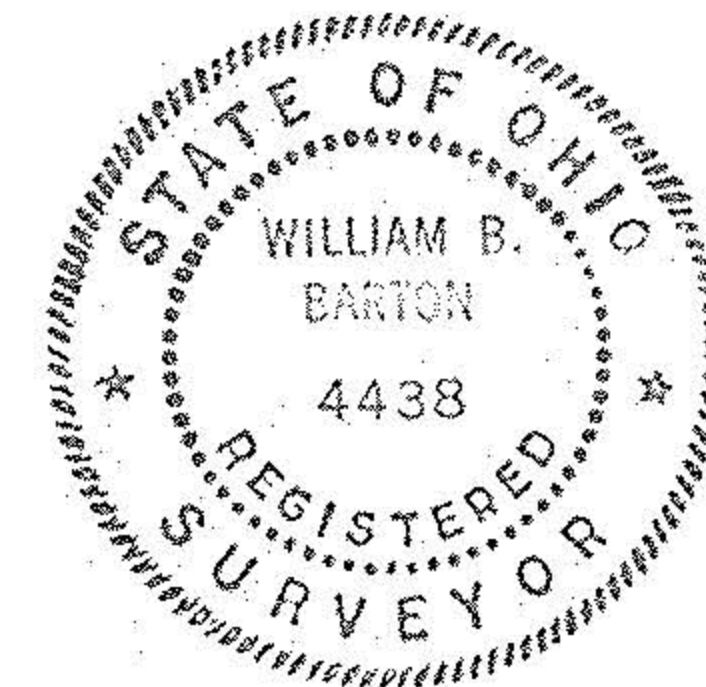

#17922
~~#17918~~
 APPROVED
 LORAIN CO.
 MAP DEPT.
 DATE 4-22-88
 PAGE 6-56, 57
 BY CAROL FRANCIS
 VOID
 AFTER #17922