

6-100


#10765

6-100  
06-24-130-000

FURNACE STREET

KRISER CT

LODI STREET

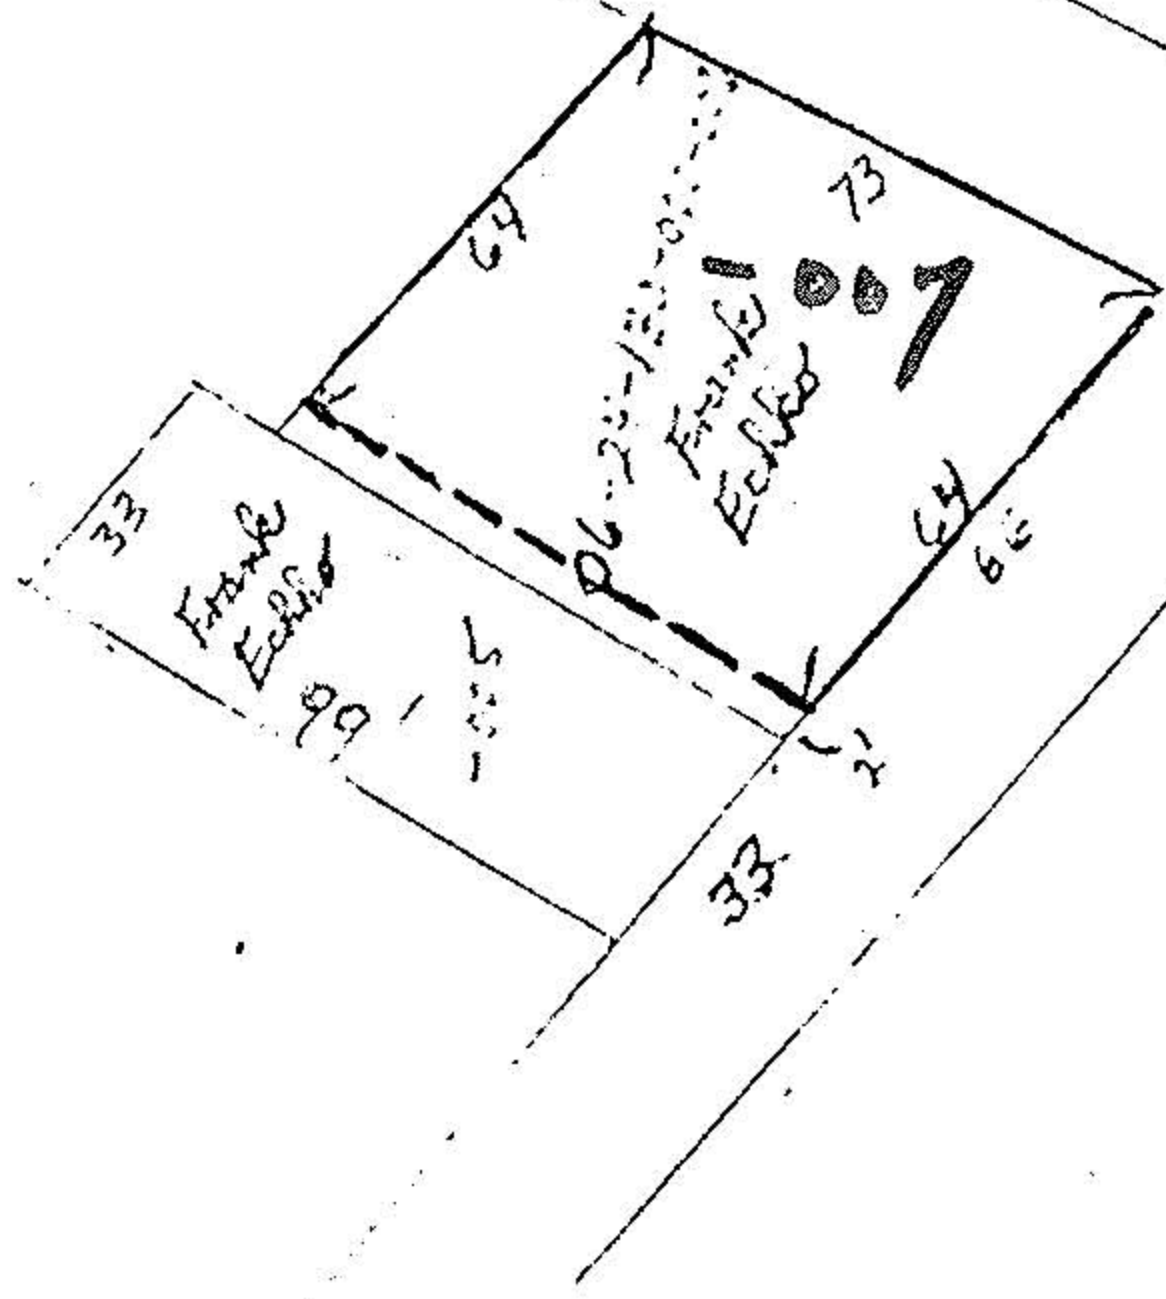

10765  
6-100  
JUL 22 1977



SW CORNER FURNACE AND LODI STREET ELYRIA OHIO  
June 1977