

Ticket # 407-D

#00407-D  
filed 2/24/00  
CSS

10 WEST ERIE STREET, SUITE 101  
PAINESVILLE, OHIO 44077  
PHONE: 440.357.5841  
FAX: 440.357.1816  
1.800.488.3968  
crabbsurv@mail.mvweb.com

72 SOUTH CHESTNUT STREET  
JEFFERSON, OHIO 44047  
PHONE: 440.573.3488  
FAX 440.576.3511


CRABBS' SURVEYING SERVICE  
T. E. STOCKER, P.S. 7245

### RESURVEY OF LANDS

ALL THAT CERTAIN LANDS SITUATE IN THE LOT 148, WEST OF BLACK RIVER, IN THE CITY OF ELYRIA, COUNTY OF LORAIN, STATE OF OHIO. A RESURVEY OF LANDS TO THE SECRETARY OF HOUSING AND URBAN DEVELOPMENT AS RECORDED IN O.R. VOLUME 99, PAGE 0636148 IN THE OFFICE OF THE COUNTY RECORDER.



BASIS OF BEARINGS ARE TO AN ASSUMED MERIDIAN ALONG THE CENTERLINE OF FURNACE ROAD S 35°-00'-00" W

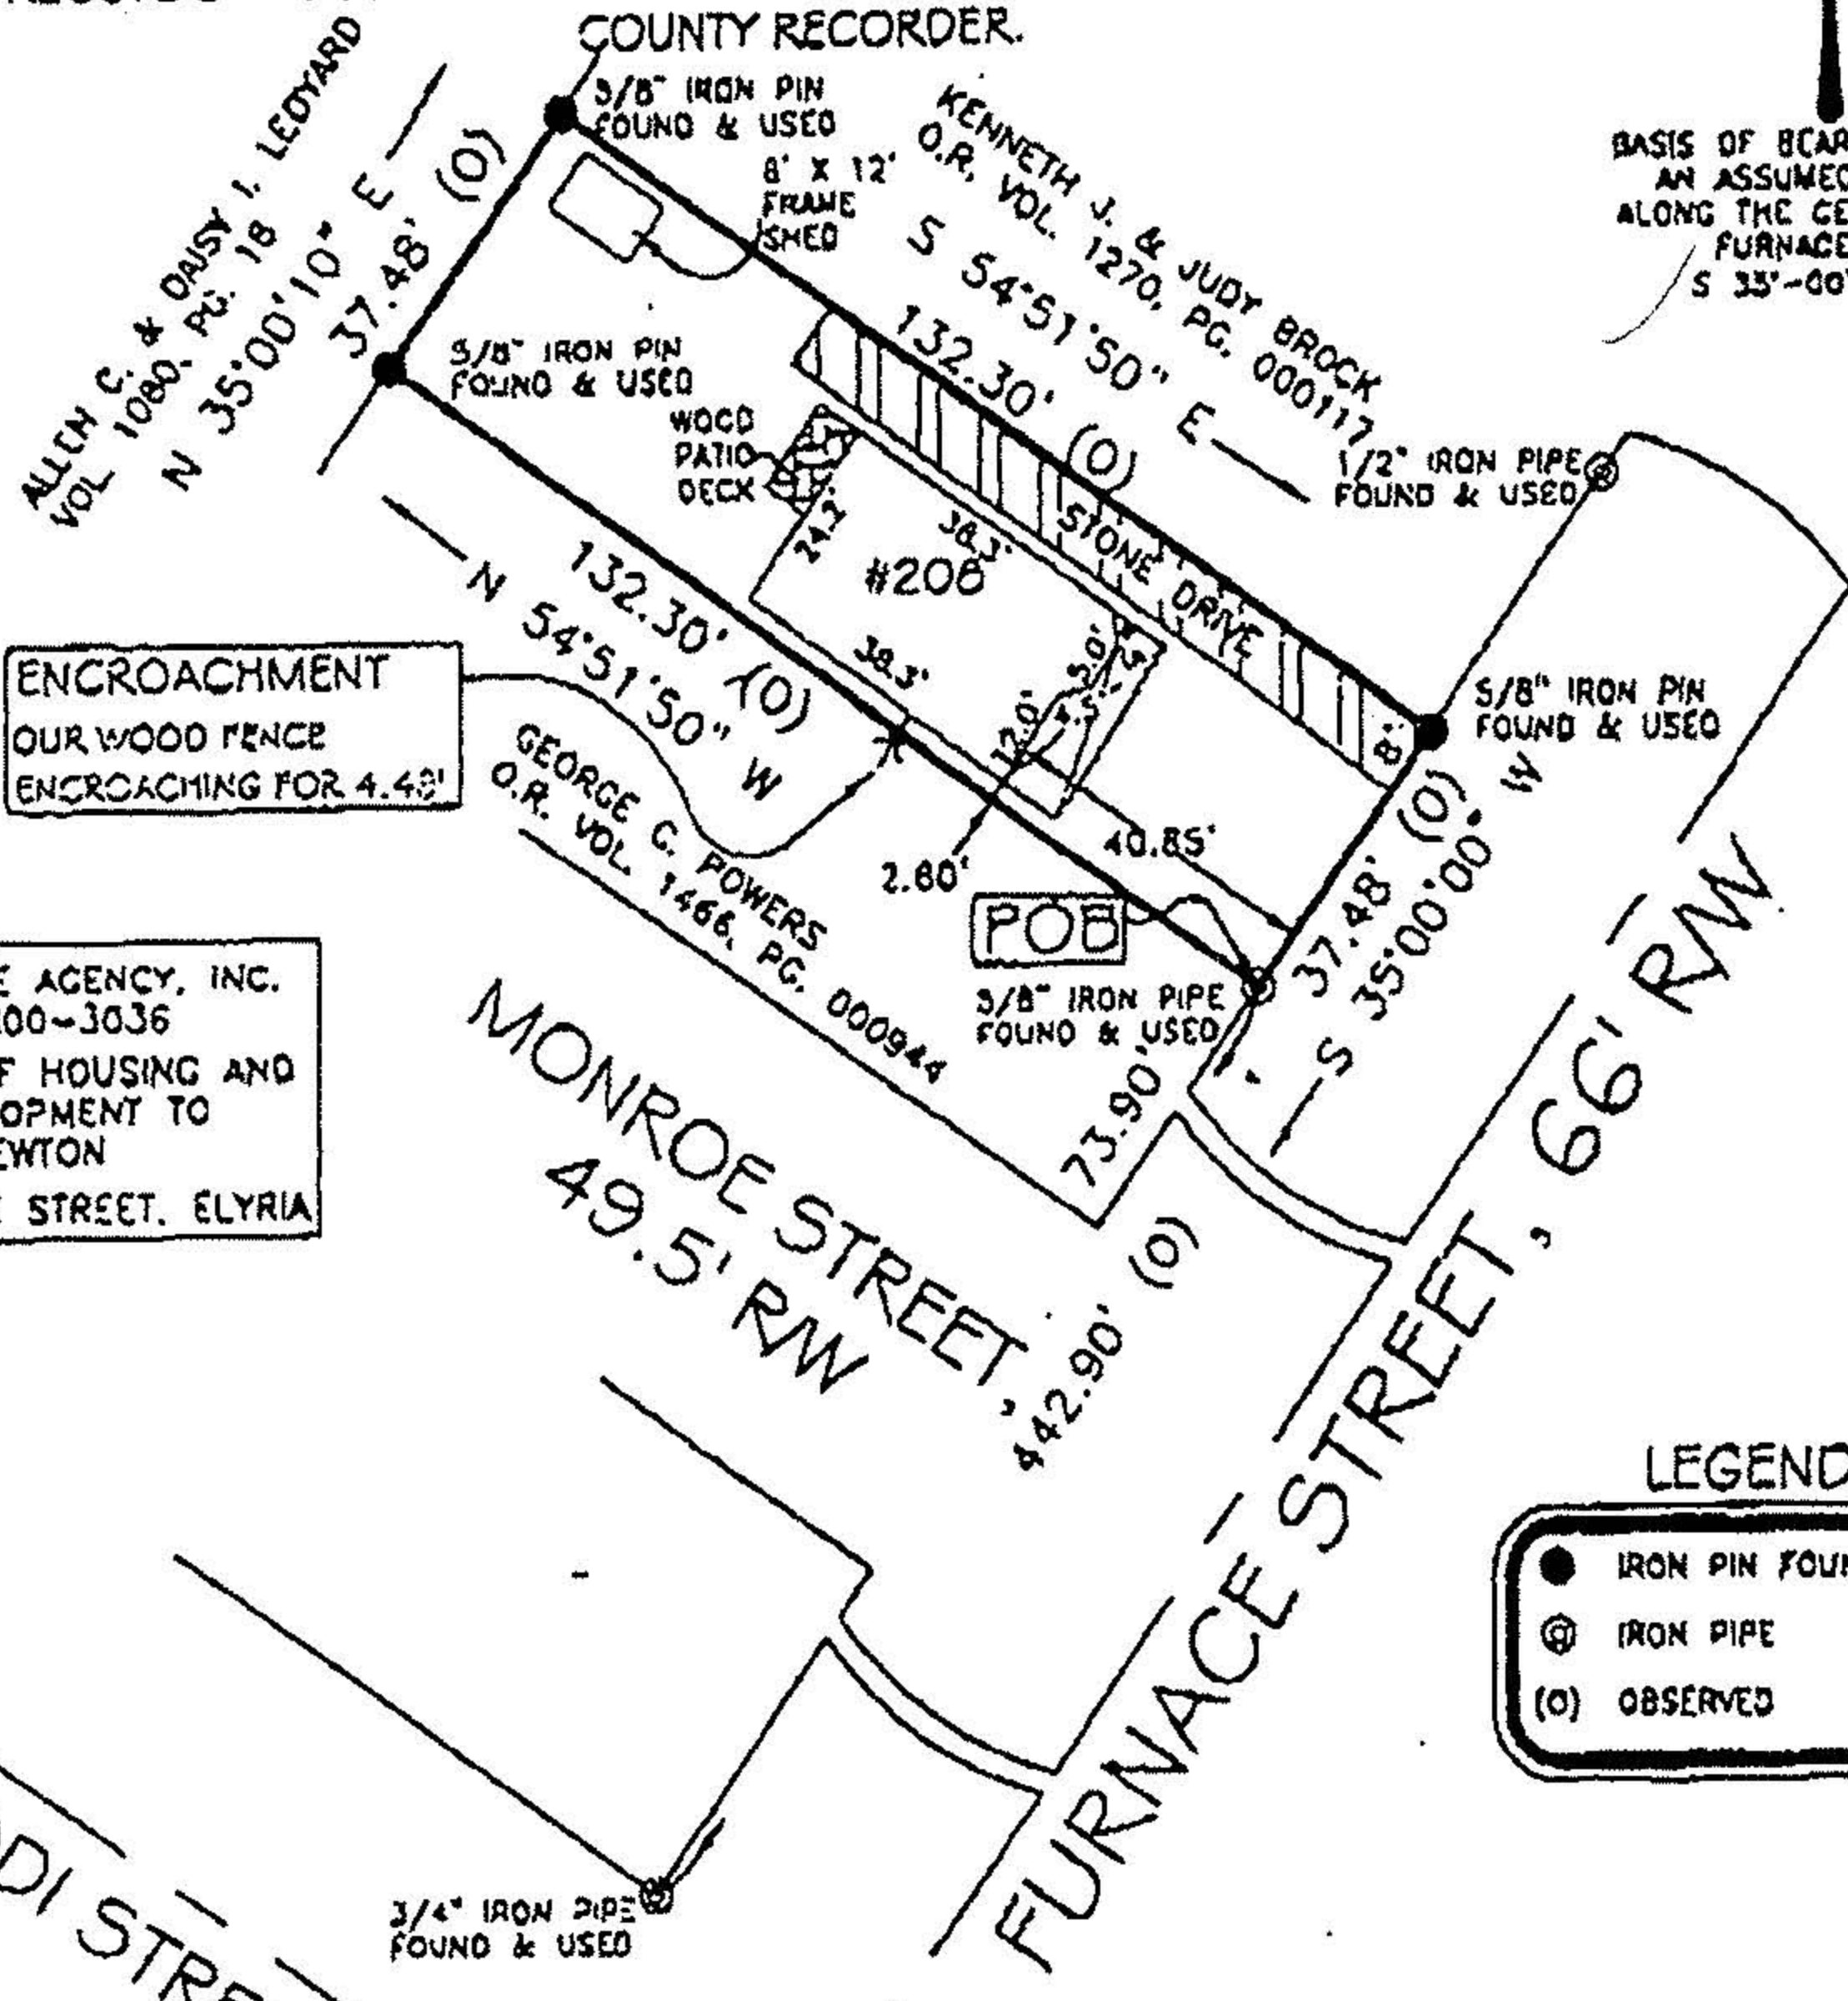


ENCROACHMENT  
OUR WOOD FENCE  
ENCROACHING FOR 4.43'

GATEWAY TITLE AGENCY, INC.  
ORDER NO. H00-3036  
SECRETARY OF HOUSING AND  
URBAN DEVELOPMENT TO  
PAMELA A. NEWTON  
208 FURNACE STREET, ELYRIA

LEGEND

- IRON PIN FOUND/SET
- ⊙ IRON PIPE
- (O) OBSERVED

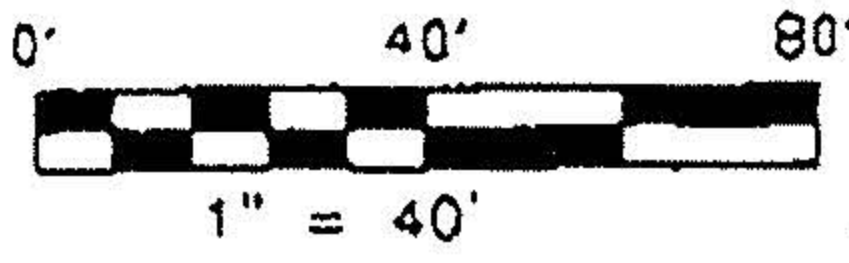

THIS SURVEY WAS PERFORMED TO AN ACCURACY AS SET FORTH IN THE 1997 OHIO ADMINISTRATIVE CODE 4733-37.

DATE: July 20, 2000

*[Signature]*  
TIMOTHY E. STOCKER, P.S. 7245



DRN: SCL	JOB: 2528	REV.
DATE: 02/20/00		
14405469691 P.01/01		

06-24-148-000-00