

KLEINOEDER · SCHMIDT

and ASSOCIATES

ENGINEERS — SURVEYORS — CONSULTANTS in LAND PLANNING

ELYRIA · NORWALK · MEDINA


OHIO

SURVEY

Sublot(s) 1879
10-143
 Subd'n 011

Township ELYRIA Tract EAST OF BLACK RIVER
 Orig. Lot(s) 1 & 7 Sec. _____
 County of LOBAIN State of Ohio
 Corporation CITY OF ELYRIA

(25) 6-143 East of River

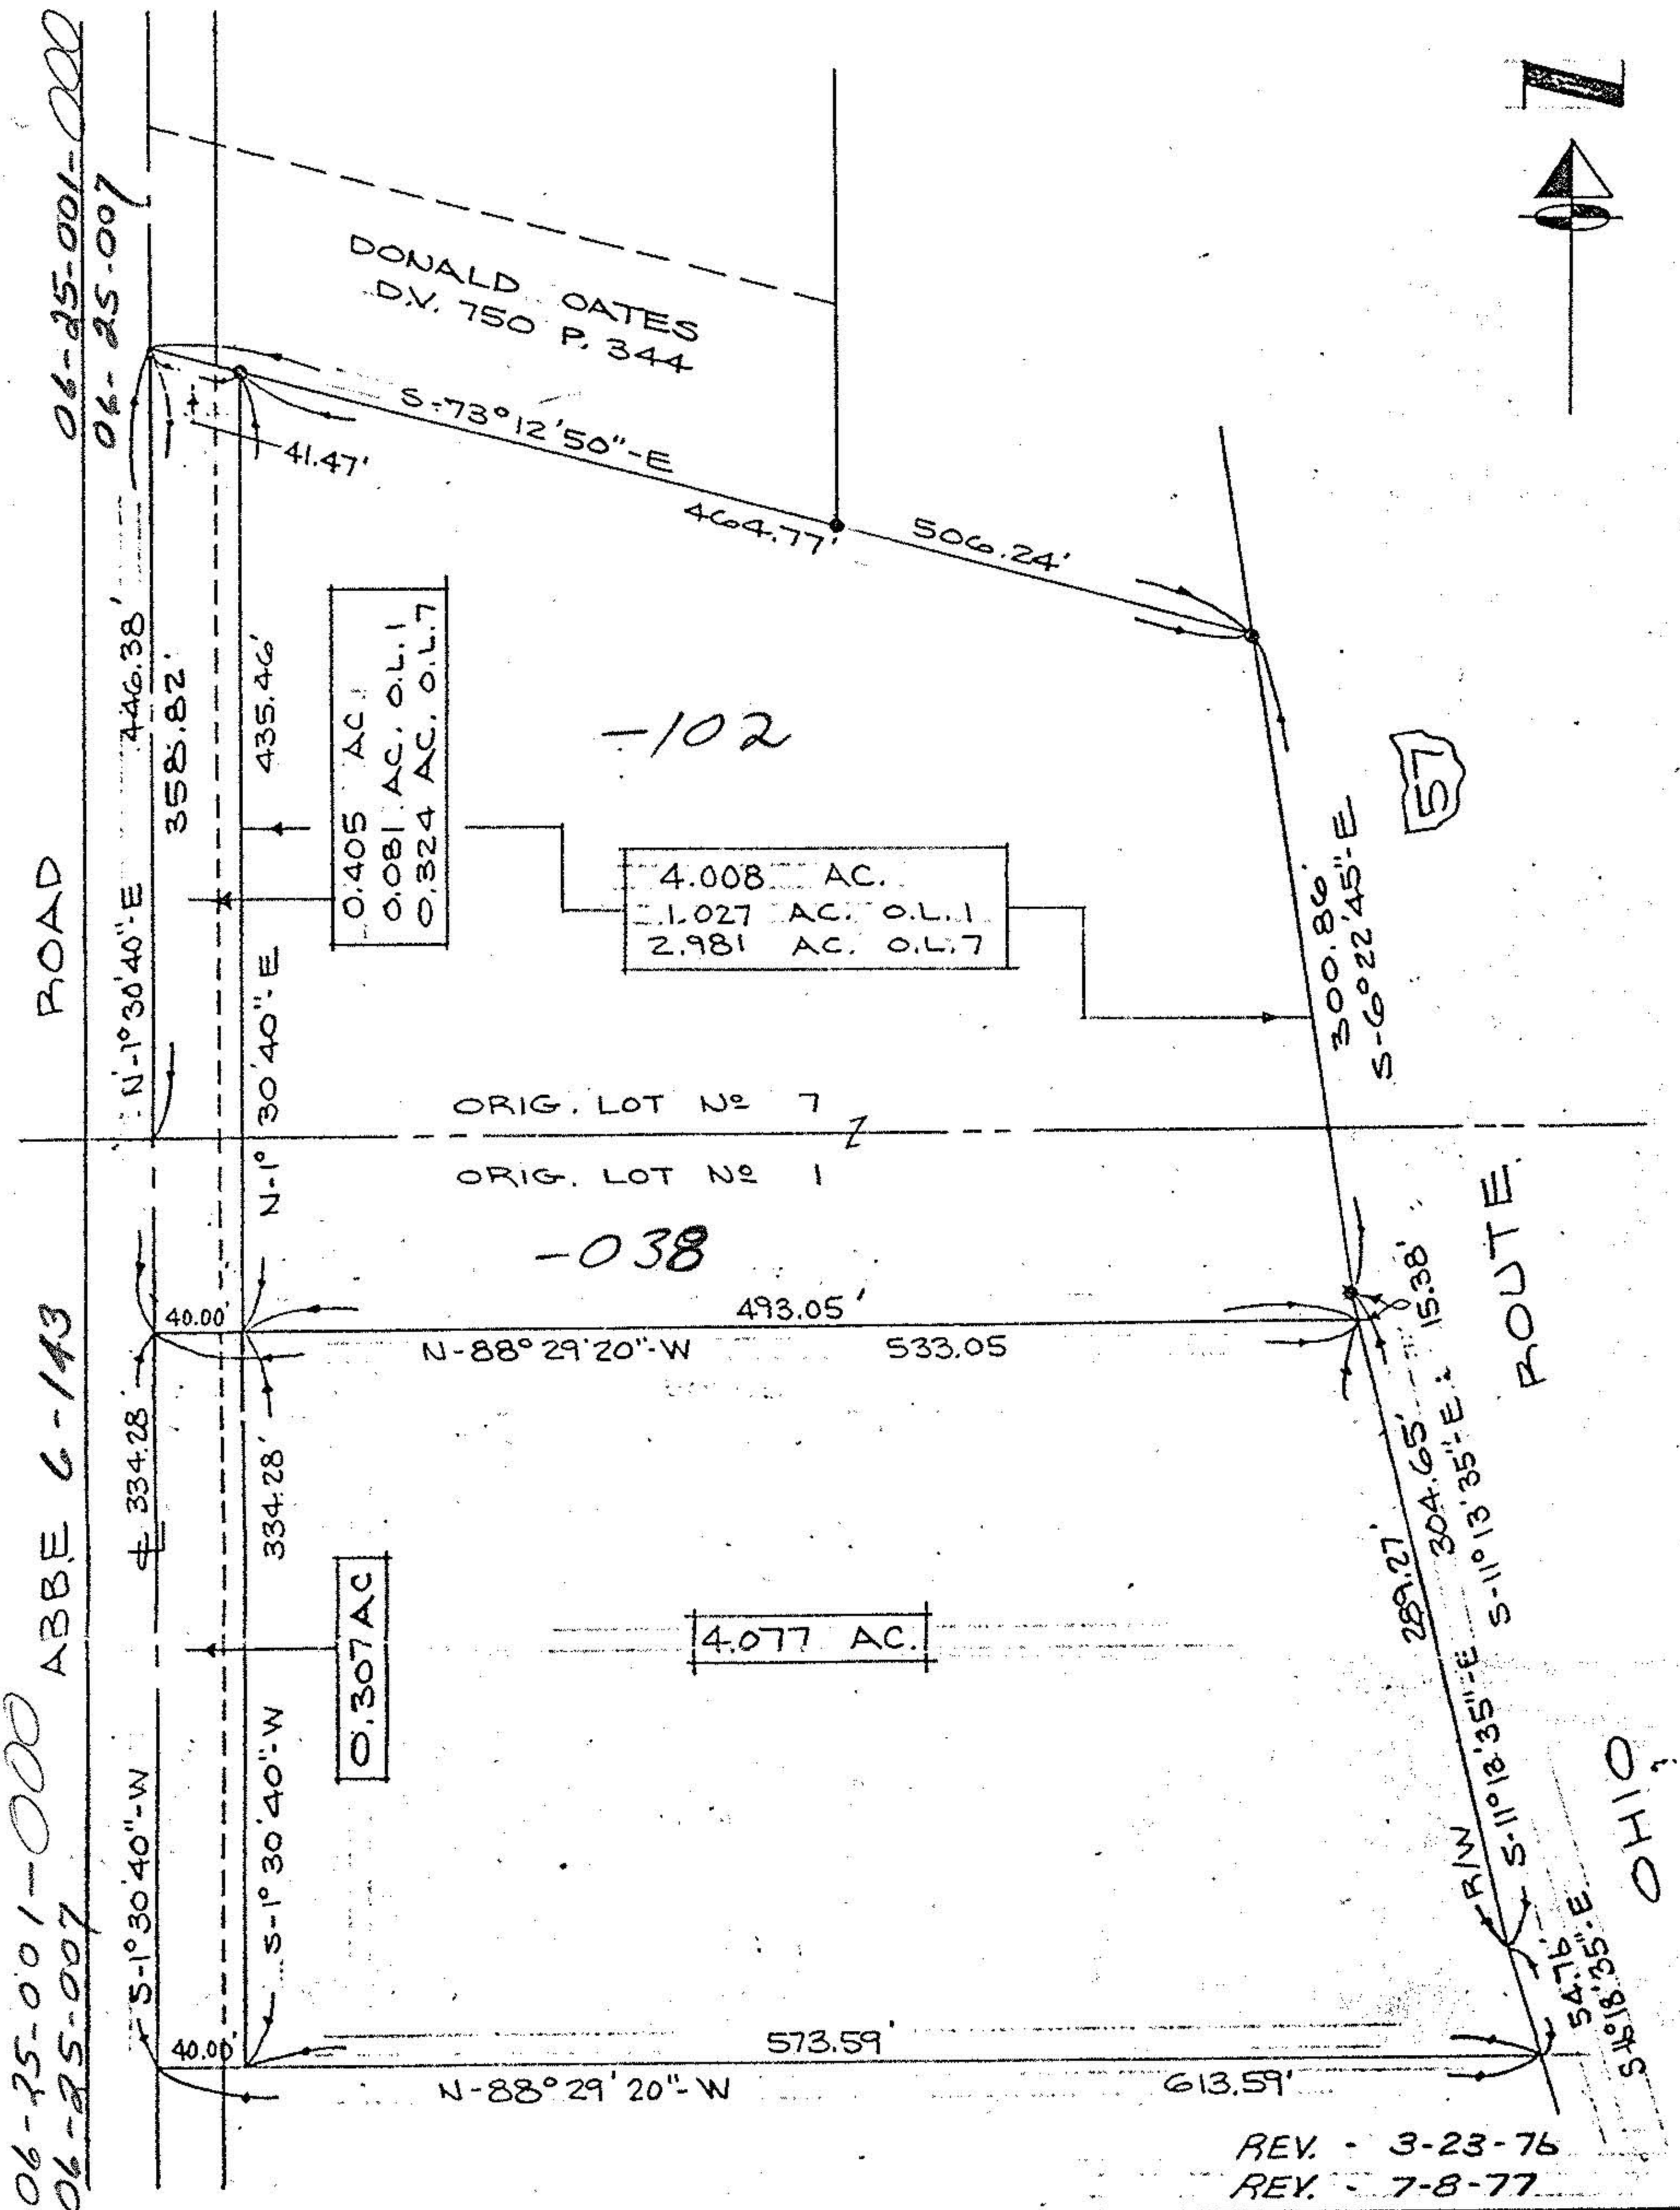

REV. - 3-23-76
 REV. - 7-8-77

Prepared for:

Scale: 1" = 100'

Date: MAR. 22 '76

Dr. by: *DE.*

Job No 7219