

TEMPLE BAPTIST CHURCH
D.V. 1071 P. 318

I.P. FD.
0.02' S.
0.01' W.

STONE FD. & USED

S 01°57'31" W

BARBARA BACSI
O.R.V. 340 P. 213

N 88°49'58" W

N 88°49'58" W
682.72
+683.26*

APPROVED FOR RECORD MAP DEPT	DATE 10-30-95	PAGE G-143	BY CAROLYN FRANCIS	# 21584
------------------------------	---------------	------------	--------------------	---------

21584
21584

I.P. FD. & USED

MON. BOX FD.
MON. BOX FD.
QUEEN ANNE CIRCLE 60'
N 02°00'00" E 515.00'

OAKDALE ESTATES
SUBDIVISION NO. 1
P.V. 54 PG. 36 & 37

13 14 15 16 17

10 11 12 19 20 21 22

23 24 25 26 27 28 29 30 31 32 33 34

OAKDALE ESTATES
SUBDIVISION NO. 2
P.V. 55 PG. 61 & 62
62347 AC.

DRIFTWOOD COURT 60'

OAKDALE CIRCLE 60'

Δ = 09°07'29"
R = 190.00'
T = 15.16'
L = 30.26'
C = 30.23'
CB = S 83°23'07" E

S 02°00'00" W 175.00'

S 02°04'25" W

N 11°10'37" E 174.50'

S 84°17'05" E 121.05'

S 87°56'52" E 46.21'

S 87°56'52" E 204.00'

S 87°56'52" E 116.00'

S 87°56'52" E 18.71'

S 87°56'52" E 197.16'

S 87°56'52" E 17.00'

S 87°56'52" E 100.00'

S 2°00'00" W 175.00'

S 1°57'31" W 175.00'

S 02°00'00" W 175.00'

S 02°00'00" W 175.00'

HIGHLAND DEVELOPMENT
O.R.V. 1005 PG. 30
REMAINDER 0.7923 AC.

ABBWOOD LIMITED PARTNERSHIP
D.V. 1389, P. 73

I.P. FD. & USED FOR LINE
17.51' N.
0.08' W.

- 132
49874 AC.

O.R.V. 1127 P. 564 PCL. 1

(4.6350 AC.)

(0.3524 AC.)


(6.4335 AC.)
TOTAL
SE PCL

HIGHLAND DEVELOPMENT CO.
O.R.V. 1127 P. 564 PCL. 2
(REMAINDER 6 5089 AC.)
SE PCL. & W. PCL.

I.P. FD. & USED

SOUTHEAST BY-PASS

57

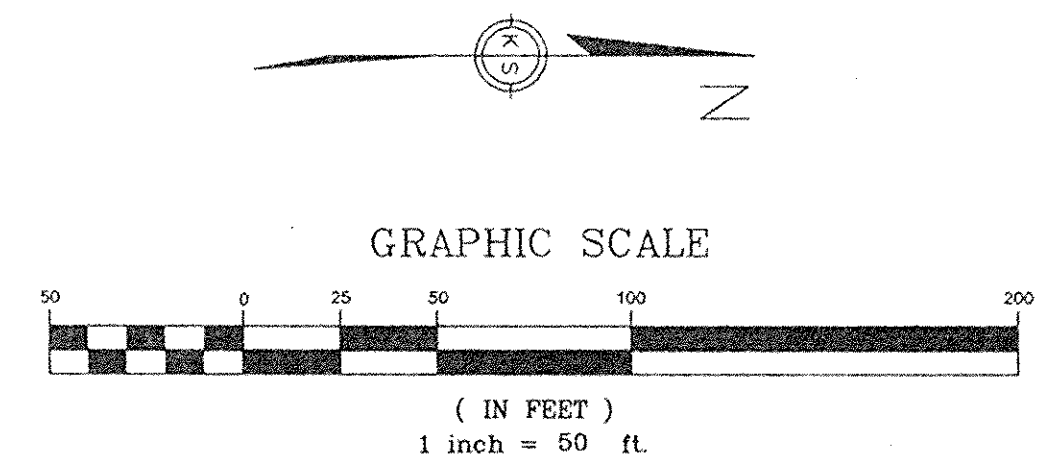

ABBWOOD LIMITED PARTNERSHIP
D.V. 1410, P. 686

I.P. FD. & USED

N 85°30'31" E
133.26'
+132.96'


I.P. FD. & USED

S 23°18'52" E
423.28'
+423.60'

(0.8401 AC.)

* LAUNDON, SIMON, CAHL & ASSOCIATES SURVEY
DATED FEBRUARY 13, 1981 JOB #81-1029

David L. Elwell
DAVID L. ELWELL, P. S. OHIO REG. NO. 6333

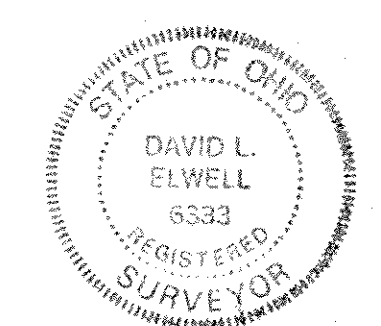

DATE: 09-28-95	
DRAWN BY: DLH	
CHKD BY:	
F.B. 222/224	
DWG. NAME: 93748-240005 SURV MAP	
REVISIONS	
10-27-95	ACREAGE SPLITS
9-28-95	ISSUE DATE

SURVEY MAP
PART OF ORIGINAL ELYRIA TOWNSHIP LOT NO. 1
EAST OF RIVER
CITY OF ELYRIA * COUNTY OF LORAIN * STATE OF OHIO
SEPTEMBER, 1995

KS ASSOCIATES, INC.
ENGINEERS/SURVEYORS
424 Middle Avenue
P.O. Box 89
Elyria, Ohio 44036
ELYRIA (216) 322-6317 * LORAIN (216) 244-5757

ENGINEERS/SURVEYORS
REGISTERED
SURVEYOR

SHEET 1 OF 1
JOB NO. 93746-C

06-25-001-000-