


6-122 06-25-070-103-017

WILLIAM B. BARTON
Reg. Land Surveyor No. 4438
188 PARKWOOD AVENUE
AVON LAKE, OHIO 44012
TELEPHONE (216) 933-6662

#177 E
APPROVAL
12-17-86

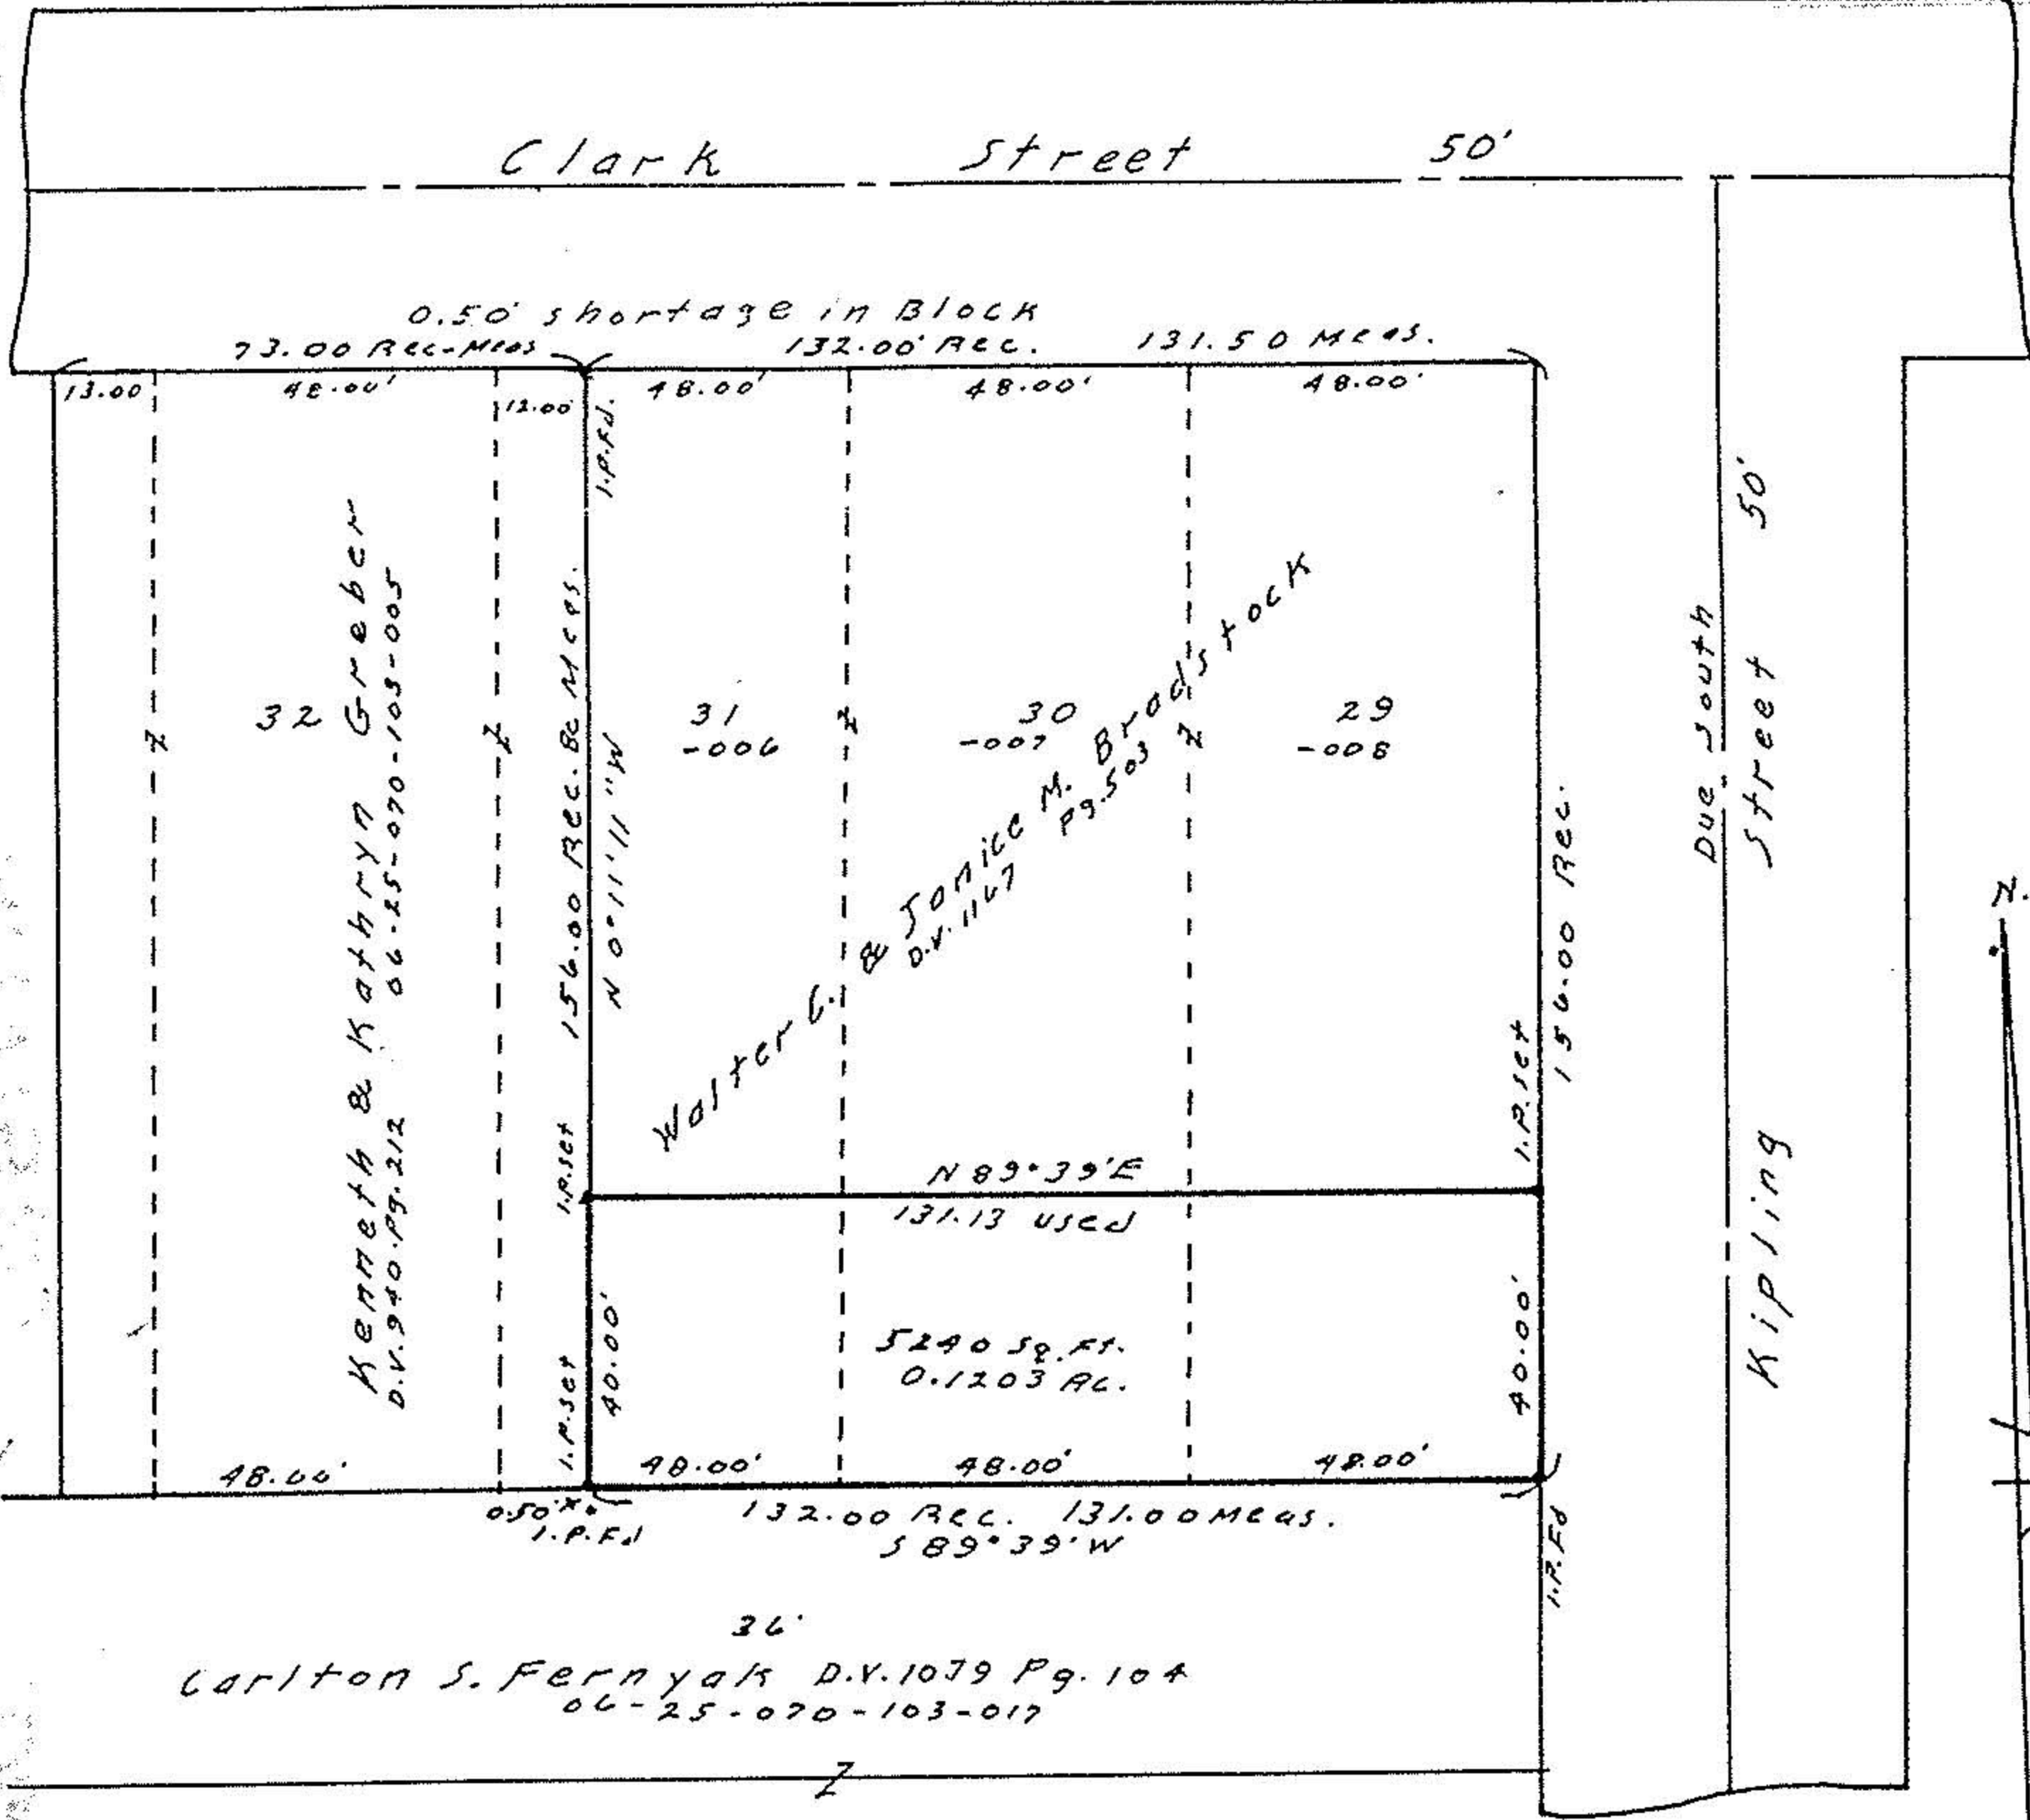

SURVEY
of

Parts of Sublots Nos. 29, 30 & 31 of the S.B. and L.S. Days Subdivision, as recorded in Volume 5, page 12 of Lor. Co. Record of Plats, located in Original Lot No. 70 of Elyria Twp. east of Black River, now the city of Elyria, Lorain County, Ohio. Scale 1"=40'
December 1, 1986

