


#18893

#18894

#18894-A

-179

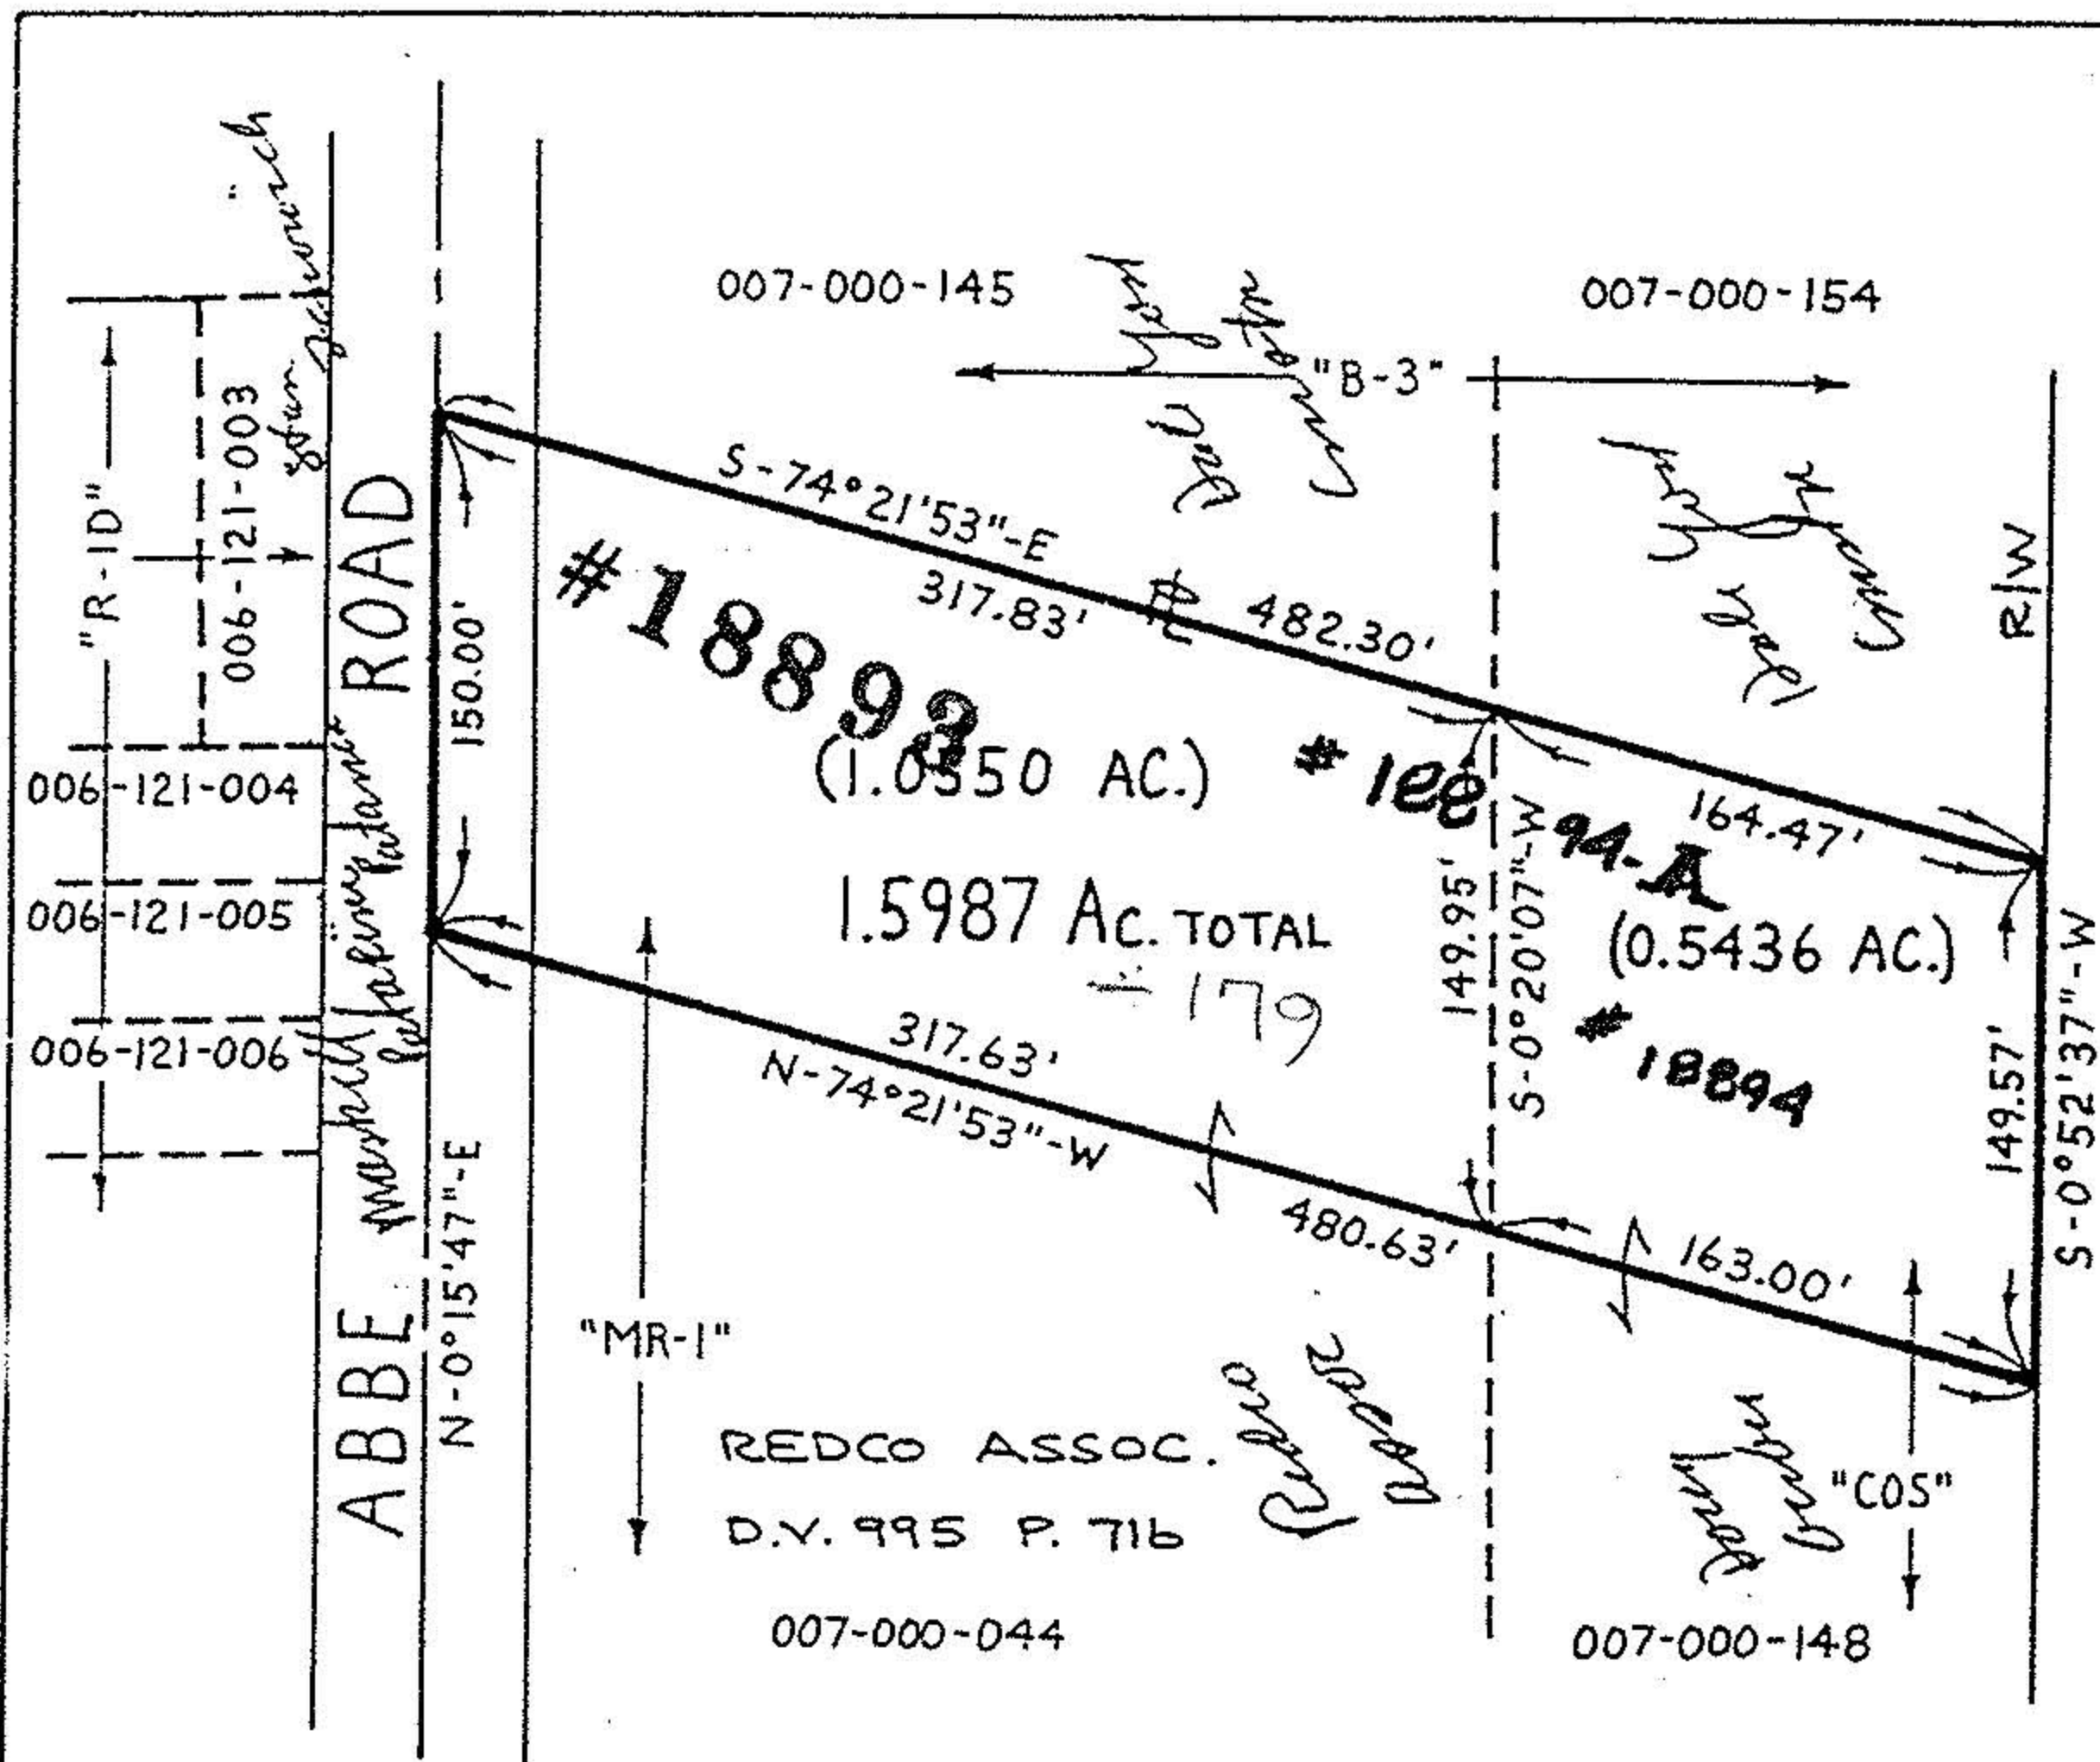

#18893

APPROVED
LORAIN CO.
MAP DEPT.

DATE 3-30-90

PAGE 6-125

BY CAROLYN
FRANCIS

VOID
AFTER #18893

REZONING MAP

PART OF ELYRIA TOWNSHIP
ORIGINAL LOT NUMBER 7
EAST OF BLACK RIVER
CITY OF ELYRIA COUNTY OF LORAIN
STATE OF OHIO

PREPARED BY:
KS ASSOCIATES INC.
ENGINEERS & SURVEYORS



David L. Elwell
DAVID L. ELWELL R.S. NO. 6333

NOTE: PARCEL CURRENTLY ZONED "MR-1" &
"COS". PROPOSED ZONING IS "B-3".

