


- iron pins fd
- iron pins set

Survey for
 Gregory Horan
 PPN 0625017110026
 Instrument No 20010725784
 Original Elyria Twp Lot 17
 East of Black River
 City of Elyria Lorain County
 Ohio Scale 1" = 80' March 2001

John Pozywak #00540-X

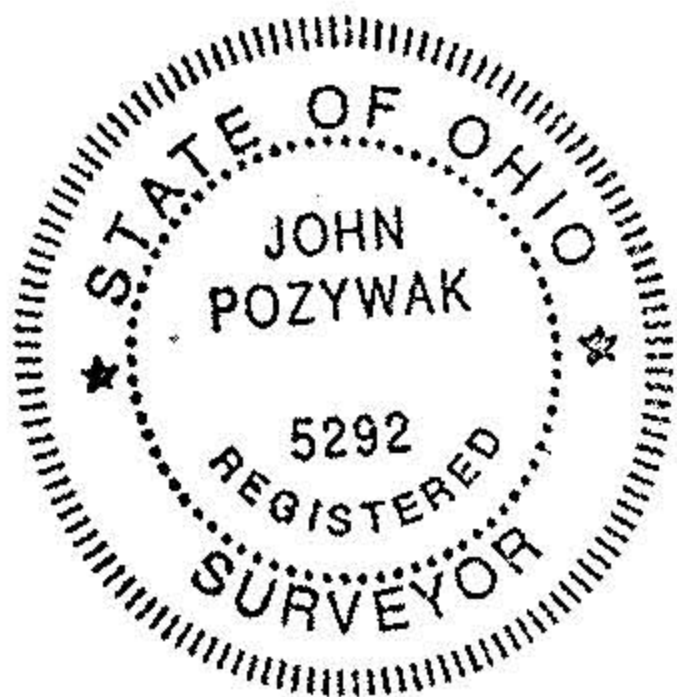

APPROVED
LORAIN CO.
MAP DEPT.
DATE 3-22-01
BOOK 6-105
BY R. MAINES
T. McNAIR
01-00540-X