

BOUNDARY SURVEY

PREPARED FOR: H.U.D.

PERM. PARCEL NUMBER: 06-25-016-108-036

S/L#: MTS.&BDS.

STREET ADDRESS: 516 East Broad St.

IN Elyria Township Lot No.16

SUBDIVISION

CITY OF: Elyria


COUNTY OF: Lorain

STATE OF: OHIO

DATE: 17, November 1999

JOB NO.: 4016

MACKAY
 Engineering & Surveying Company
 7017 Pearl Road, Cleveland, Ohio 44130
 (440) 886-4500 (440) 886-4500 Fax
 Email: mackay@en.com

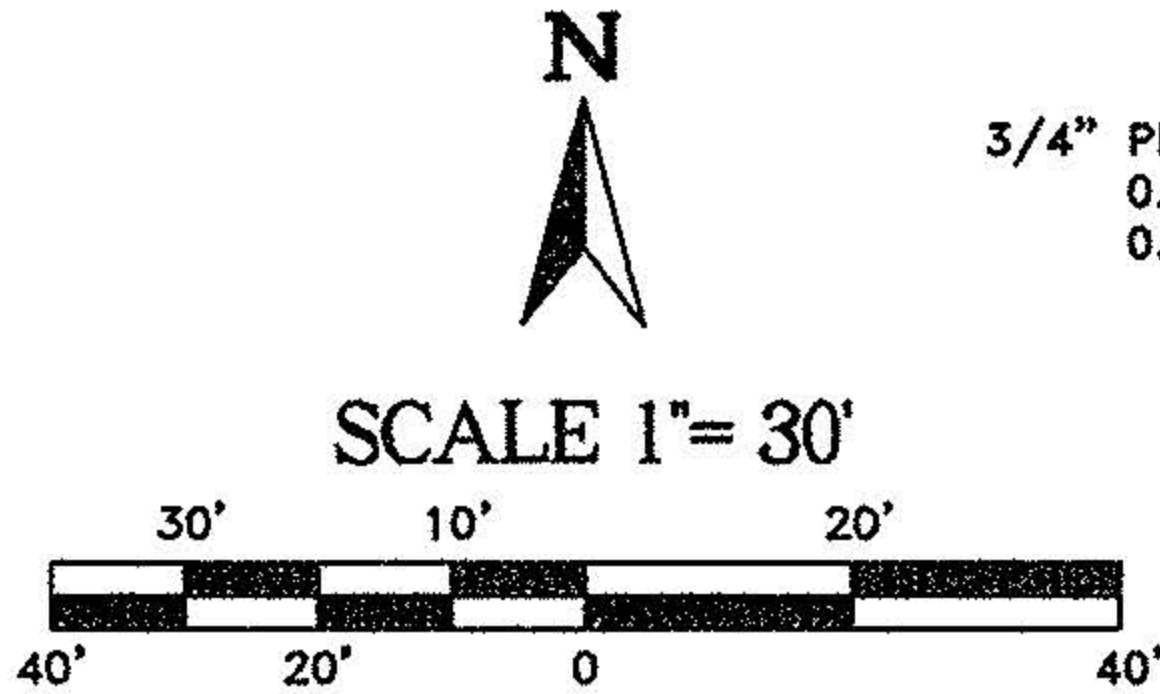

OUR 5' CHAIN LINK FENCE ENCROACHES
 PROPERTY LINE 0.3'±

LEGEND:

- ××× FENCE
- 3/4" PIPE
- ▲ 5/8" IRON PIN W/CAP
- STONE MARKER
- 1/2" PIPE
- DEED DISTANCE FOUND IN DEED
- FD.&U. FOUND AND USED
- R.&U. RECORDED & USED
- OBS. OBSERVED

NEIGHBOR'S 4' CHAIN LINK FENCE
 ENCROACHES PROPERTY LINE 0.7'±



Richard R. Mackay
 RICHARD R. MACKAY
 REG# 4195

