


SURVEY MAP

PART OF ORIGINAL ELYRIA TOWNSHIP LOT NO. 16
 EAST OF BLACK RIVER
 CITY OF ELYRIA COUNTY OF LORAIN
 STATE OF OHIO
 SEPTEMBER 10, 1997





- LEGEND**
- 5/8" CAPPED REBAR SET
 - ⊙ 1" IRON PIN/PIPE FOUND & USED

PROSPECT STREET 60'

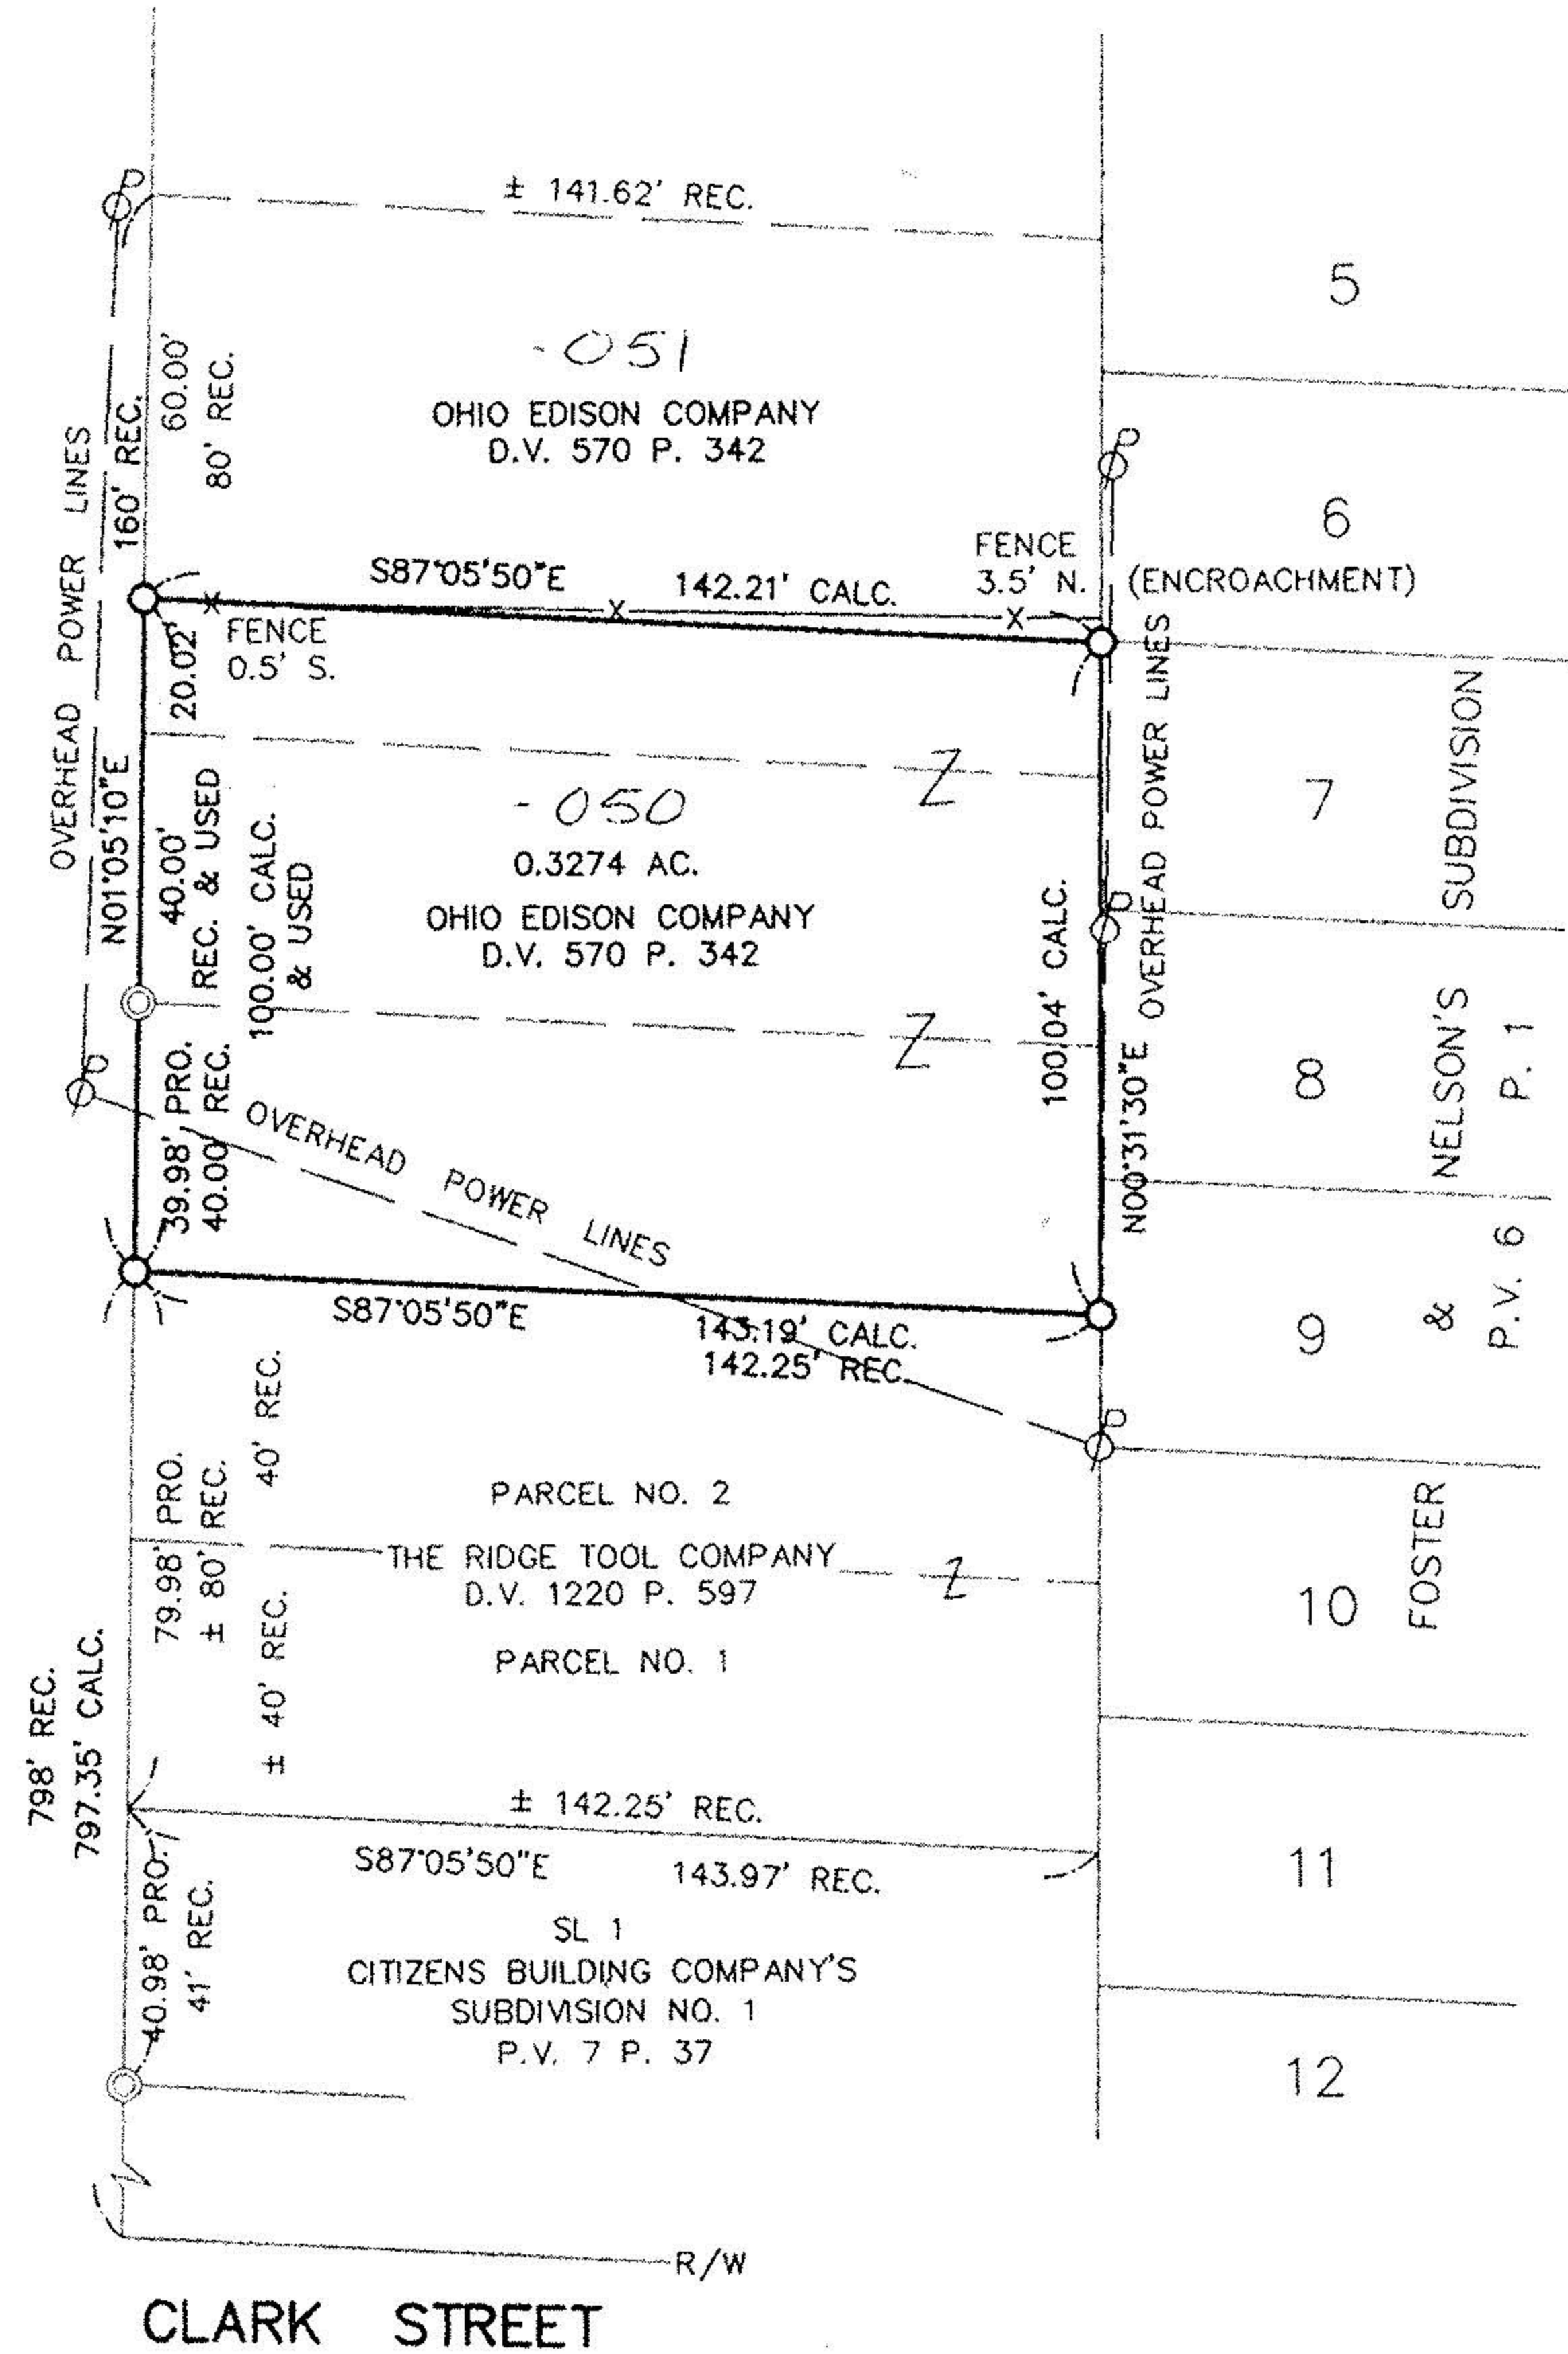

#22342
 APPROVED
 LORAIN CO.
 MAP DEPT
 DATE 11/1/97
 PAGE 6-105
 BY K. COLBERT
 #22342

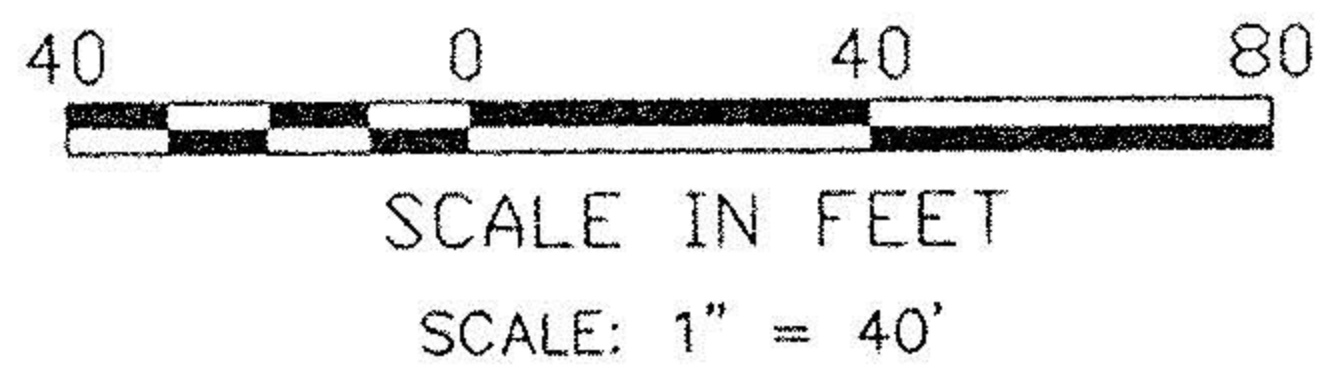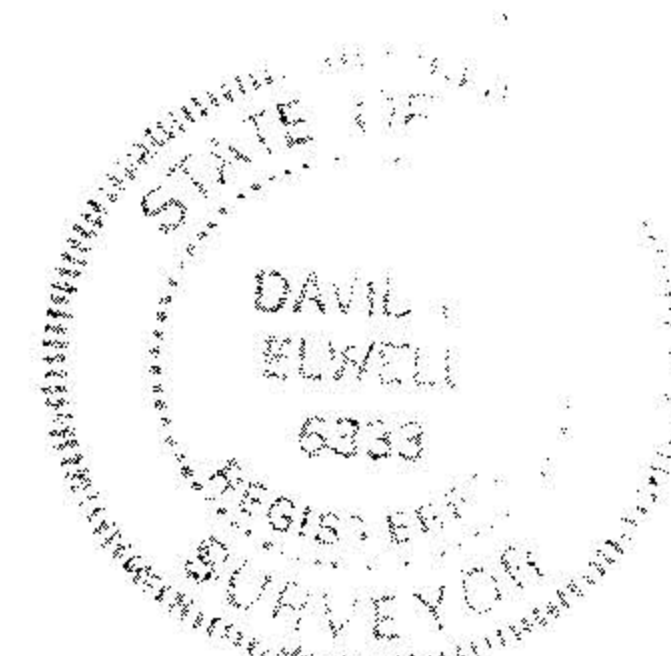

David L. Elwell
 DAVID L. ELWELL, REG. SURVEYOR NO. 6333
 10-14-97

PREPARED BY:
KS ASSOCIATES, INC.
 ENGINEERS SURVEYORS
 JOB NO. 97241