


West line of Allotment 2

195.73 West to I.P. Found
710 ST.

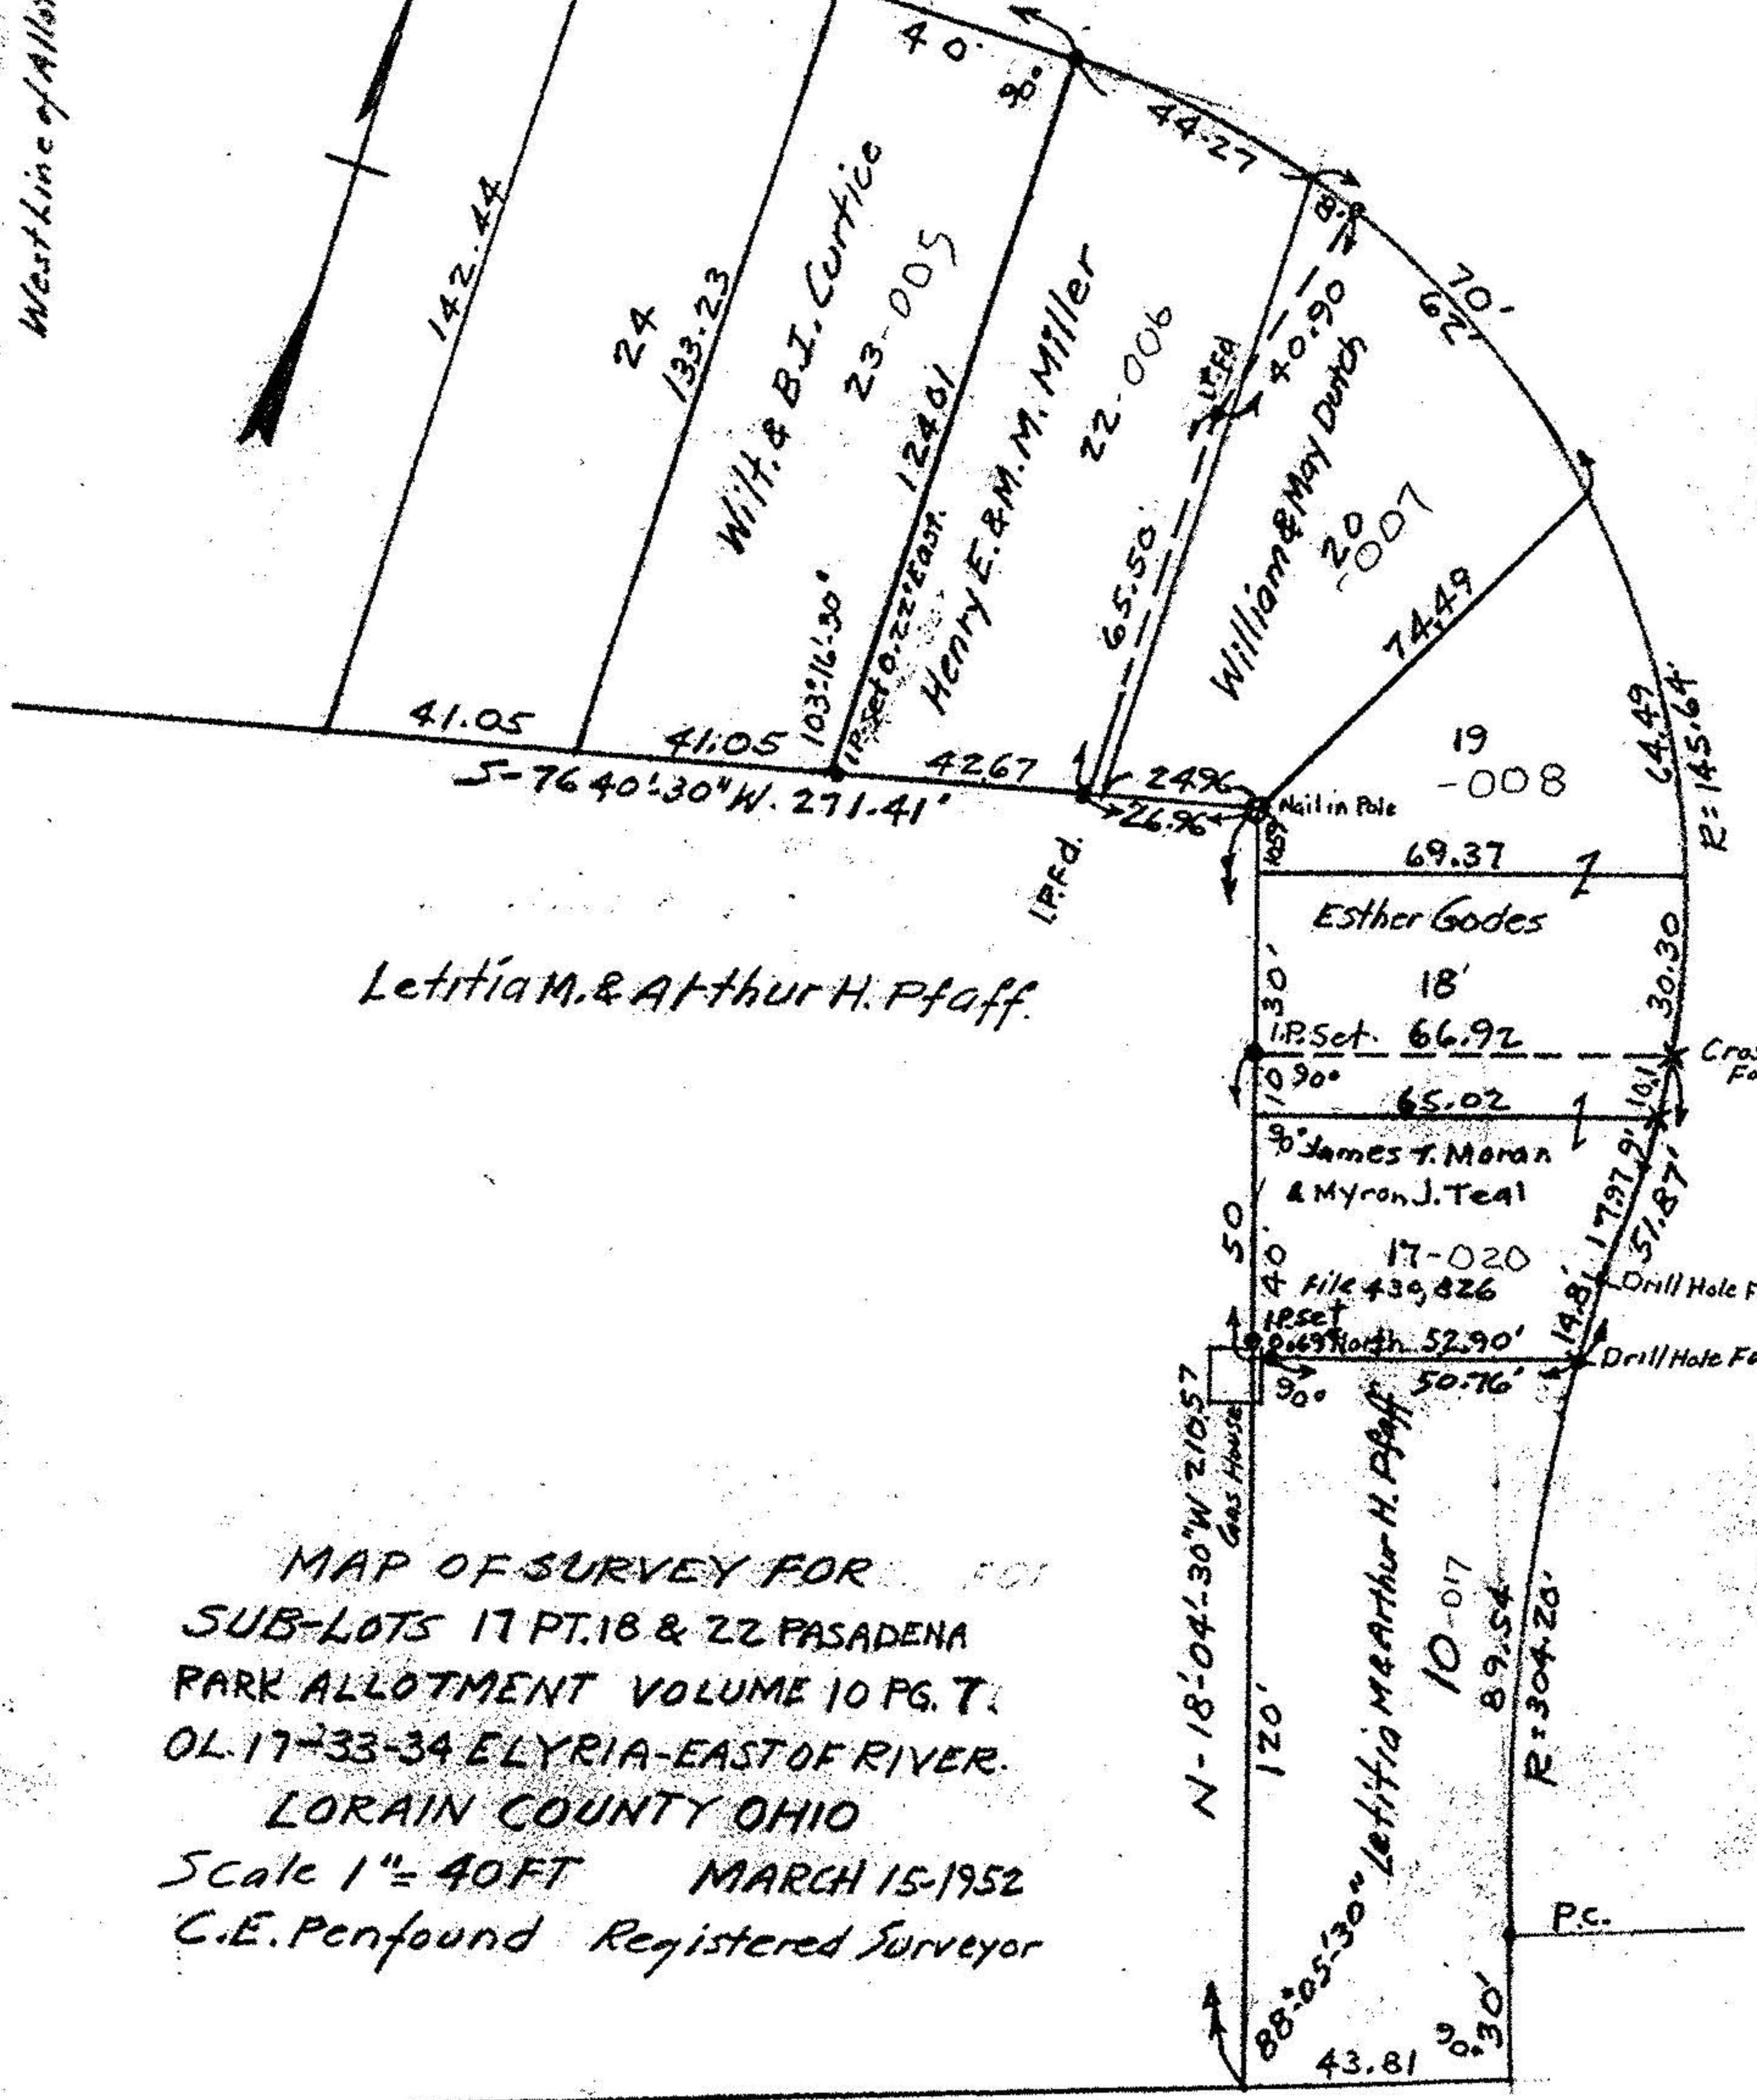

Letitia M. & Arthur H. Pfaff

MAP OF SURVEY FOR
SUB-LOTS 17 PT. 18 & 22 PASADENA
PARK ALLOTMENT VOLUME 10 PG. 7.
OL. 17-33-34 ELYRIA-EAST OF RIVER.
LORAIN COUNTY OHIO
Scale 1" = 40 FT MARCH 15-1952
C.E. Penfound Registered Surveyor

PASADENA AVE.

S-70°-01'-W.

CLEVELAND STREET.