

6-67 6-85
 06-25-161-000
 162-101
 #15224
 6-67
 6-85



KLEINOEDER · SCHMIDT


and ASSOCIATES

ENGINEERS — SURVEYORS — CONSULTANTS IN LAND PLANNING
 ELYRIA · NORWALK · MEDINA OHIO

SURVEY

Sublot(s) 5 & 6, SECTION A
 Subd'n GULF FARMS ALLOT.
P.V. 10 P. 24

Township ELYRIA Tract EAST OF THE RIVER
 Orig. Lot(s) 161 & 162 Sec. _____
 County of LORAIN State of Ohio
 Corporation ELYRIA

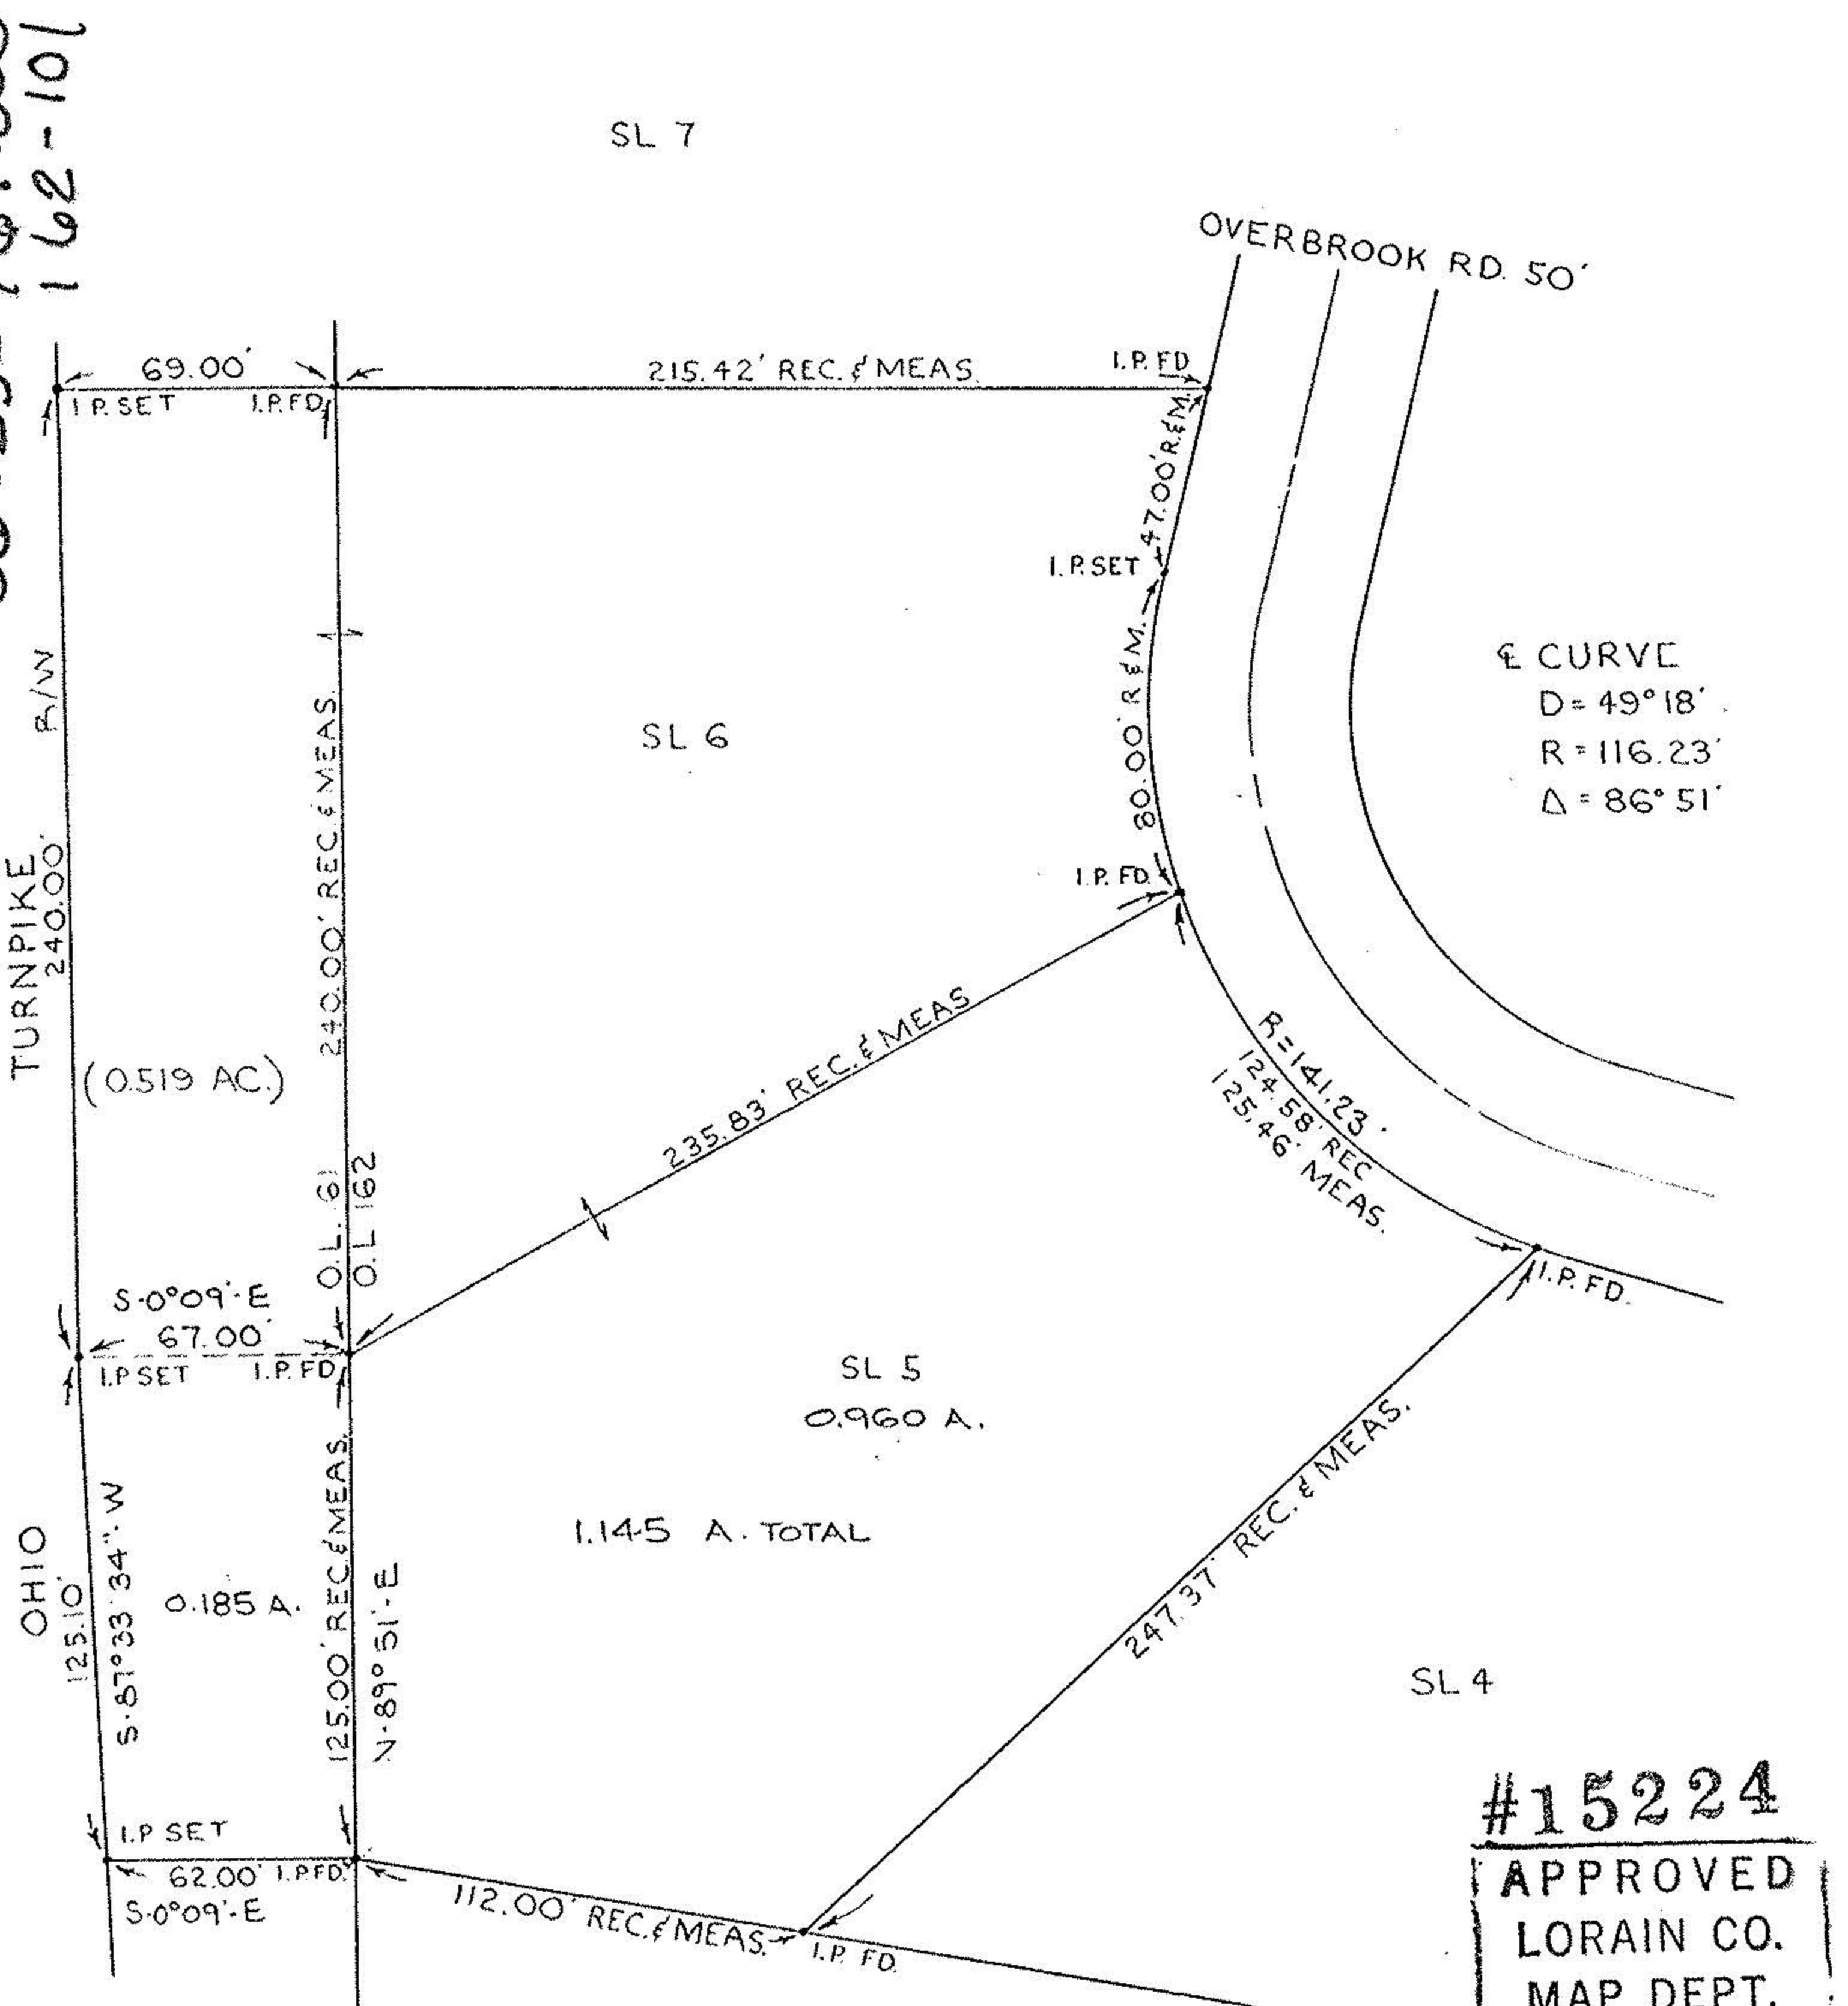

1.145 A. TOTAL

#15224
 APPROVED
 LORAIN CO.
 MAP DEPT.
 DATE 8-25-83
 PAGE 6-67 & 6-85
 BY T.M. Main
 VOID AFTER

Prepared for: HARVEY C. HATFIELD

REVISED 8-12-83

Scale: 1"=60' Date: NOV. 27, 1974 Dr. by: DLH Job No 74-290