



LAUNDON, SIMON, CAHL & ASSOC. INC.
 CONSULTING ENGINEERS & SURVEYORS
 219 COURT ST. ELYRIA, OHIO 44035

SURVEY FOR:


BOYD CAMERON

Orig. Lot 163	City of ELYRIA	Date OCT. 9, 1987 Scale 1"=40'
Orig. Sec	Village of	Dwn. by R.G.S. Chkd. by C.J.
Tract EAST OF RIVER	County of LORAIN	Job No. 87-1656 F.B. -
Township of ELYRIA	State of OHIO	Printed MAY 24


06-25-163-000-

#18974

6-67

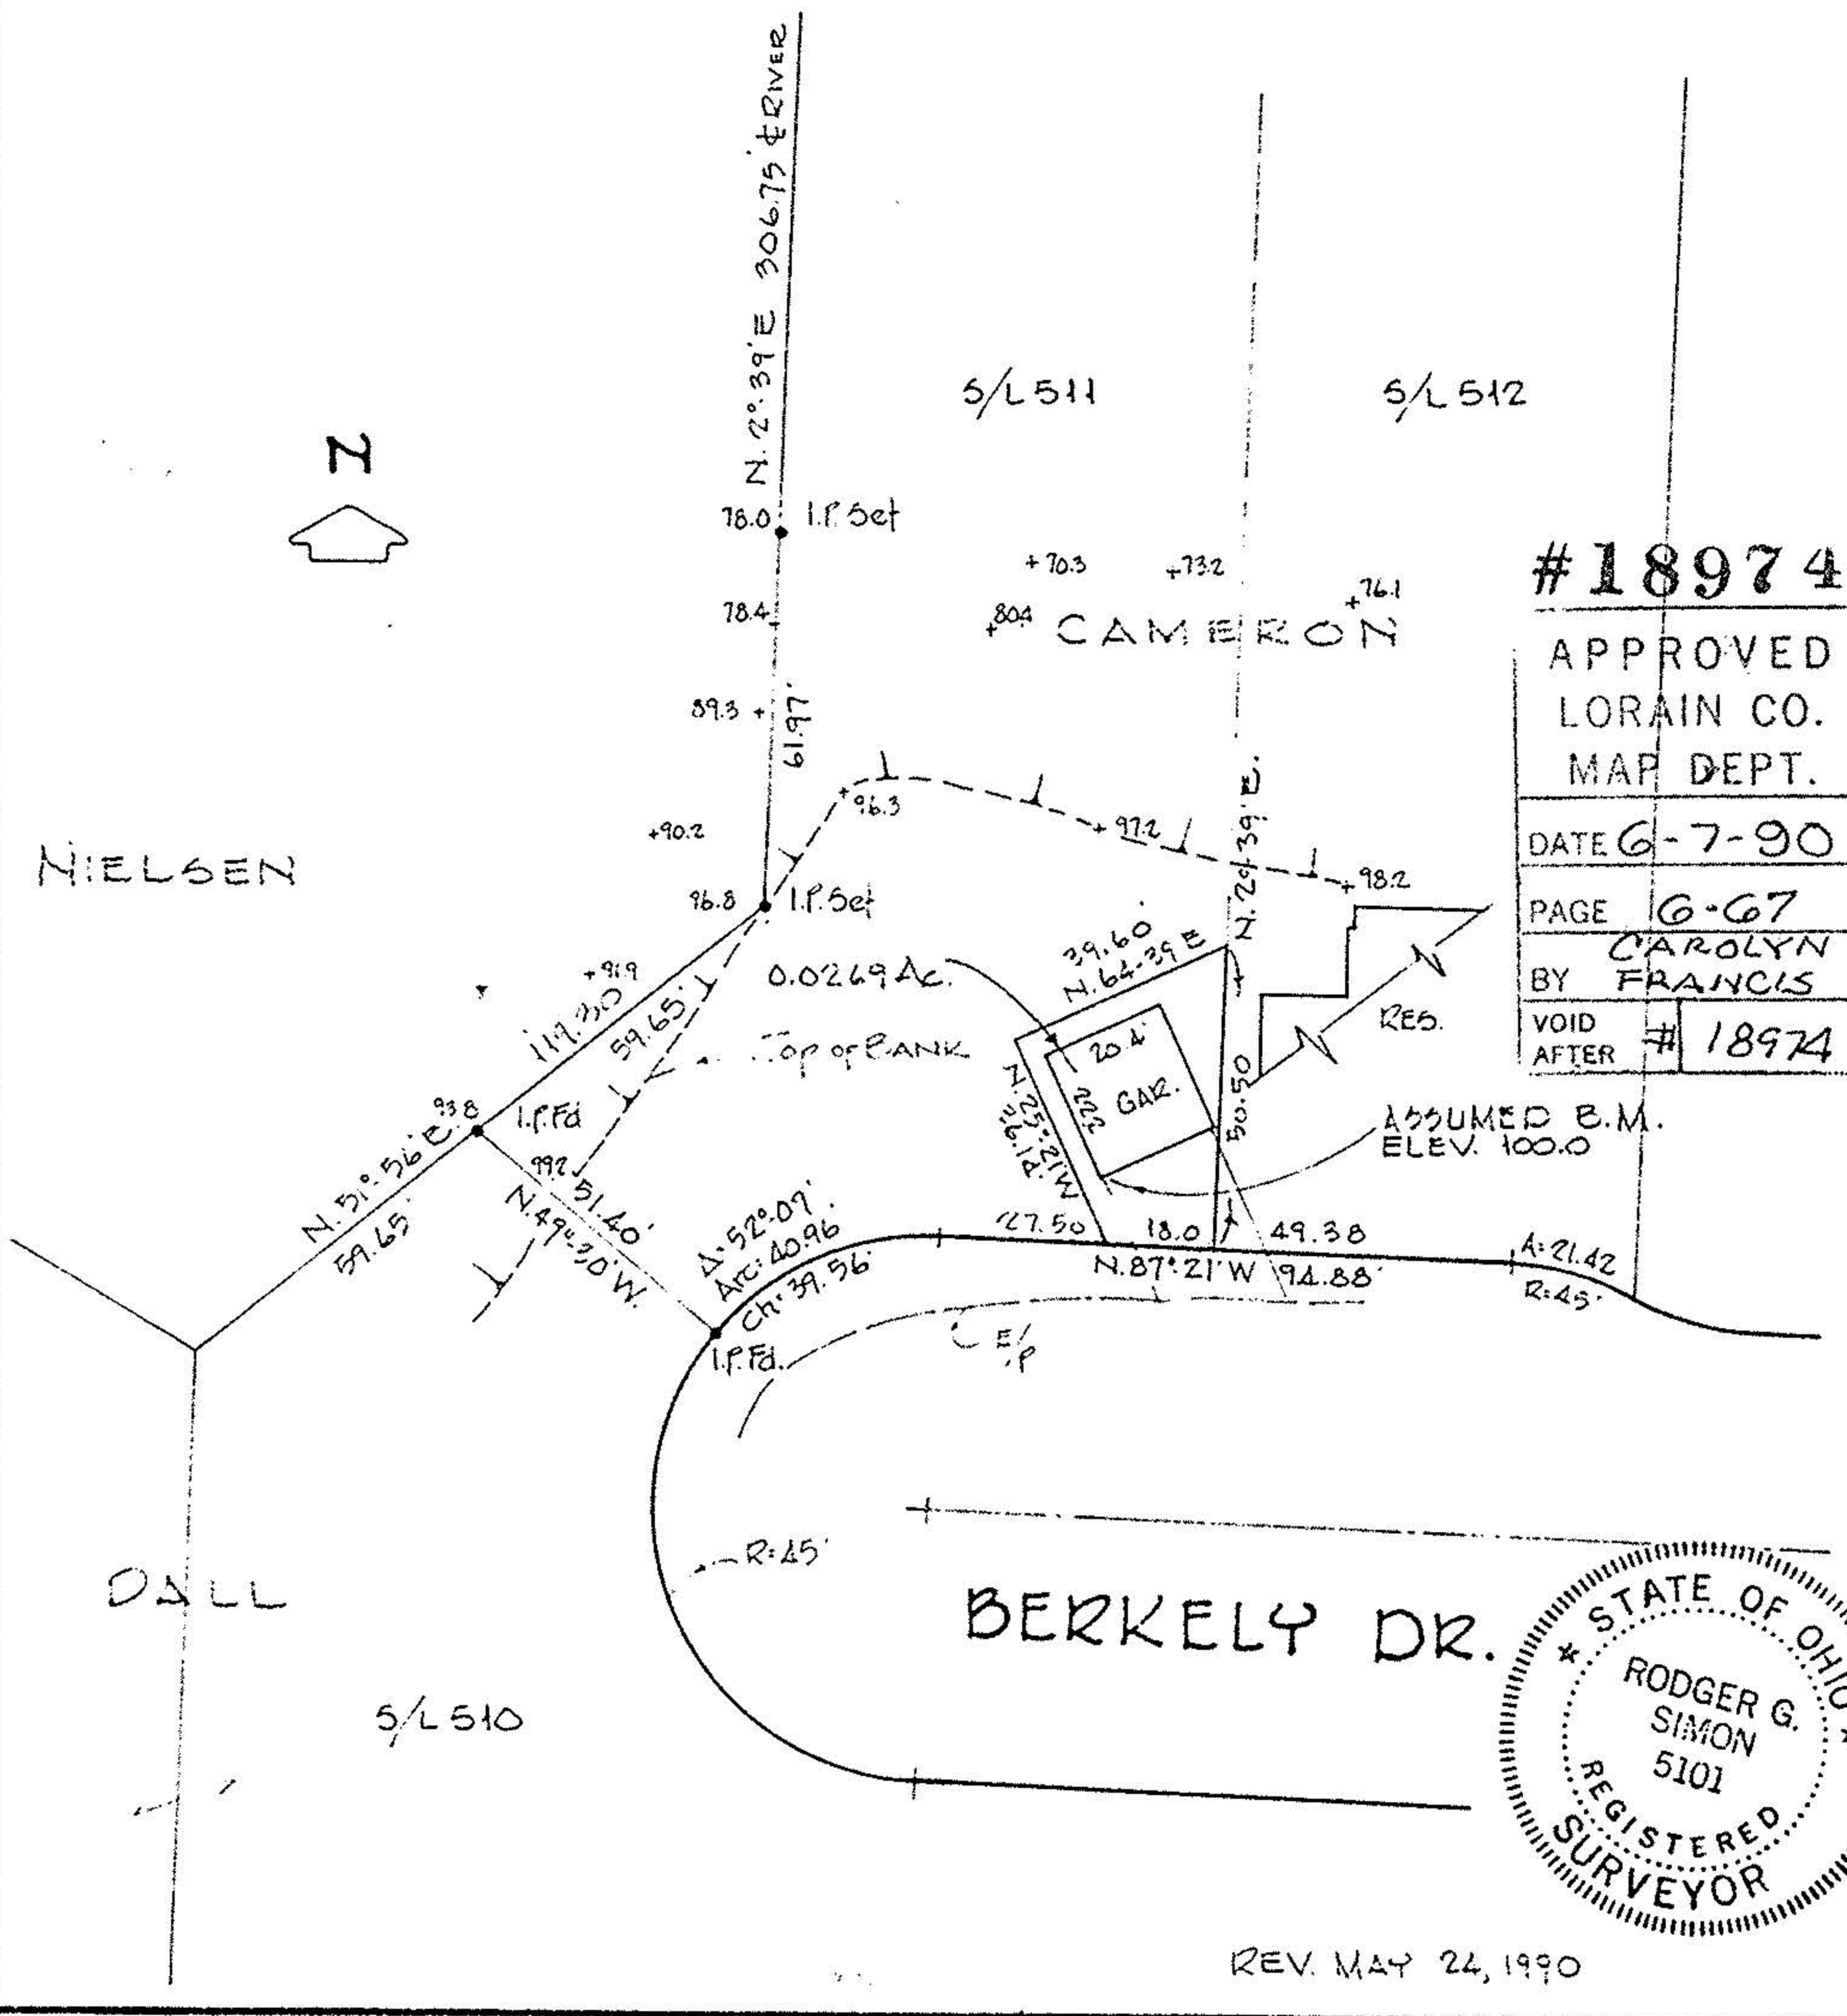

#18974
 APPROVED
 LORAIN CO.
 MAP DEPT.
 DATE 6-7-90
 PAGE 6-67
 BY CAROLYN
 FRANCIS
 VOID AFTER #18974

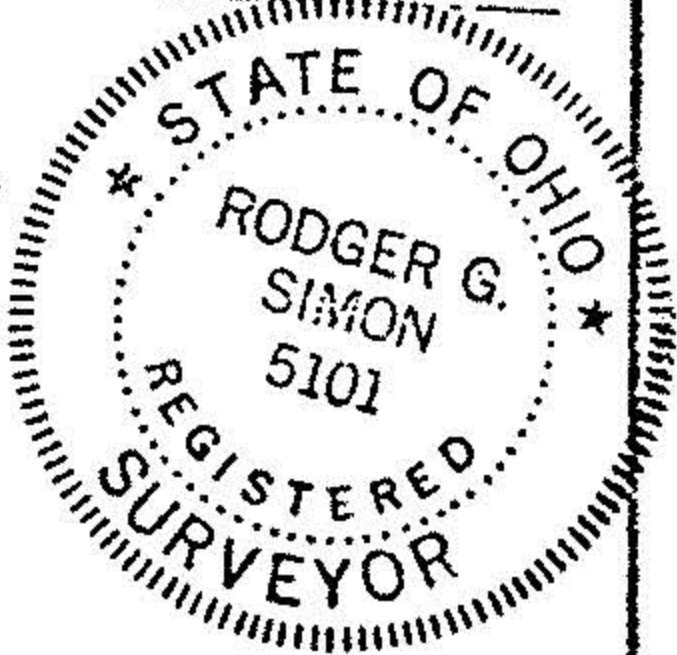

REV. MAY 24, 1990