

Cleveland Road 60' #4556


N 47° 56' E 281.58

1.0301 AC.

07-00-006-102-047

7-00-006-D

N 55° 18' E 101.36  
60.00  
N 39° 49' E 188.57  
52° 29' W 13.35

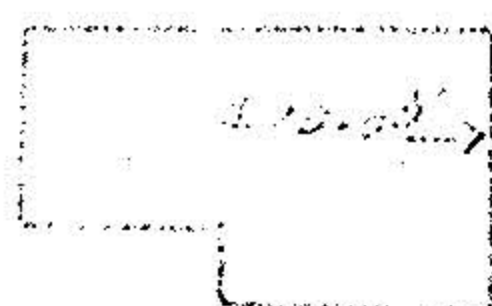

EDWARD W. RATUSZ  
KATHERINE  
0.255 AC.

Parcel A  
Parking Lot

Frank S. Ratusz Vol. 566 Pg. 367  
4-1-53

218.66  
N 46° 36' E 239.96 Meas.  
75.00 I.P. S.E. 53.70'

Frank J. Ratusz  
Vol. 622 Pg. 467 0.667 AC.  
3-17-55

0.1579 AC. EVELYN  
Parcel B  
N 43° 15' W 120.81


1.20.99  
152.05  
Fred & Marg - ret Young Vol. 236 Pg. 277  
4-26-28

1-00-006-1

07-00-006-102-047

SURVEY FOR  
FRANK S. RATUSZ OF PART OF LOT  
NO. 6 RIDGEXVILLE TWP, NOW THE CITY  
OF NORTH RIDGEXVILLE, LORAIN COUNTY  
OHIO. BY WILLIAM B. BARTON REG. SURVEYOR.  
SCALE 1" = 50'

REV. 8-1-70

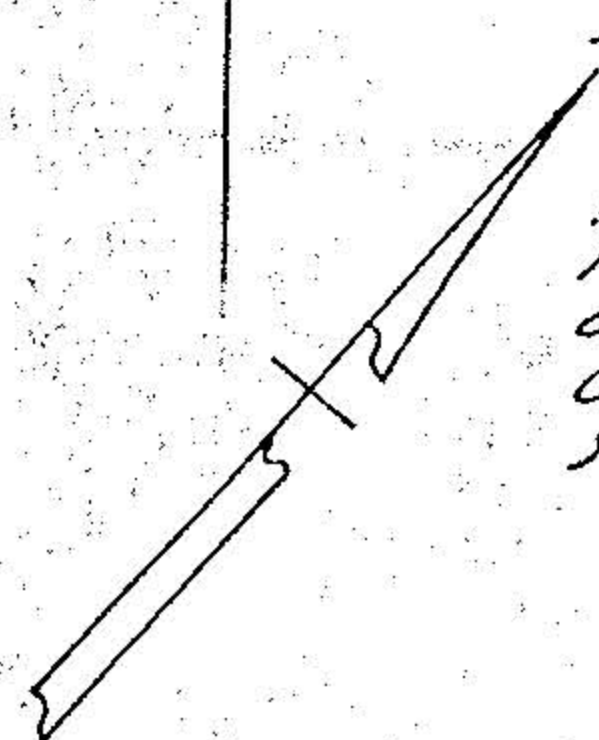

BARTON Rd. 60'

417.00' S 40° 53' E  
121.00'

26.50'

101.34'

29.00'

168.16

26.50' add to the 269.50 trying to connect to the 299.50  
299.50  
299.50  
to the north

M. Co. 2 Copies TAX Map Dept. 4 Copy