




07-08-007-106-016, 017

7-00-007-A

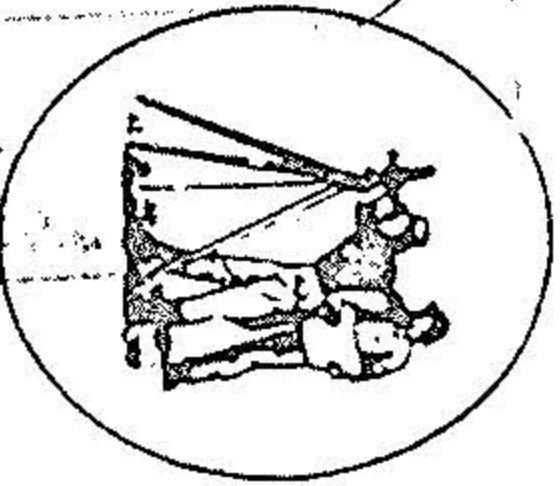

I. R. FOOTE & ASSOCIATES, SURVEYORS
15016 CENTER RIDGE
N. RIDGEVILLE, OHIO 44030
OFFICE 327 4778

DATE: DEC 1978
SCALE: 1"=60'

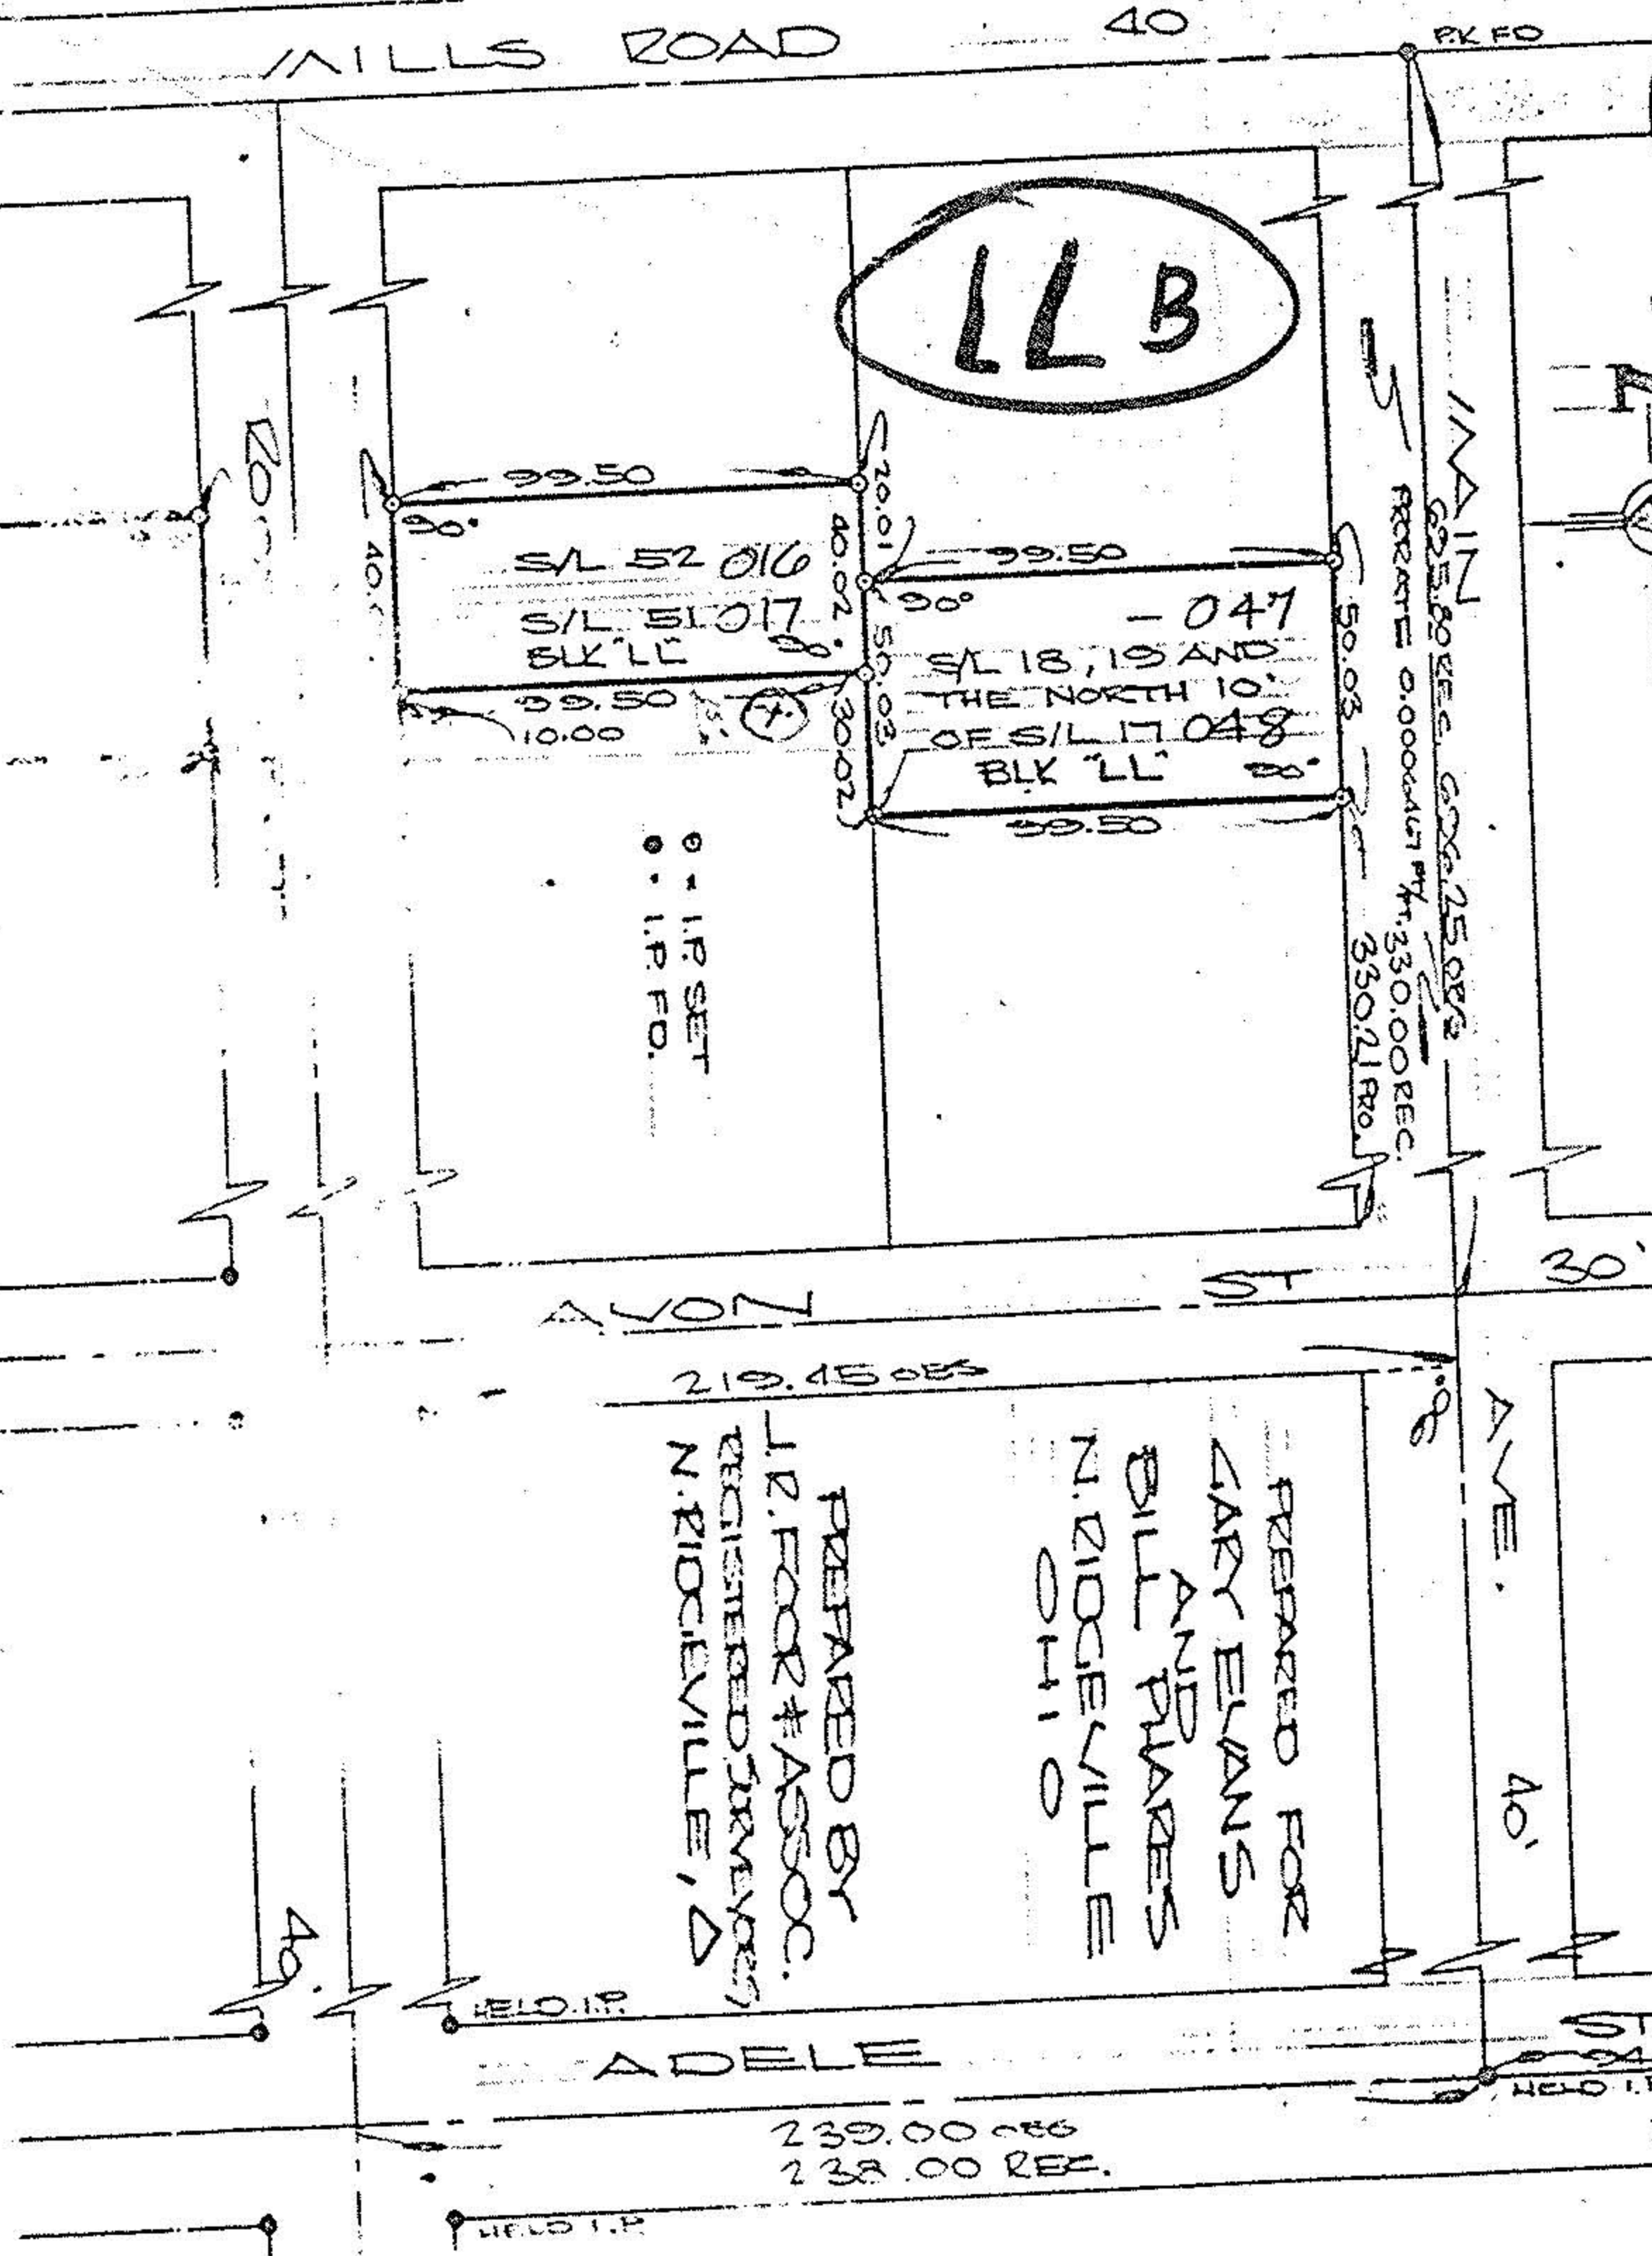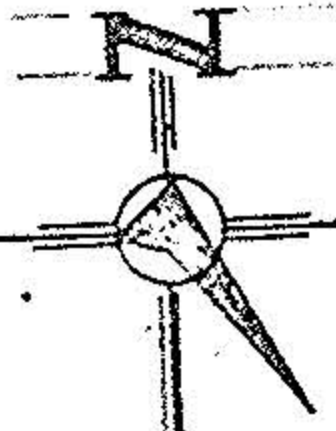

PREPARED FOR
CARY EVANS
AND
BILL PARES
N. RIDGEVILLE
OHIO

PREPARED BY
I.R. FOOTE & ASSOC.
REGISTERED SURVEYORS
N. RIDGEVILLE, OHIO

EXEMPT
OR
SUBJECT NOS
1516 BLOCK "M.M."
AND

52, 51, 19, 18 & NORTH 10' OF 17
BLOCK "L-L"
RIDGEVILLE HTS. SUBD.
N. RIDGEVILLE, OHIO

LEARNAGLE 50'

75-160