
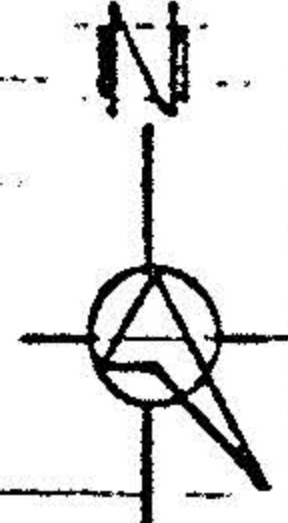


7-00-009-C


7-00-009-C  
07-00-009-117

7-00-009  
7-00-009-C

**J. R. FOOR & ASSOCIATES, SURVEYORS**  
35110 CENTER RIDGE  
N. RIDGEVILLE, OHIO 44030  
OFFICE 327-4278  
HOME 365-0715

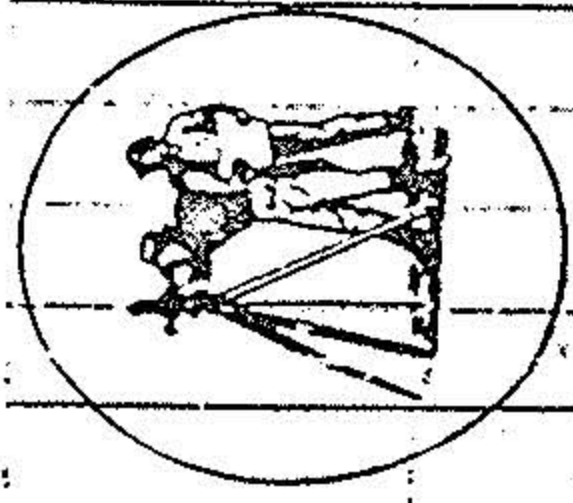

N-4°01'50"-E  
76.50'

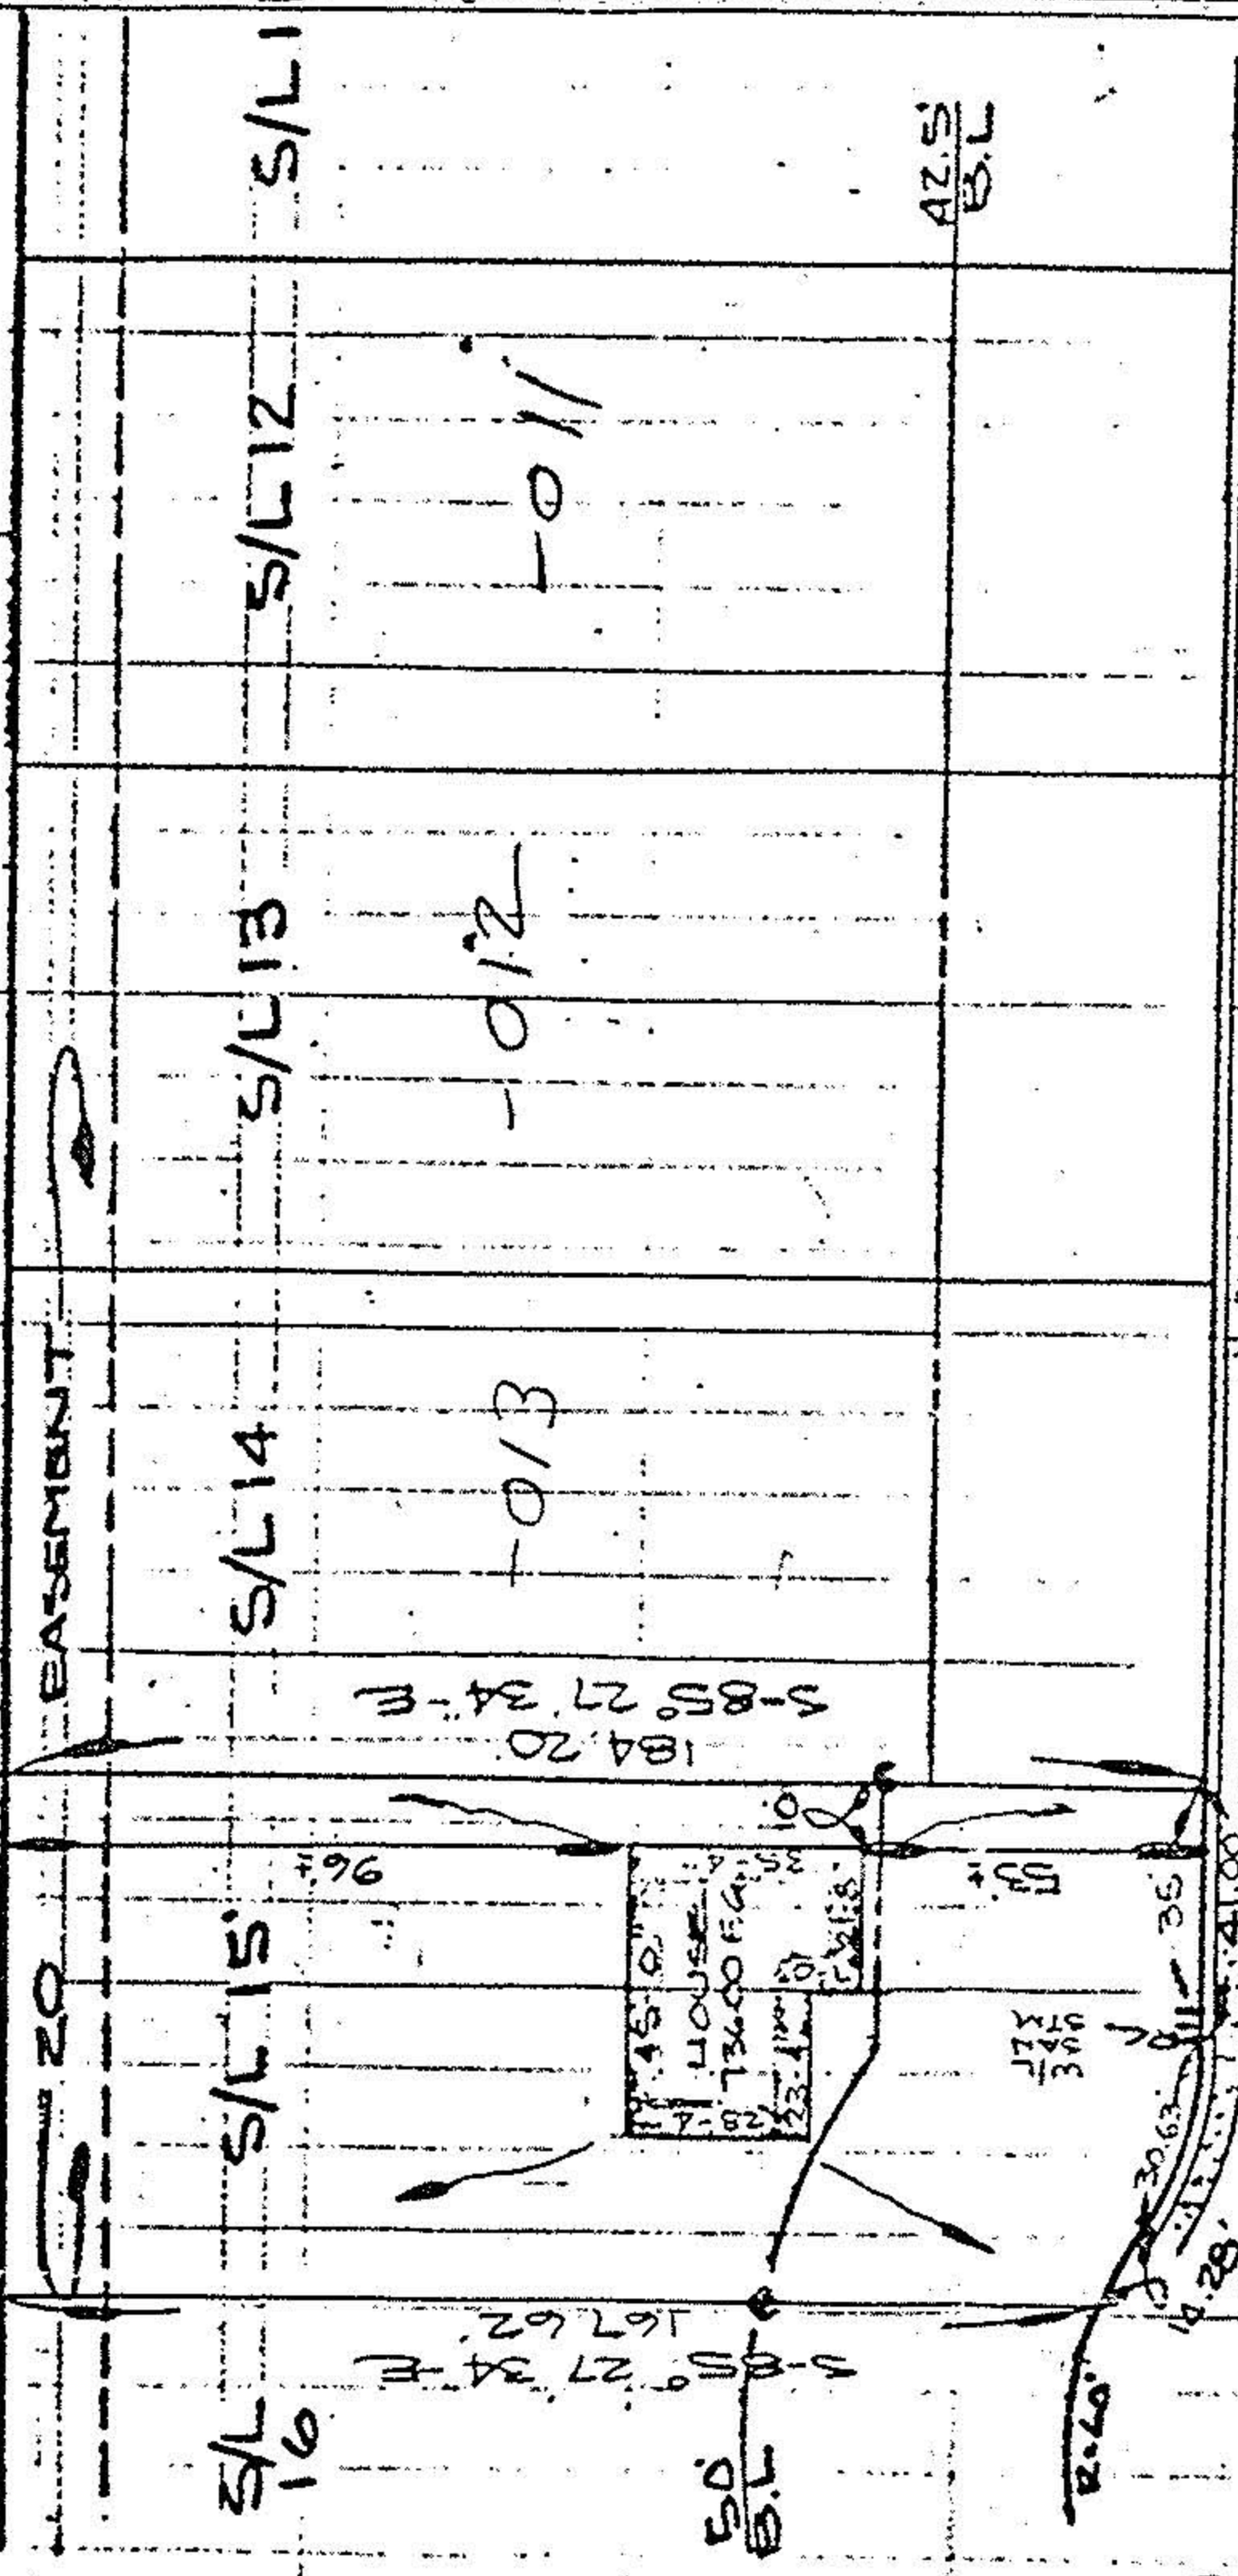

N 04° 33' 26\"/>

D'HENRY CIRCLE 60'

SIDEWALK

PLOT PLAN

OF  
SUBLOT NO 15  
IN

WILLOW PARK SUB #1

PREPARED FOR

GENIE BUILDERS  
CINCINNATI, OHIO

SCALE: 1"=50'

7-00-009

74-247