

DANE A. HAPONEK


Engineers & Surveyors

34100 Center Ridge Road • NORTH RIDGEVILLE, OHIO 44039 (216) 327-4776 • Lorain 288-4400

SURVEY
OF PART OF
SUBLOT N^o 196
IN
WILLOW PARK SUBD N^o 5
PART OF RIDGEVILLE TWP. LOT 9
PLAT VOL. 44 PGS 7 & 8
CITY OF N RIDGEVILLE

STEINBECK
CT 60'

N 02° 38' 05" E MON.

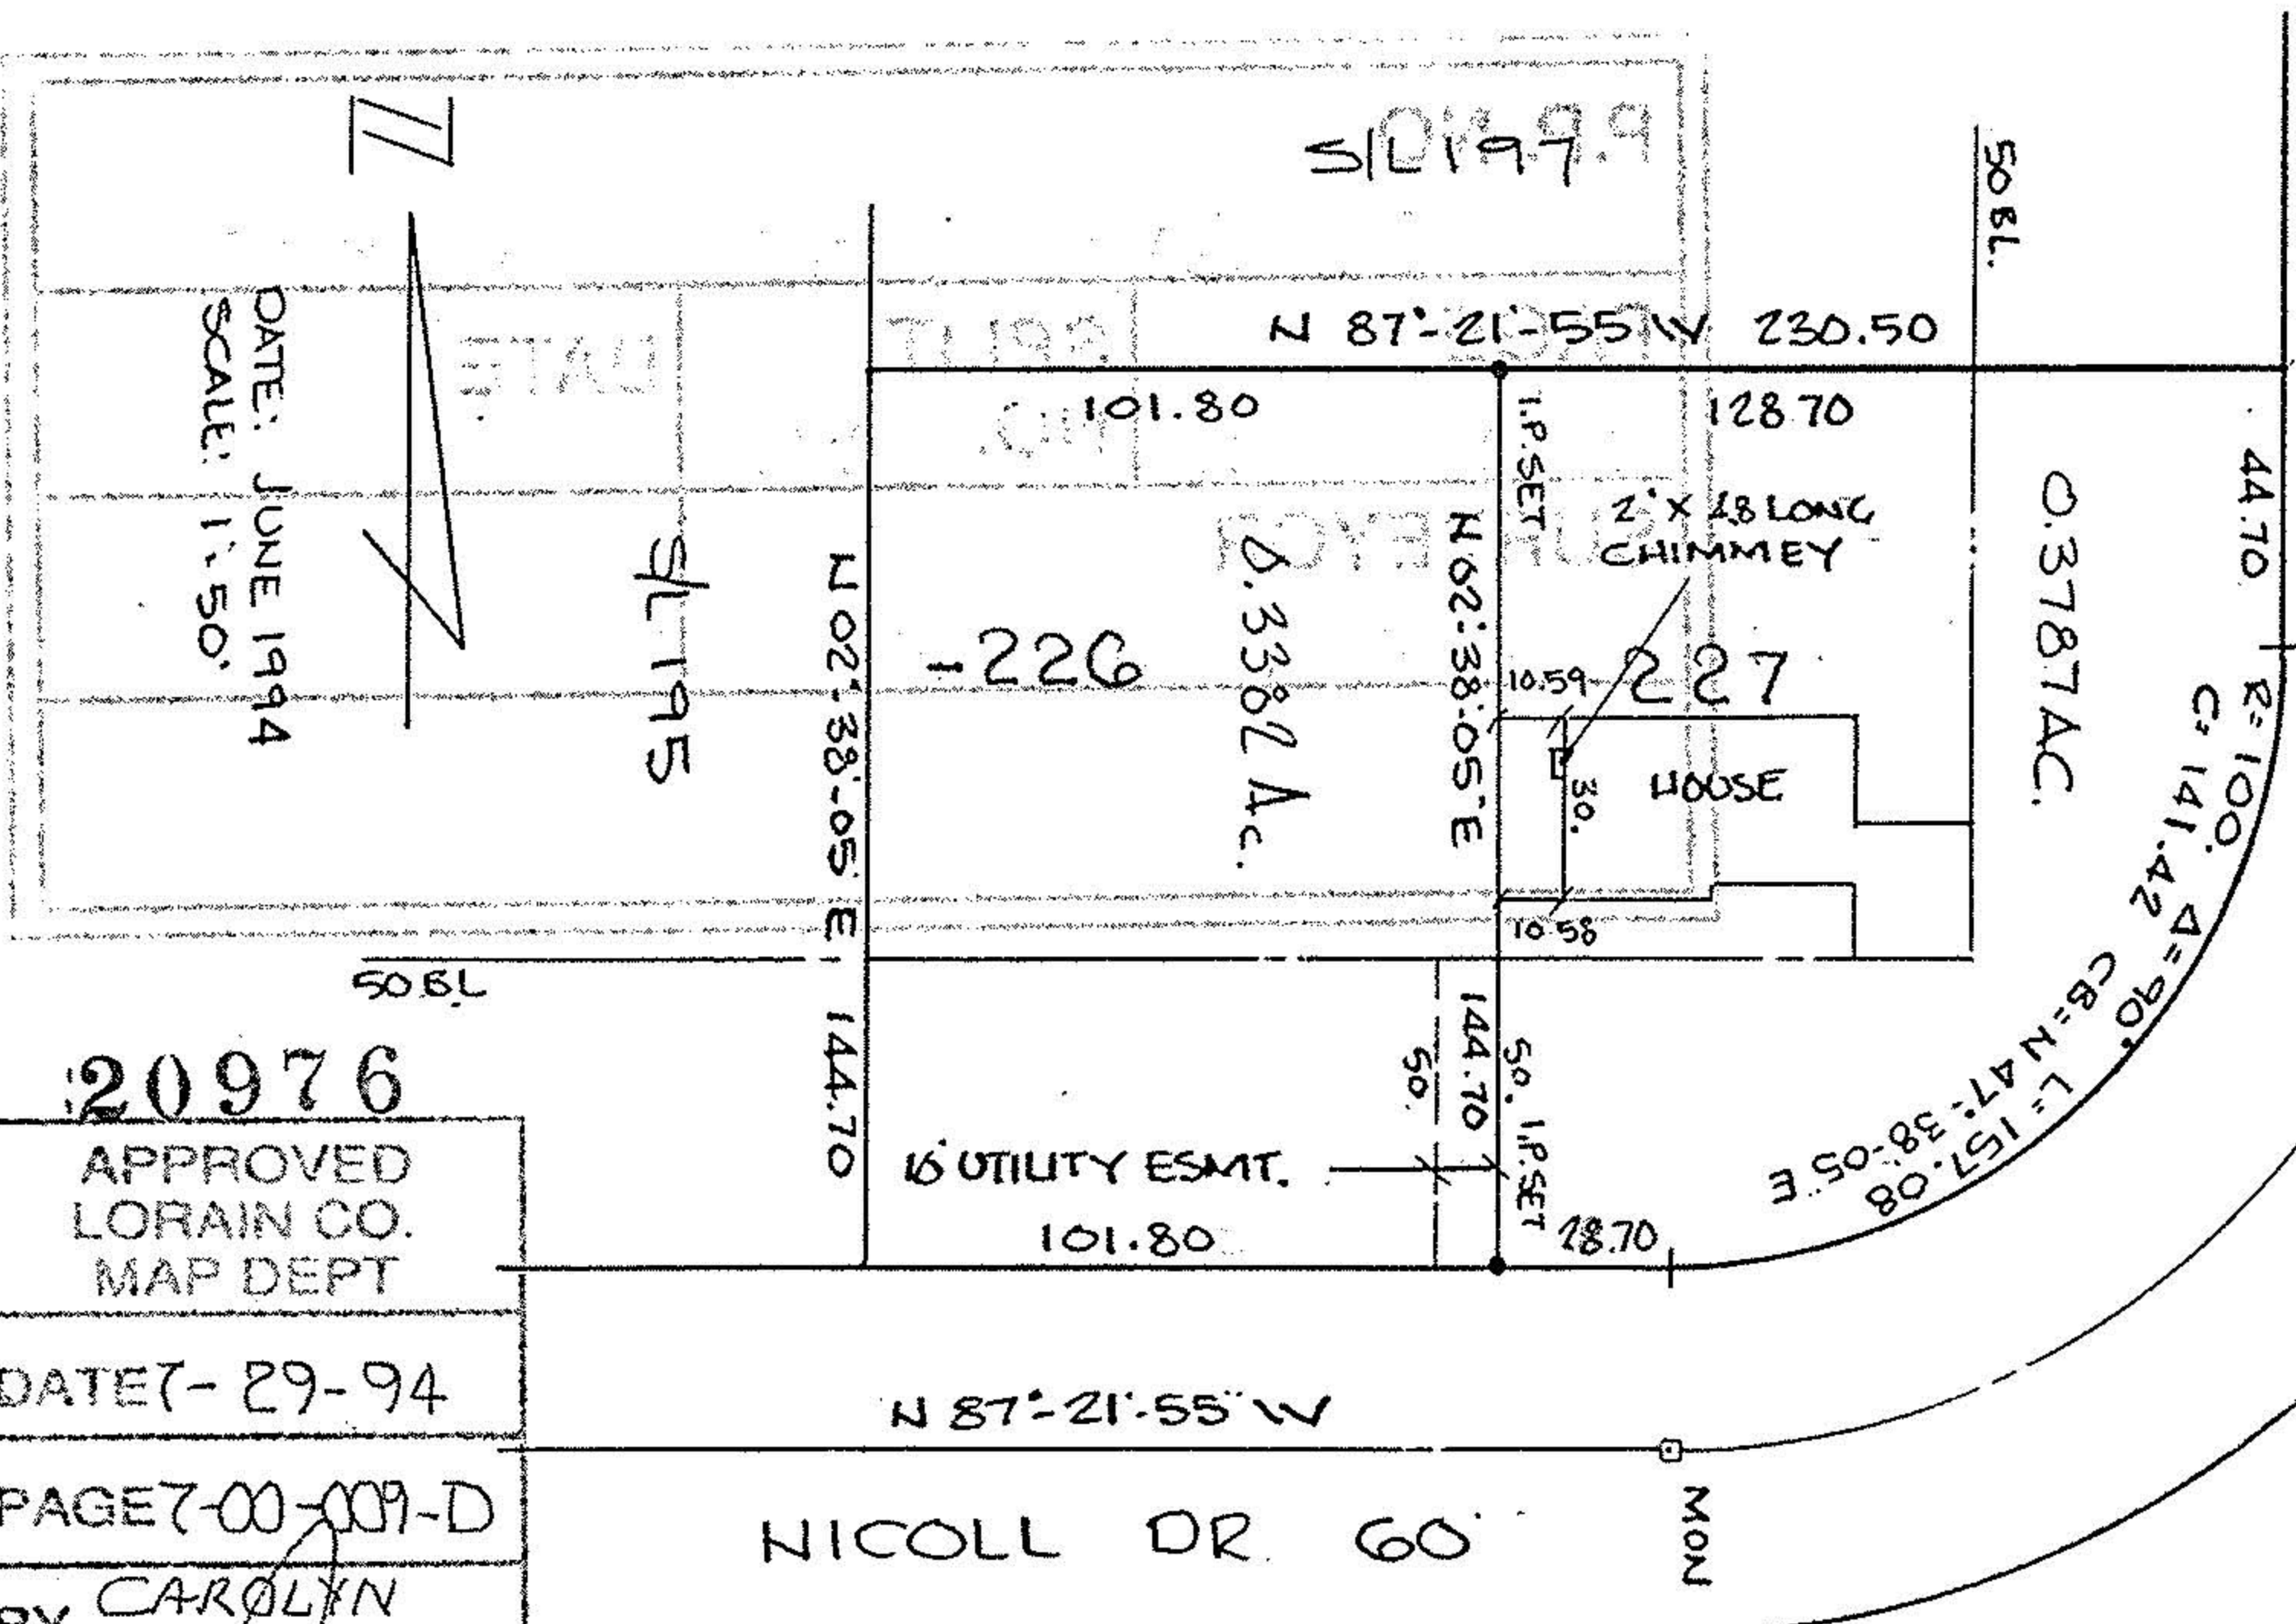

PREPARED FOR:
BRAD & MARY ELLEN
ANDREWS
6799 NICOLE DR.
N. RIDGEVILLE, OH


20976

APPROVED
LORAIN CO.
MAP DEPT

DATE 7-29-94

PAGE 7-00-009-D

BY CAROLYN
FRANLIS

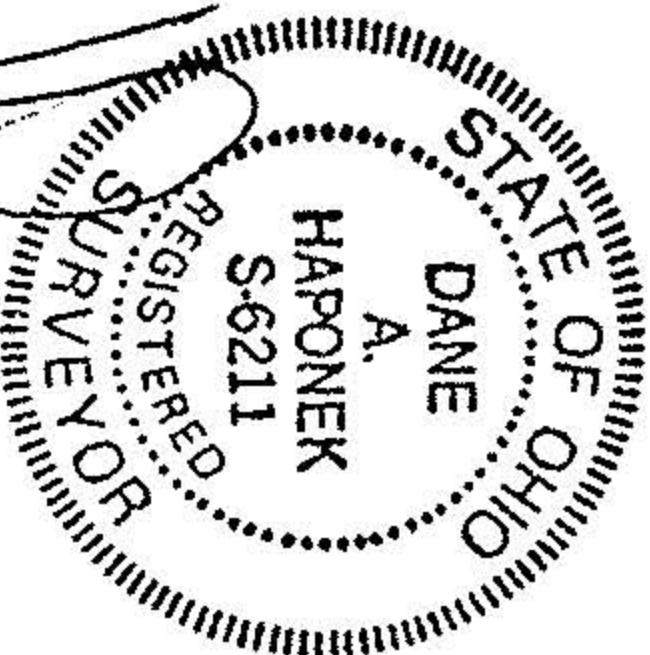

DATE: JUNE 1994
SCALE: 1"=50'