


MAP OF SURVEY MADE OF 2.7547 ACRES AND 2.7547 ACRES, PART OF ORIG. LOT NO. 6, TRACT NO.12, OF HENRIETTA TOWNSHIP, LORAIN COUNTY, OHIO
For James C. Born October 18, 2000.

Charles P. Waryu
Registered Surveyor No. 5029

Rev. 10/19/00 Added Church Parcel and Distances

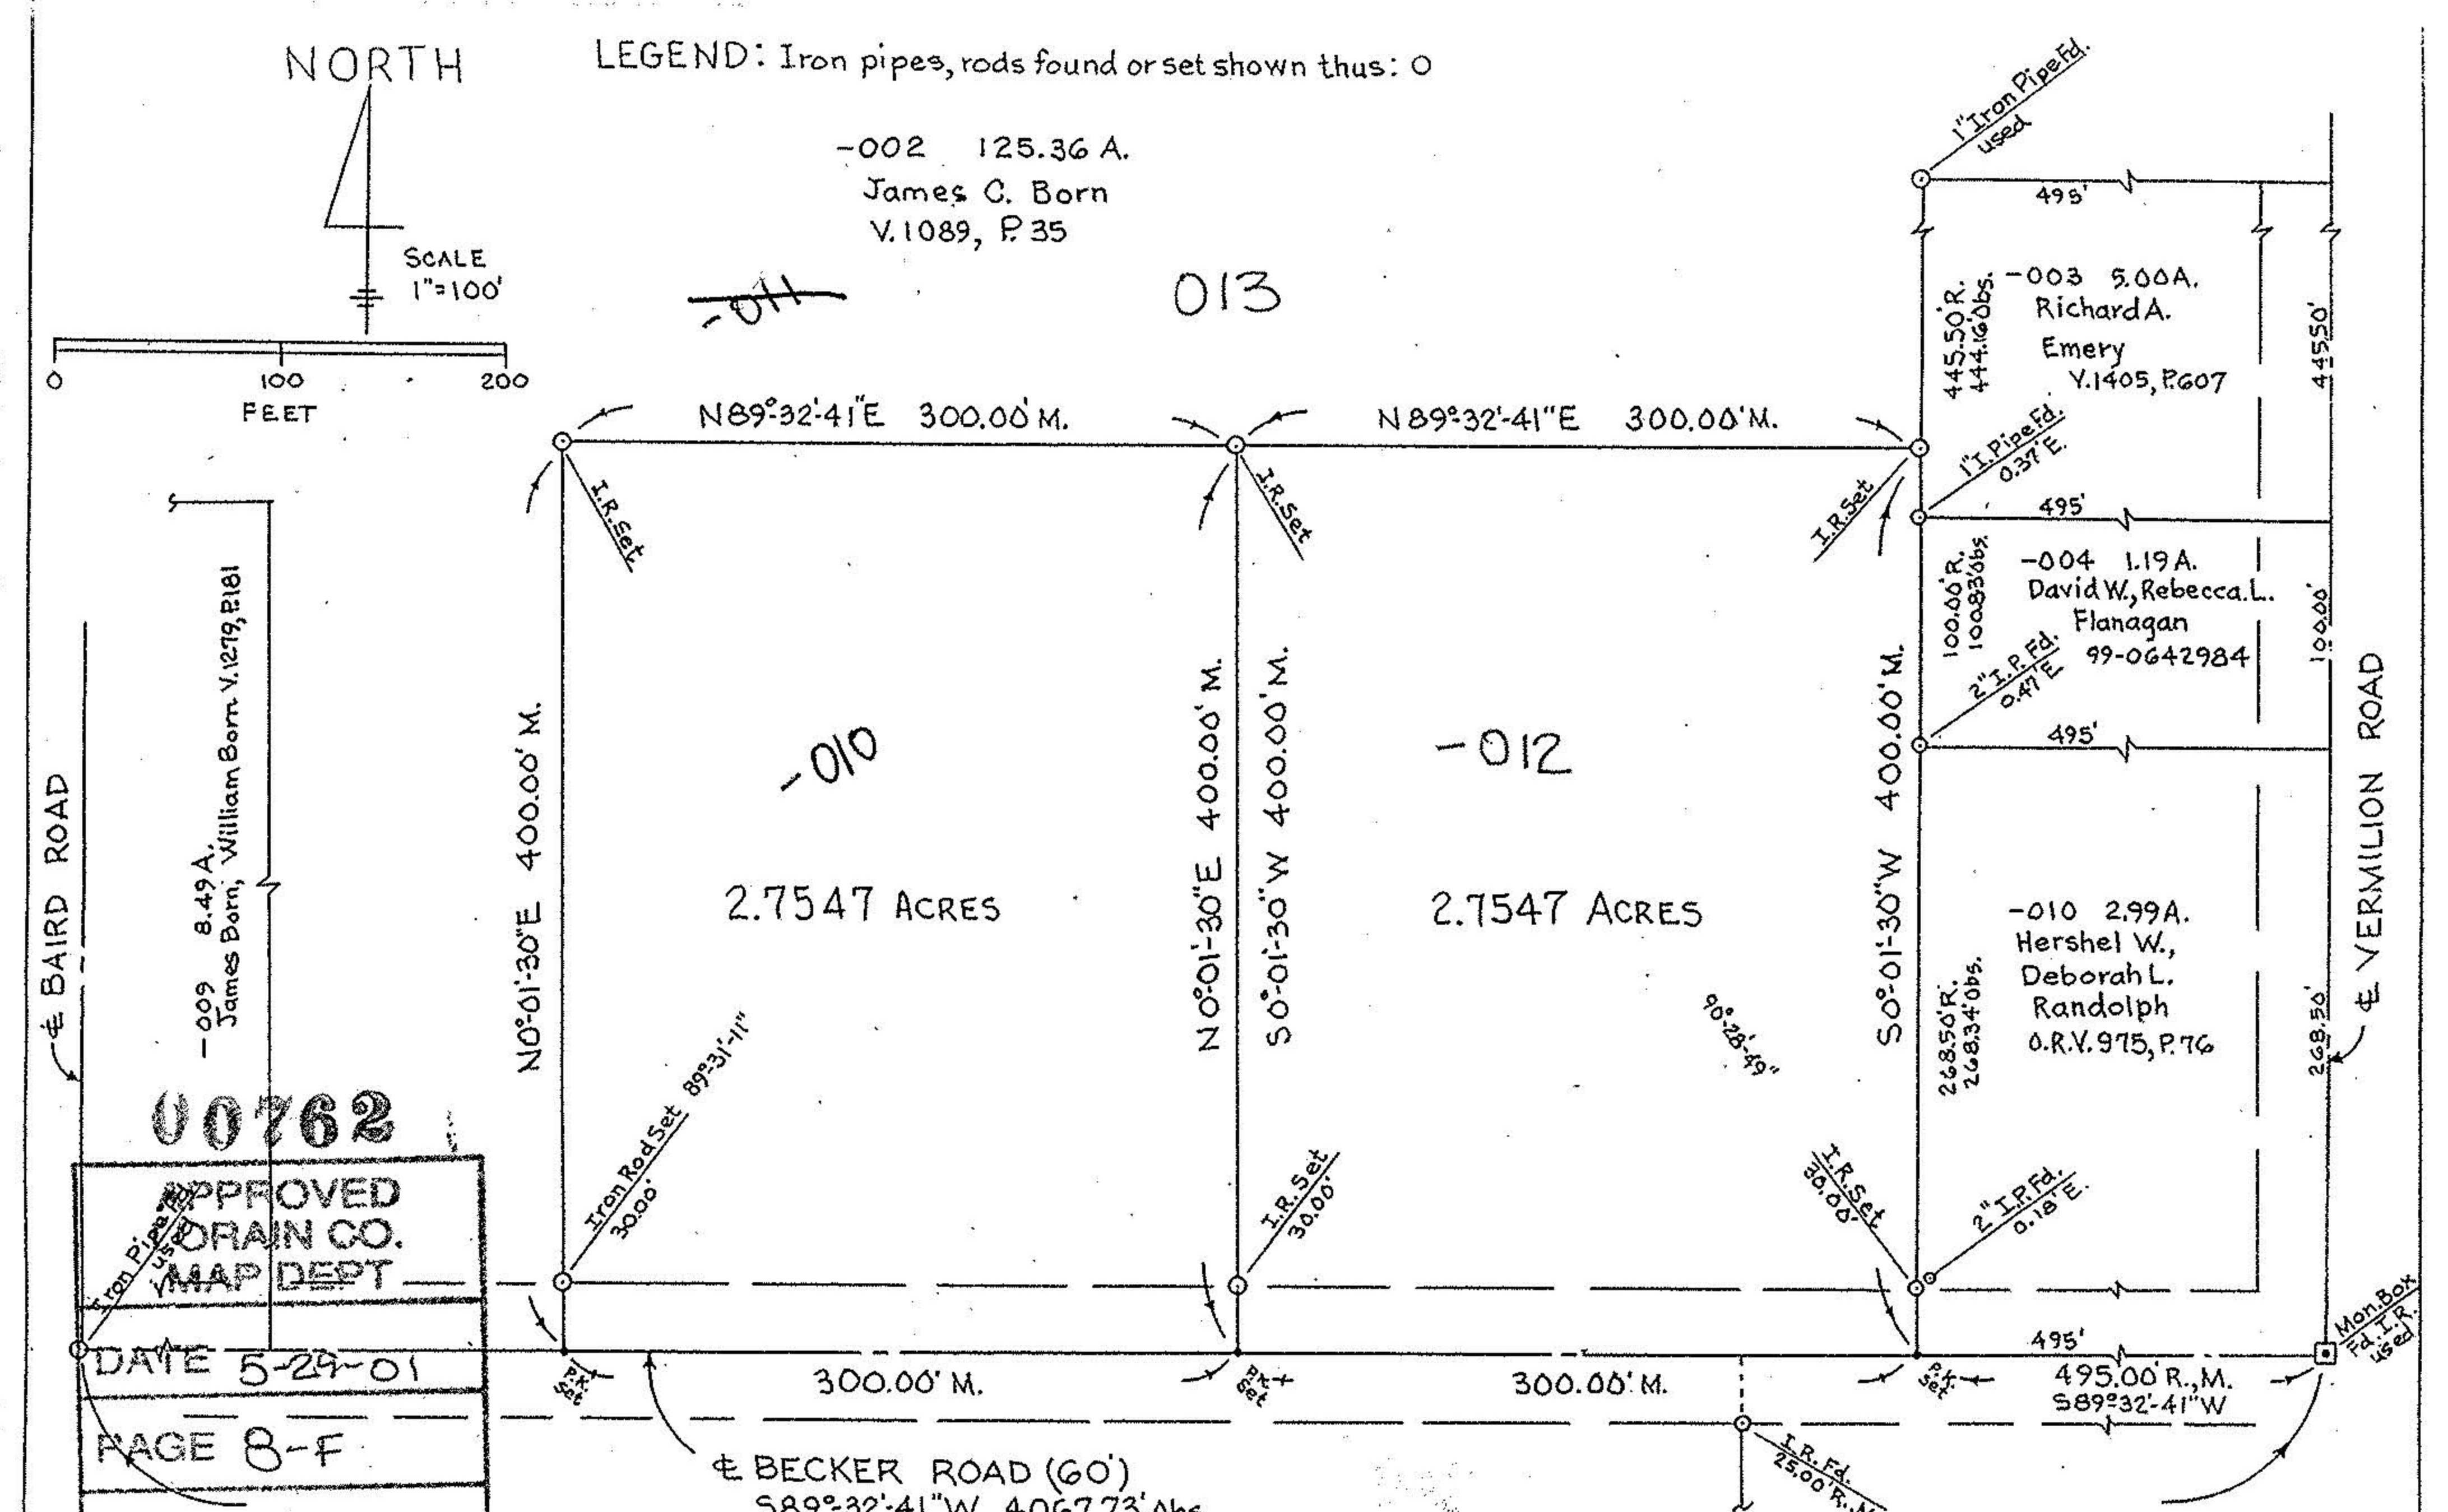

MAP OF SURVEY MADE OF 2.7547 ACRES AND 2.7547 ACRES, PART OF ORIG. LOT NO. 6, TRACT NO.12, OF HENRIETTA TOWNSHIP, LORAIN COUNTY, OHIO
For James C. Born October 18, 2000.

Charles P. Waryu
Registered Surveyor No. 5029