


08-12-017-000-

19746

8-G

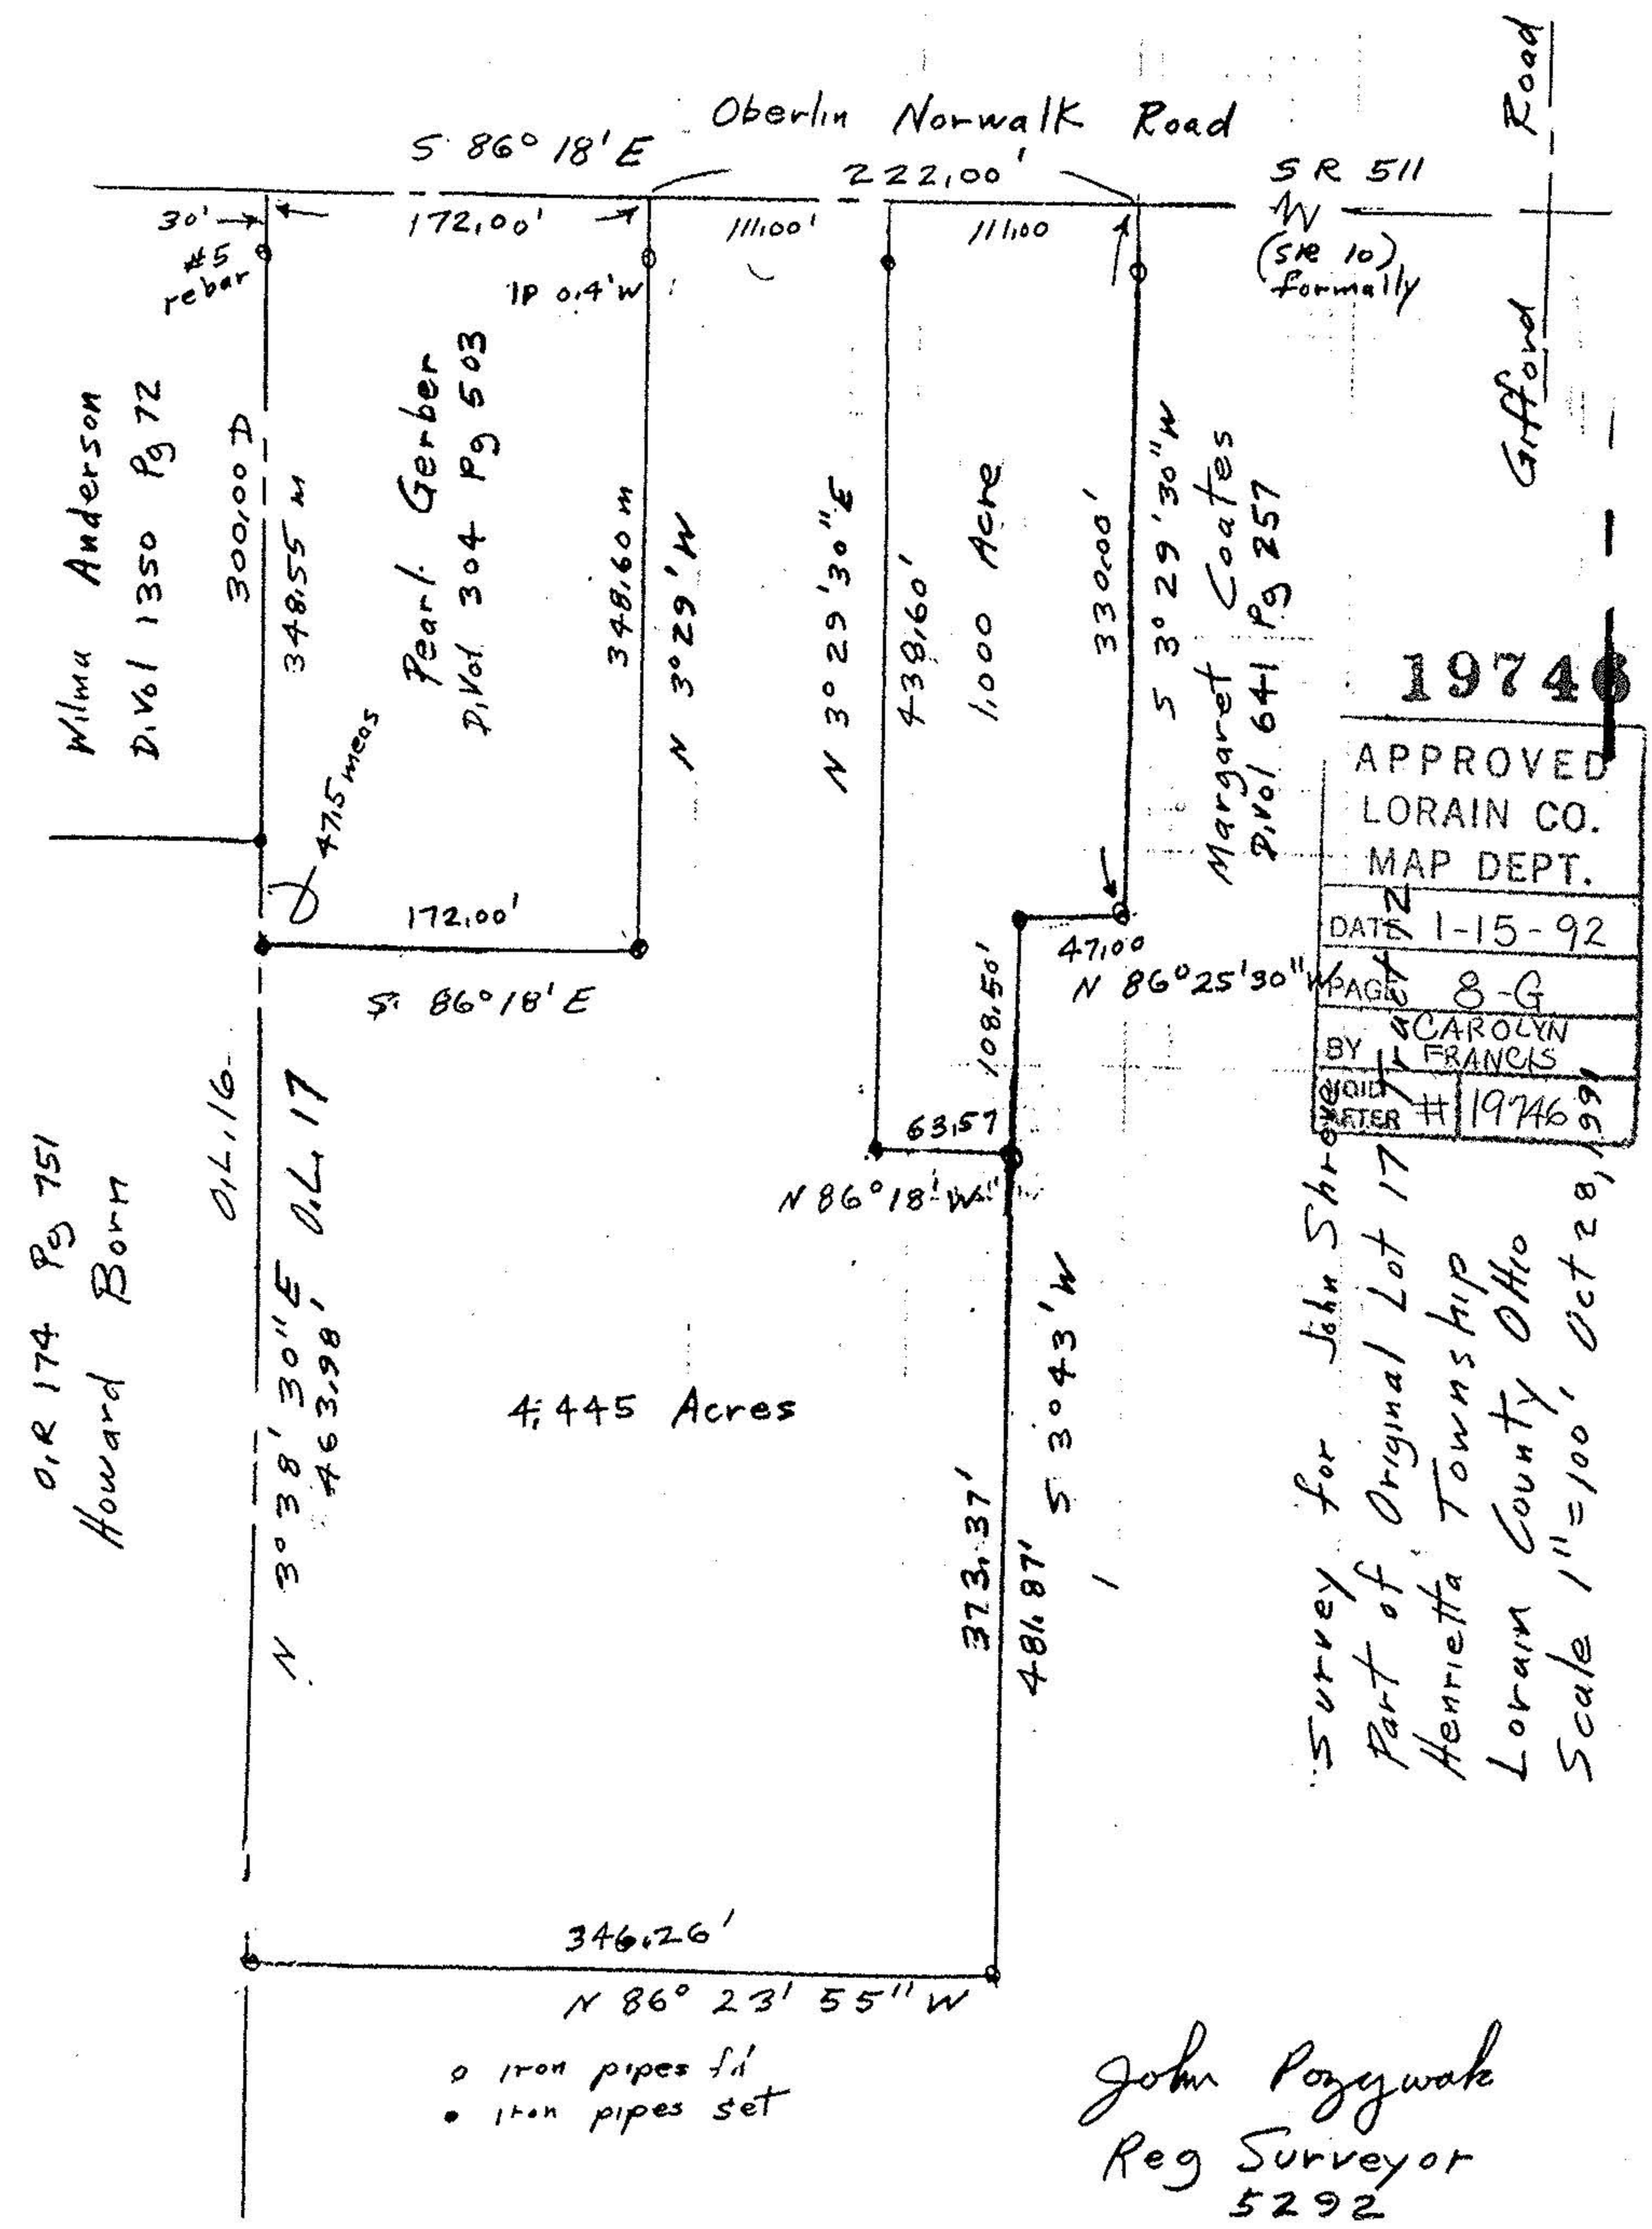

- o iron pipes set
- iron pipes set

John Pozywak
 Reg Surveyor
 5292

JOHN POZYWAK
 Registered Surveyor
 624 EASTERN HEIGHTS
 ELYRIA, OHIO 44035
 322-2456

2

Being part of Original Lot 17, Tract 12 of Henrietta Township, bounded and described as follows;

Beginning at the point of intersection of the West line of Original Lot 17 and the centerline of Oberlin-Norwalk Road, aka SR 511 (formally SR 10);

Thence South 86° 18' East along the centerline of Oberlin-Norwalk Road a distance of 283.00 ft to the principal place of beginning;

Thence continuing South 86° 18' East along said centerline a distance of 111.00 ft to a nail found;;

Thence South 3° 29' 30" West along the West line of land conveyed to Margaret Coates by Deed Volume 641, page 257 of Lorain County Record of Deeds a distance of 330.00 ft to an iron pipe found and passing thru an iron pipe found 29.95 ft from centerline and 8 inches deep;

Thence North 86° 25' 30" West along the North line of land so conveyed to Margaret Coates a distance of 47.00 ft to an iron pipe found;

Thence South 3° 43' West along the Westerly line of land so conveyed as aforesaid a distance of 108.50 ft to the South edge of an iron pipe found;

Thence North 86° 18' West a distance of 63.57 ft to an iron pipe set;

Thence North 3° 29' 30" East a distance of 438.60 ft to the principal place of beginning;

Containing within said bounds 1.000 acres of land be the same more or less and subject to all legal highways and easements of record;

19746 08-12-017-000-032

8-G