



- Legend:
- ⊙ I.P. Found
 - 1/2 inch diameter x 30" iron bar set
 - ▲ Spike found
 - Monument box found

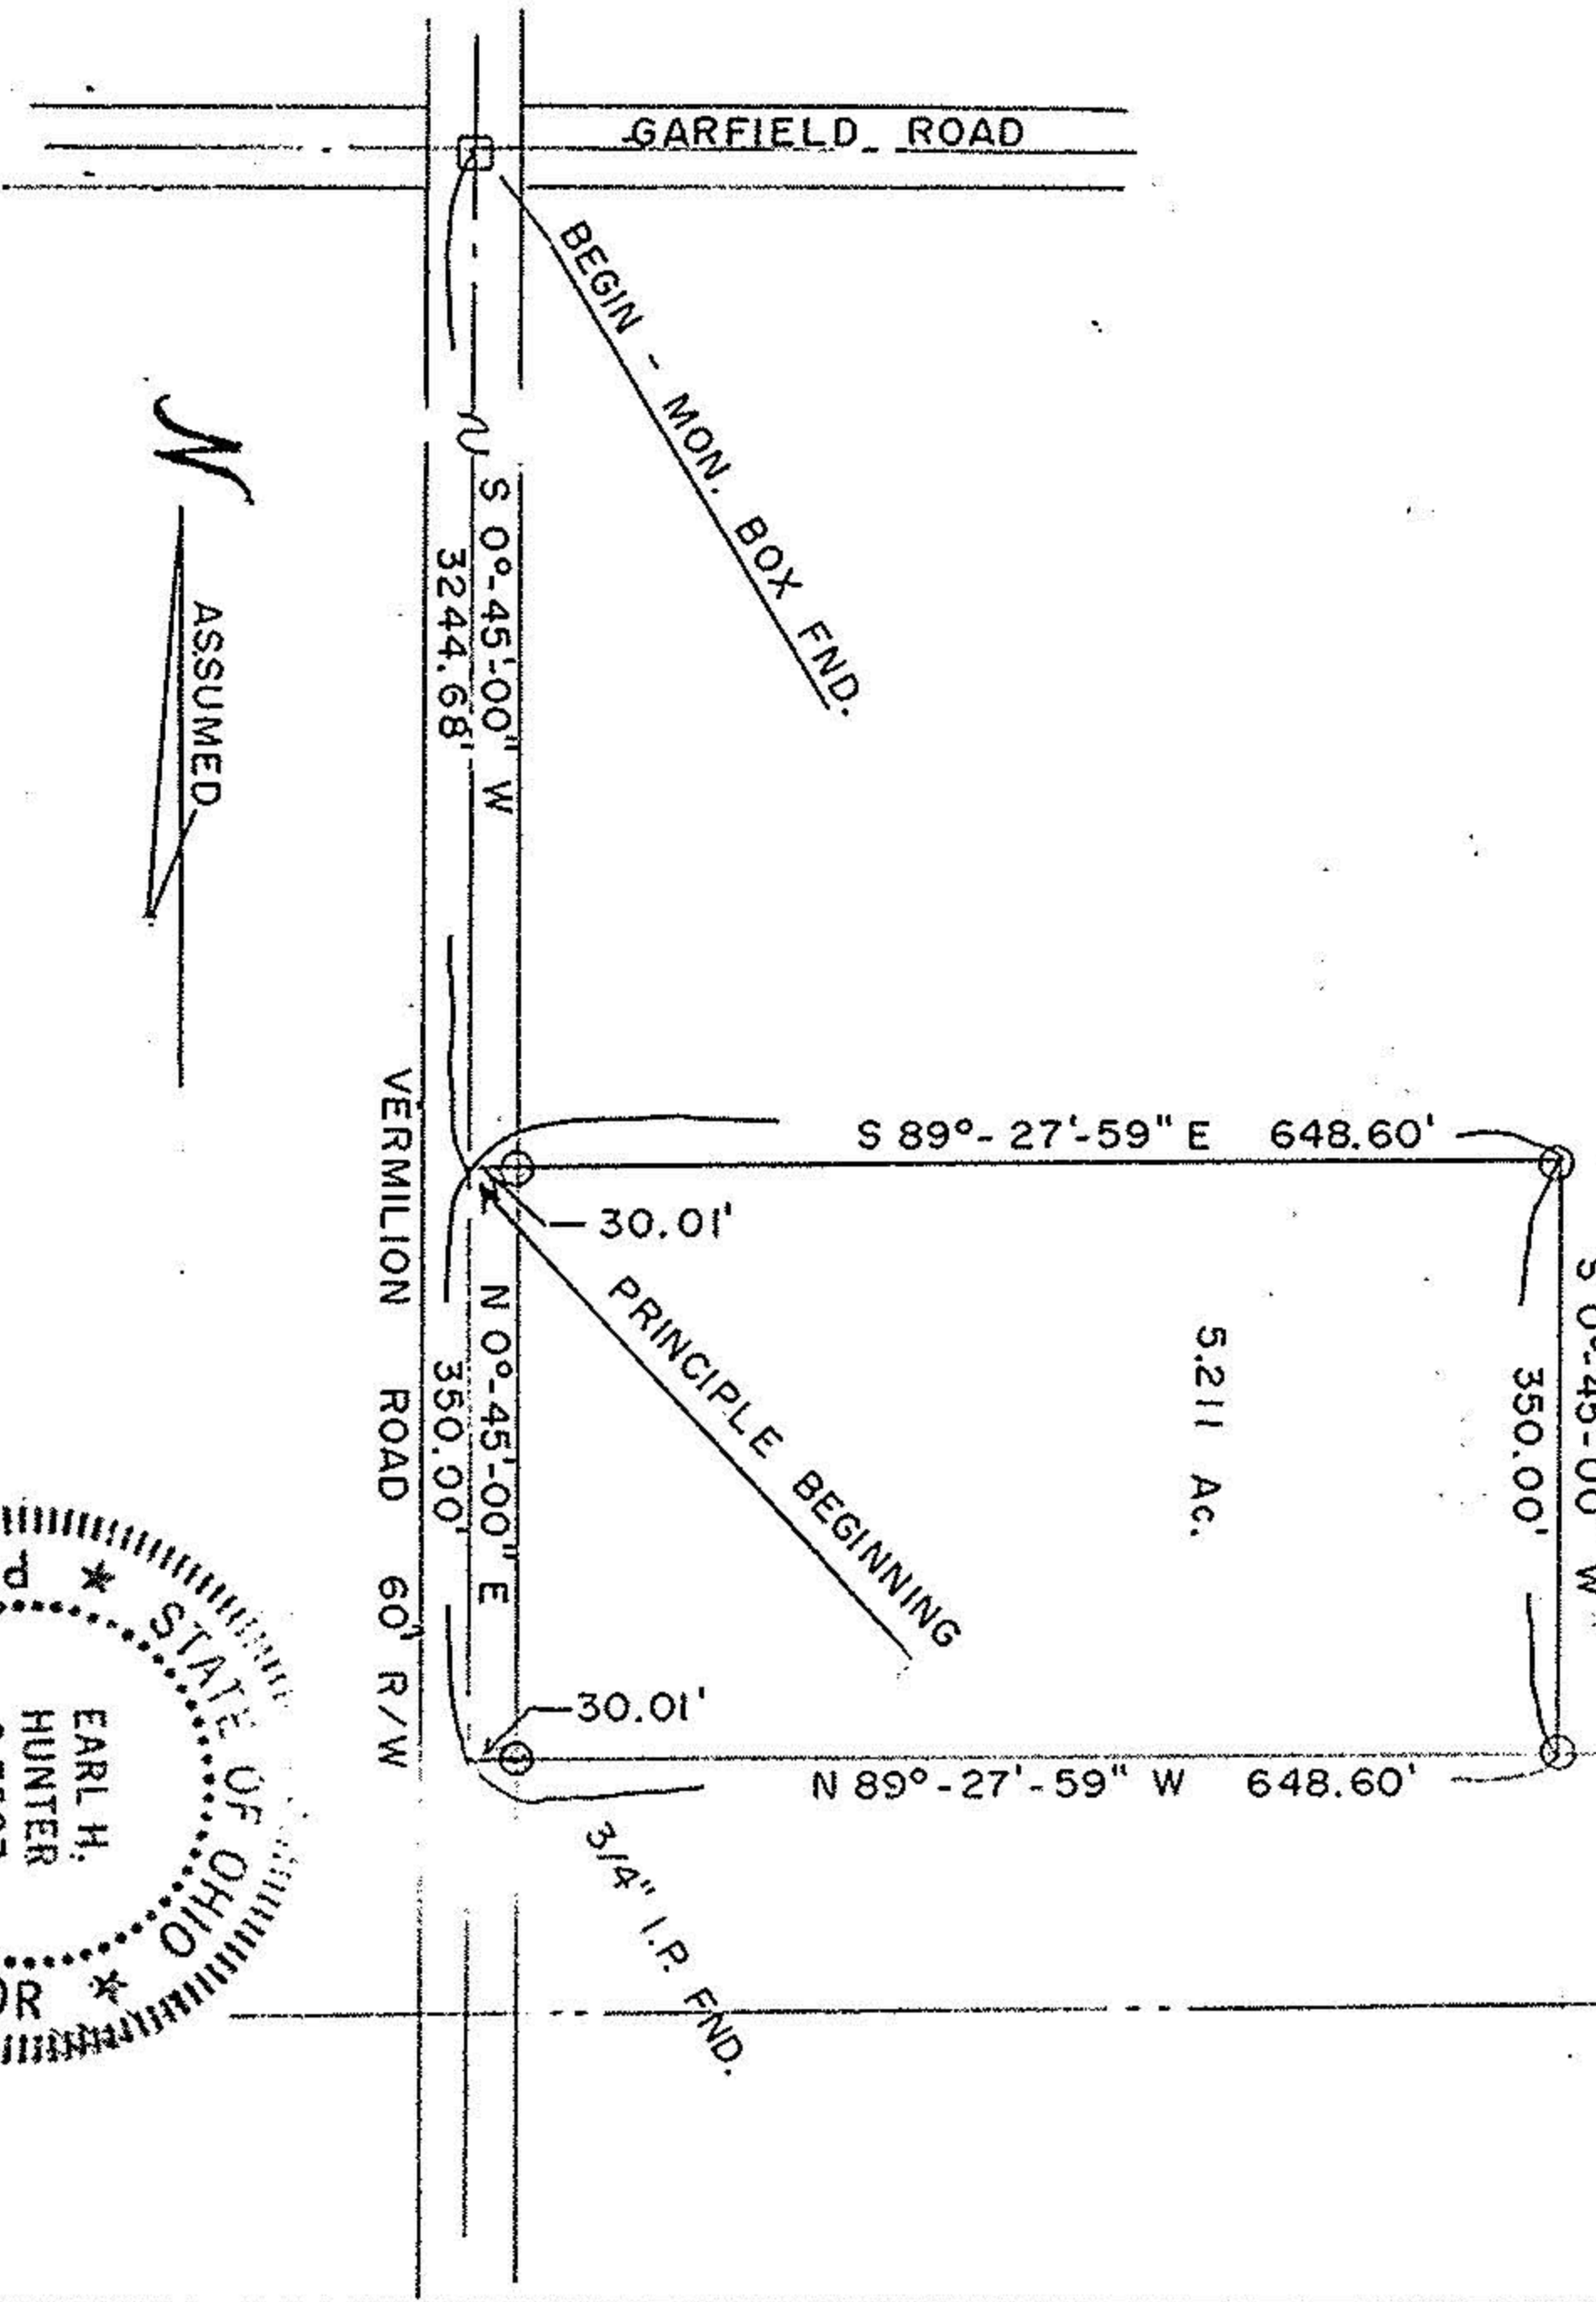

JACK KASPER
D.V. 1384 PG. 749
08-13-008-006-006

HOWARD BORN
O.R. 61 PG. 745

08-13-008-006'-004
O.L. 6
O.L. 15
08-13-008-015-001

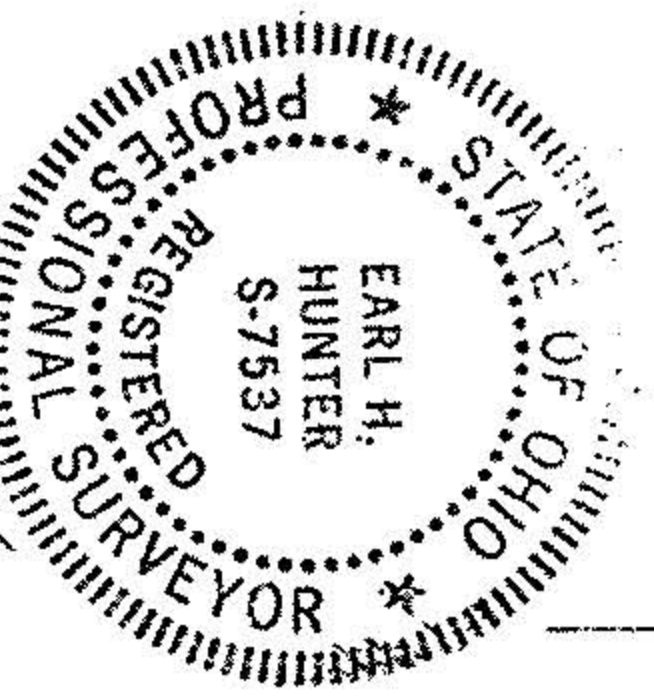

Earl H. Hunter
Supt. 9, 1994

PLAT OF SURVEY

**FOR
MR. JACK KASPER**

Being part of Tract 13,
Original Lot 6,
Henrietta Township,
Lorain County, Ohio



All bearings are to an assumed meridian.

EC. 1 in 10,000 +
Earl H. Hunter, P.S.
1503 Sanford Street
Vermilion, Ohio 44089
(216) 967-2037