



#22466

APPROVED LORAIN CO. MAP DEPT
DATE 3/16/98
PAGE 8-F
BY K. COLBERT

OR 39 Pg 857  
 Glenn E & Kathryn M  
 Gerstacker  
 OLA  
 M

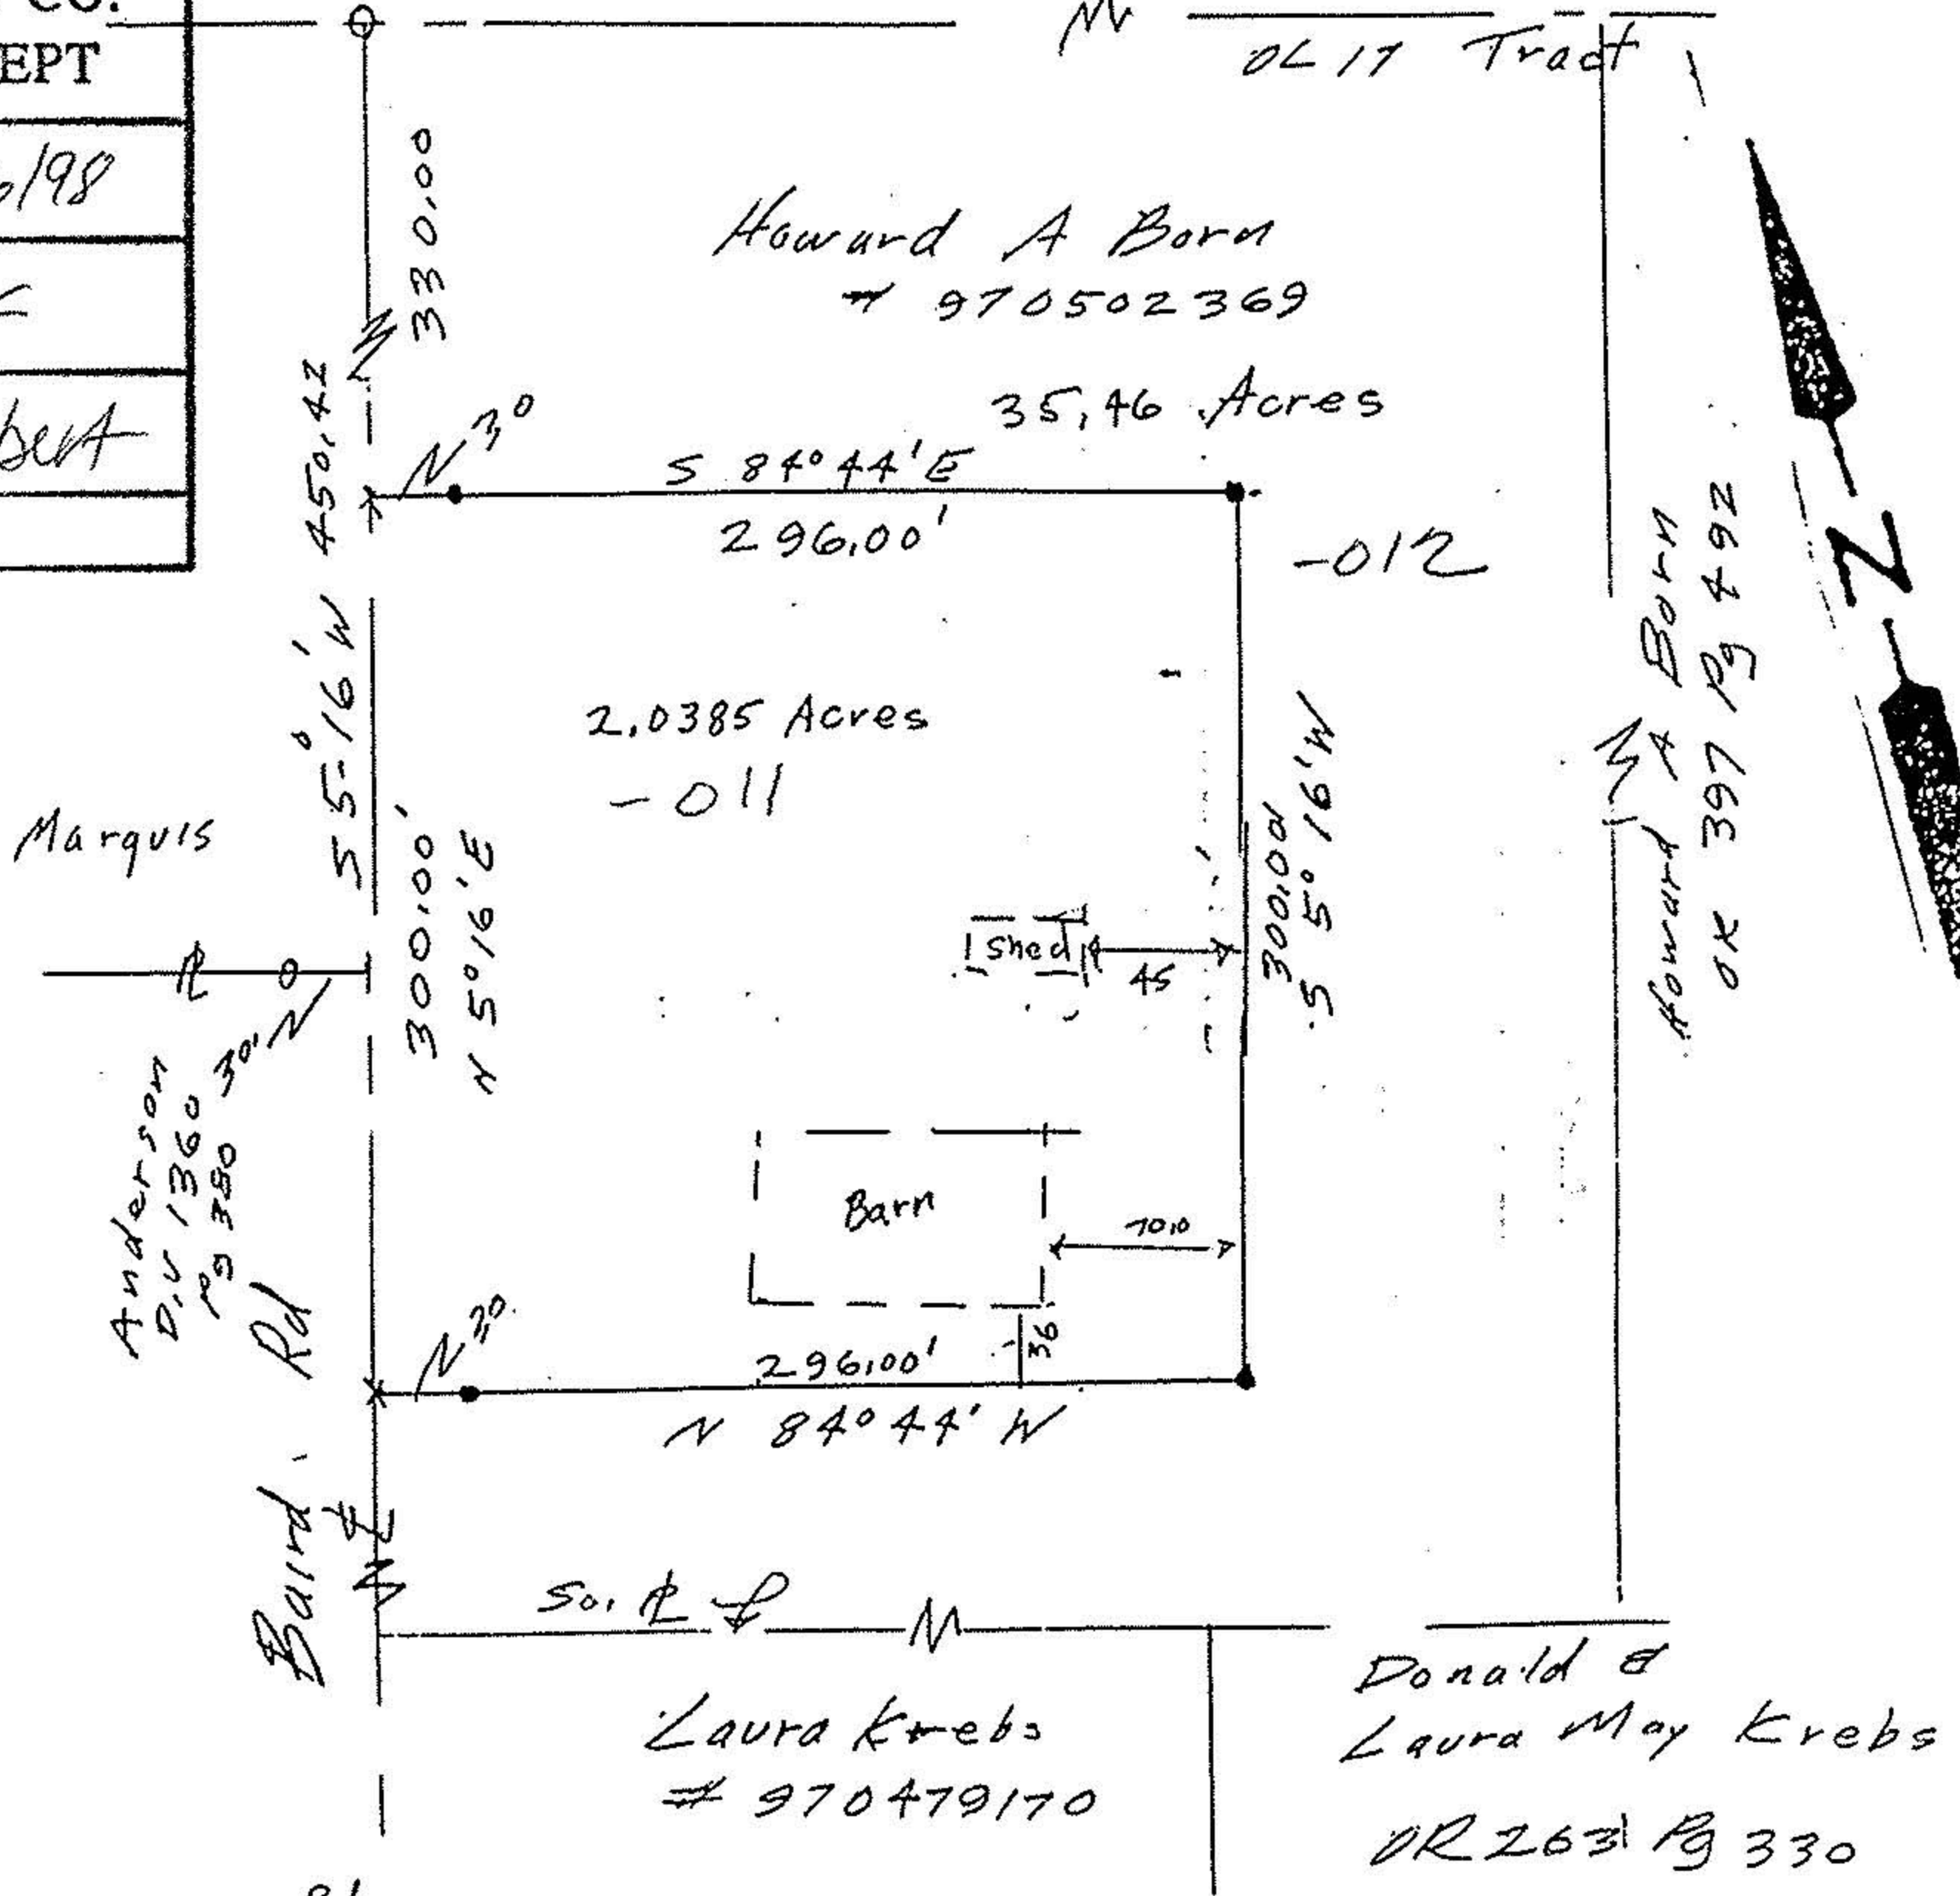

- o iron pins fd
- iron pins set
- x PK nail set

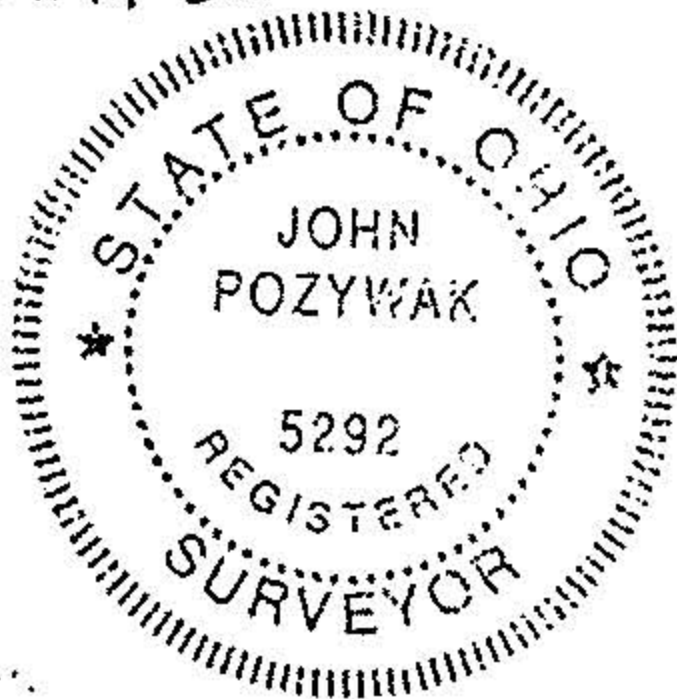

Survey for Howard Born  
 Original Lot 17 Tract 13  
 Henrietta Township  
 Lorain County, Ohio  
 Scale 1" = 100' January 1998

John Pozywak  
 Reg Surveyor 5292